


T. 28 S., R. 1 E

CORNERS RENEWED BY
 BUREAU OF LAND MANAGEMENT-----◆
 COUNTY SURVEYOR'S OFFICE-----⊙
 PRIVATE SURVEYORS-----○
 CORNERS FOUND AND USED-----■
 CORNERS LOOKED FOR AND NOT FOUND-----●

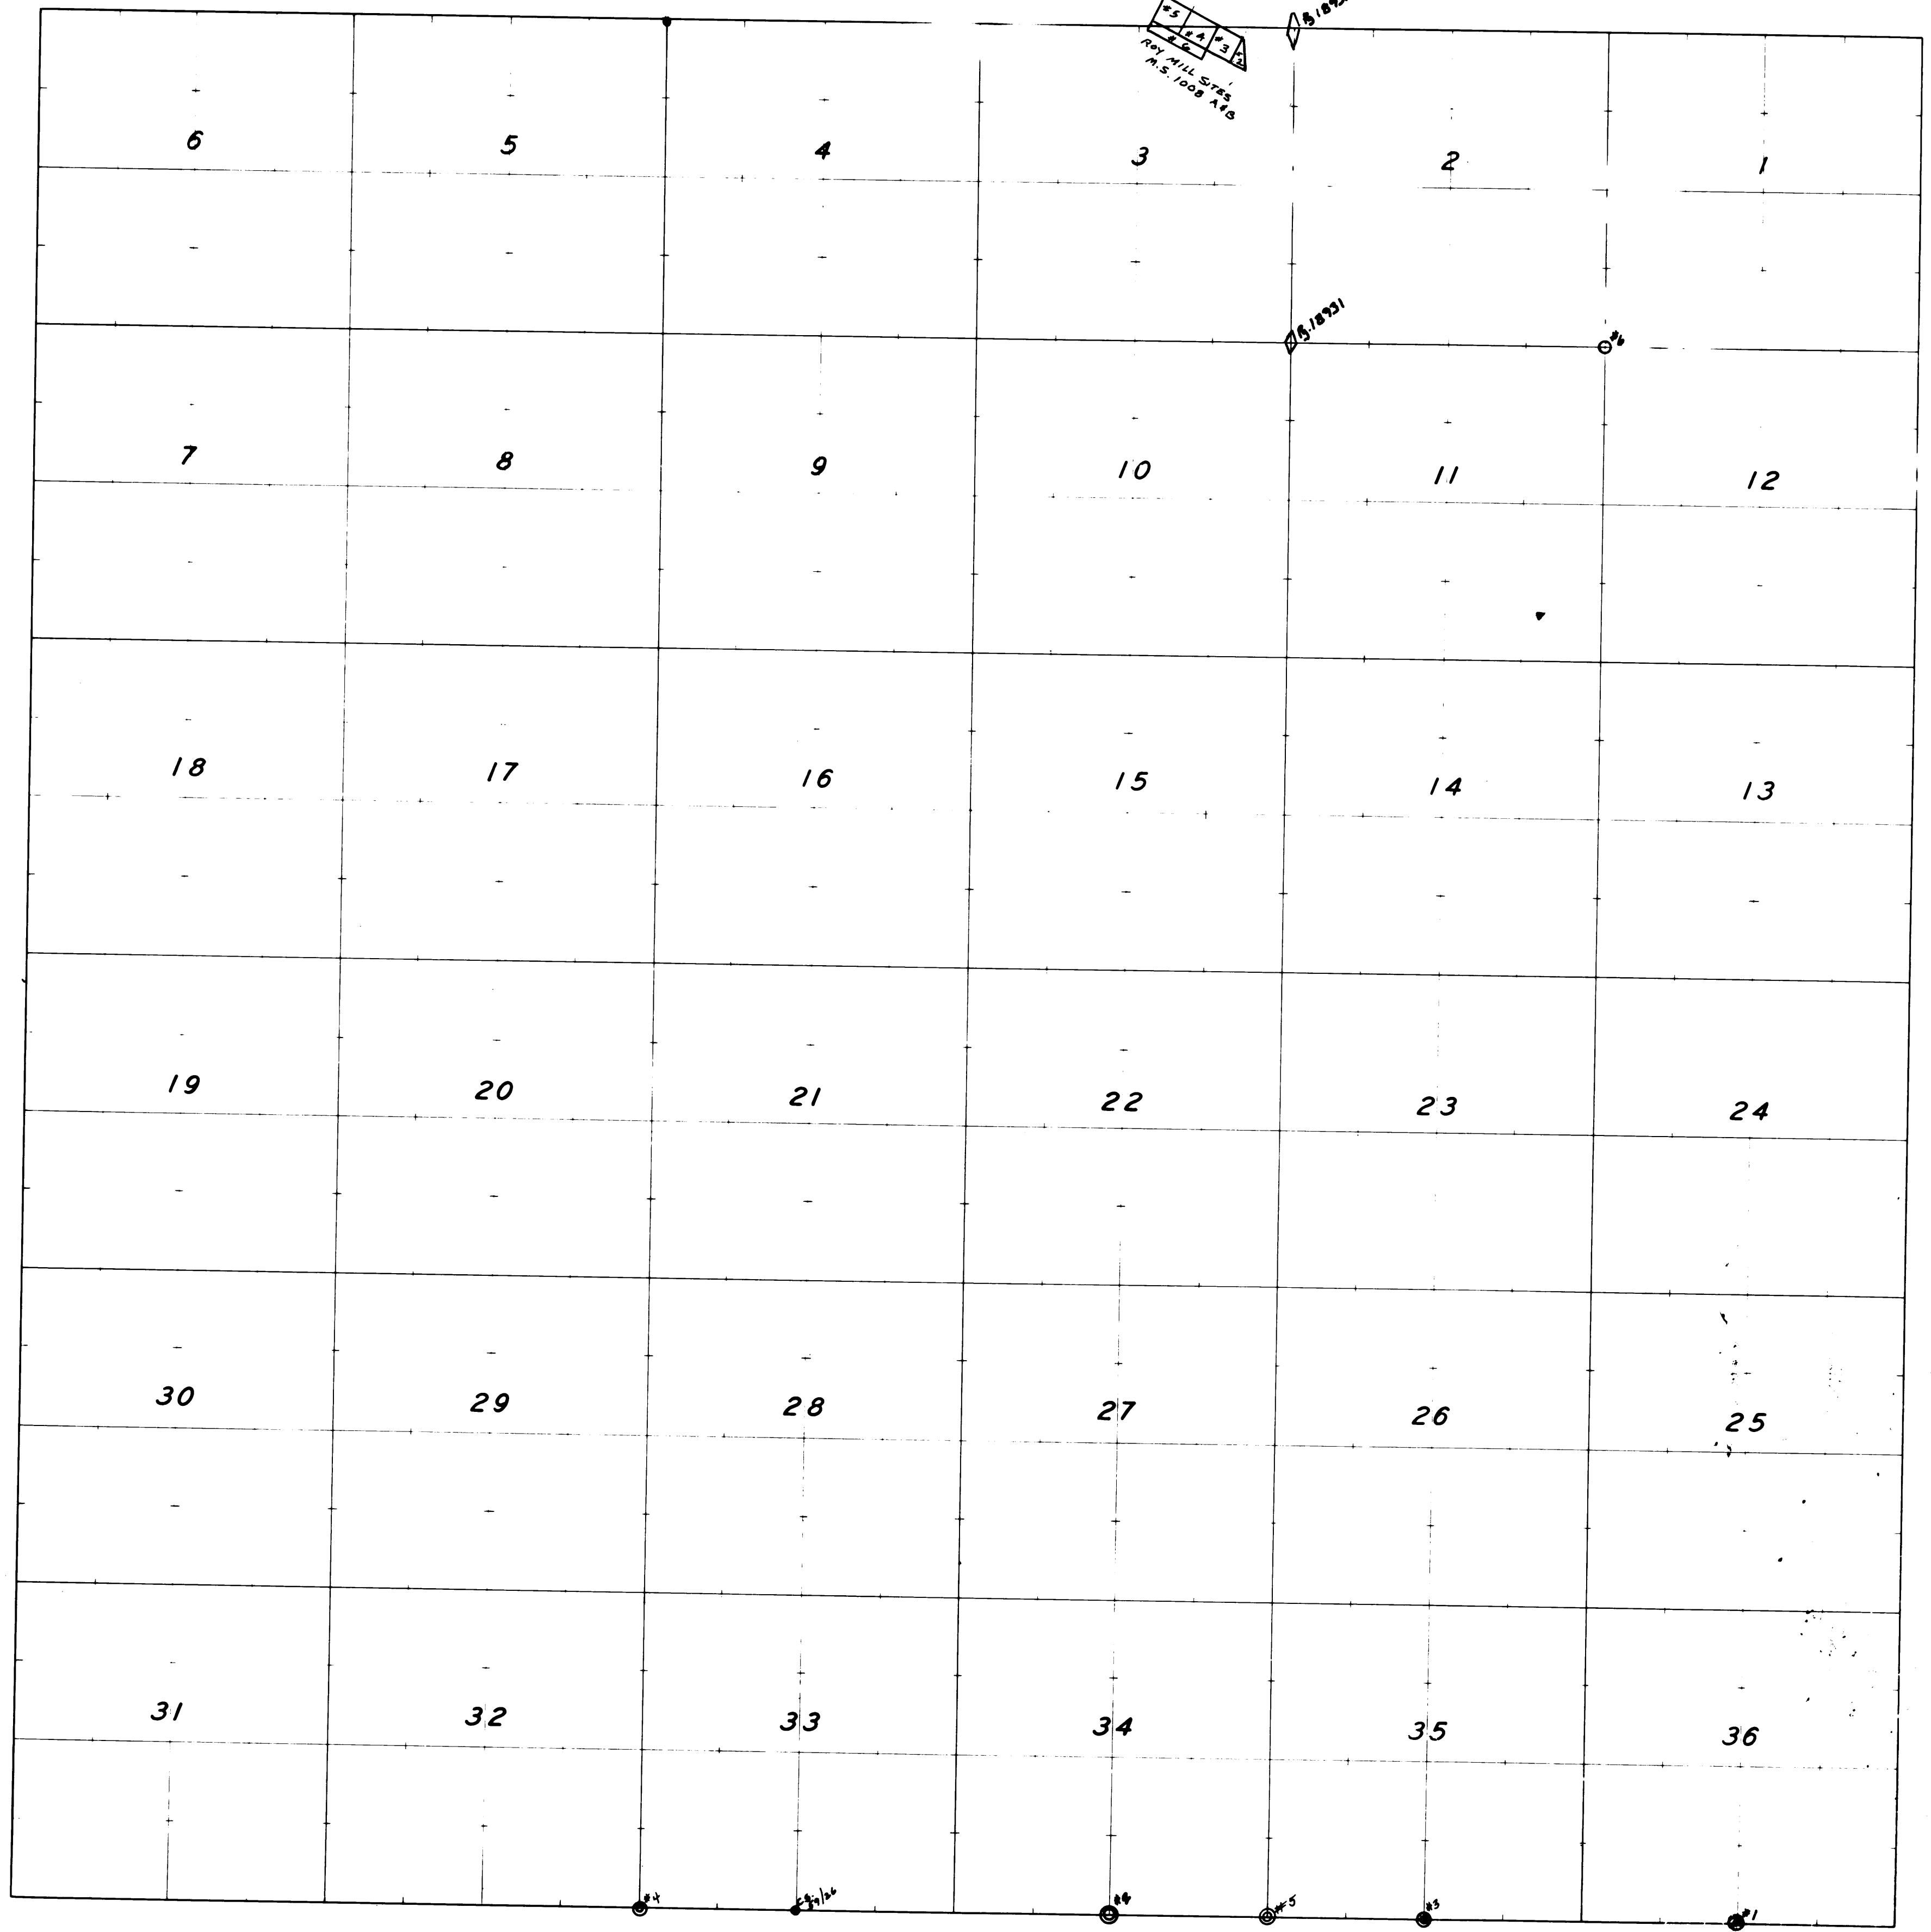

18922
 18921
 Key Mill Stes
 M.S. 1008 1815