


T. 19 S., R. 10 W.

CORNERS RENEWED BY  
 BUREAU OF LAND MANAGEMENT ---◆---  
 COUNTY SURVEYOR'S OFFICE ---○---  
 PRIVATE SURVEYORS ---●---  
 CORNERS FOUND AND USED ---■---  
 CORNERS LOOKED FOR AND NOT FOUND ---○---


.047

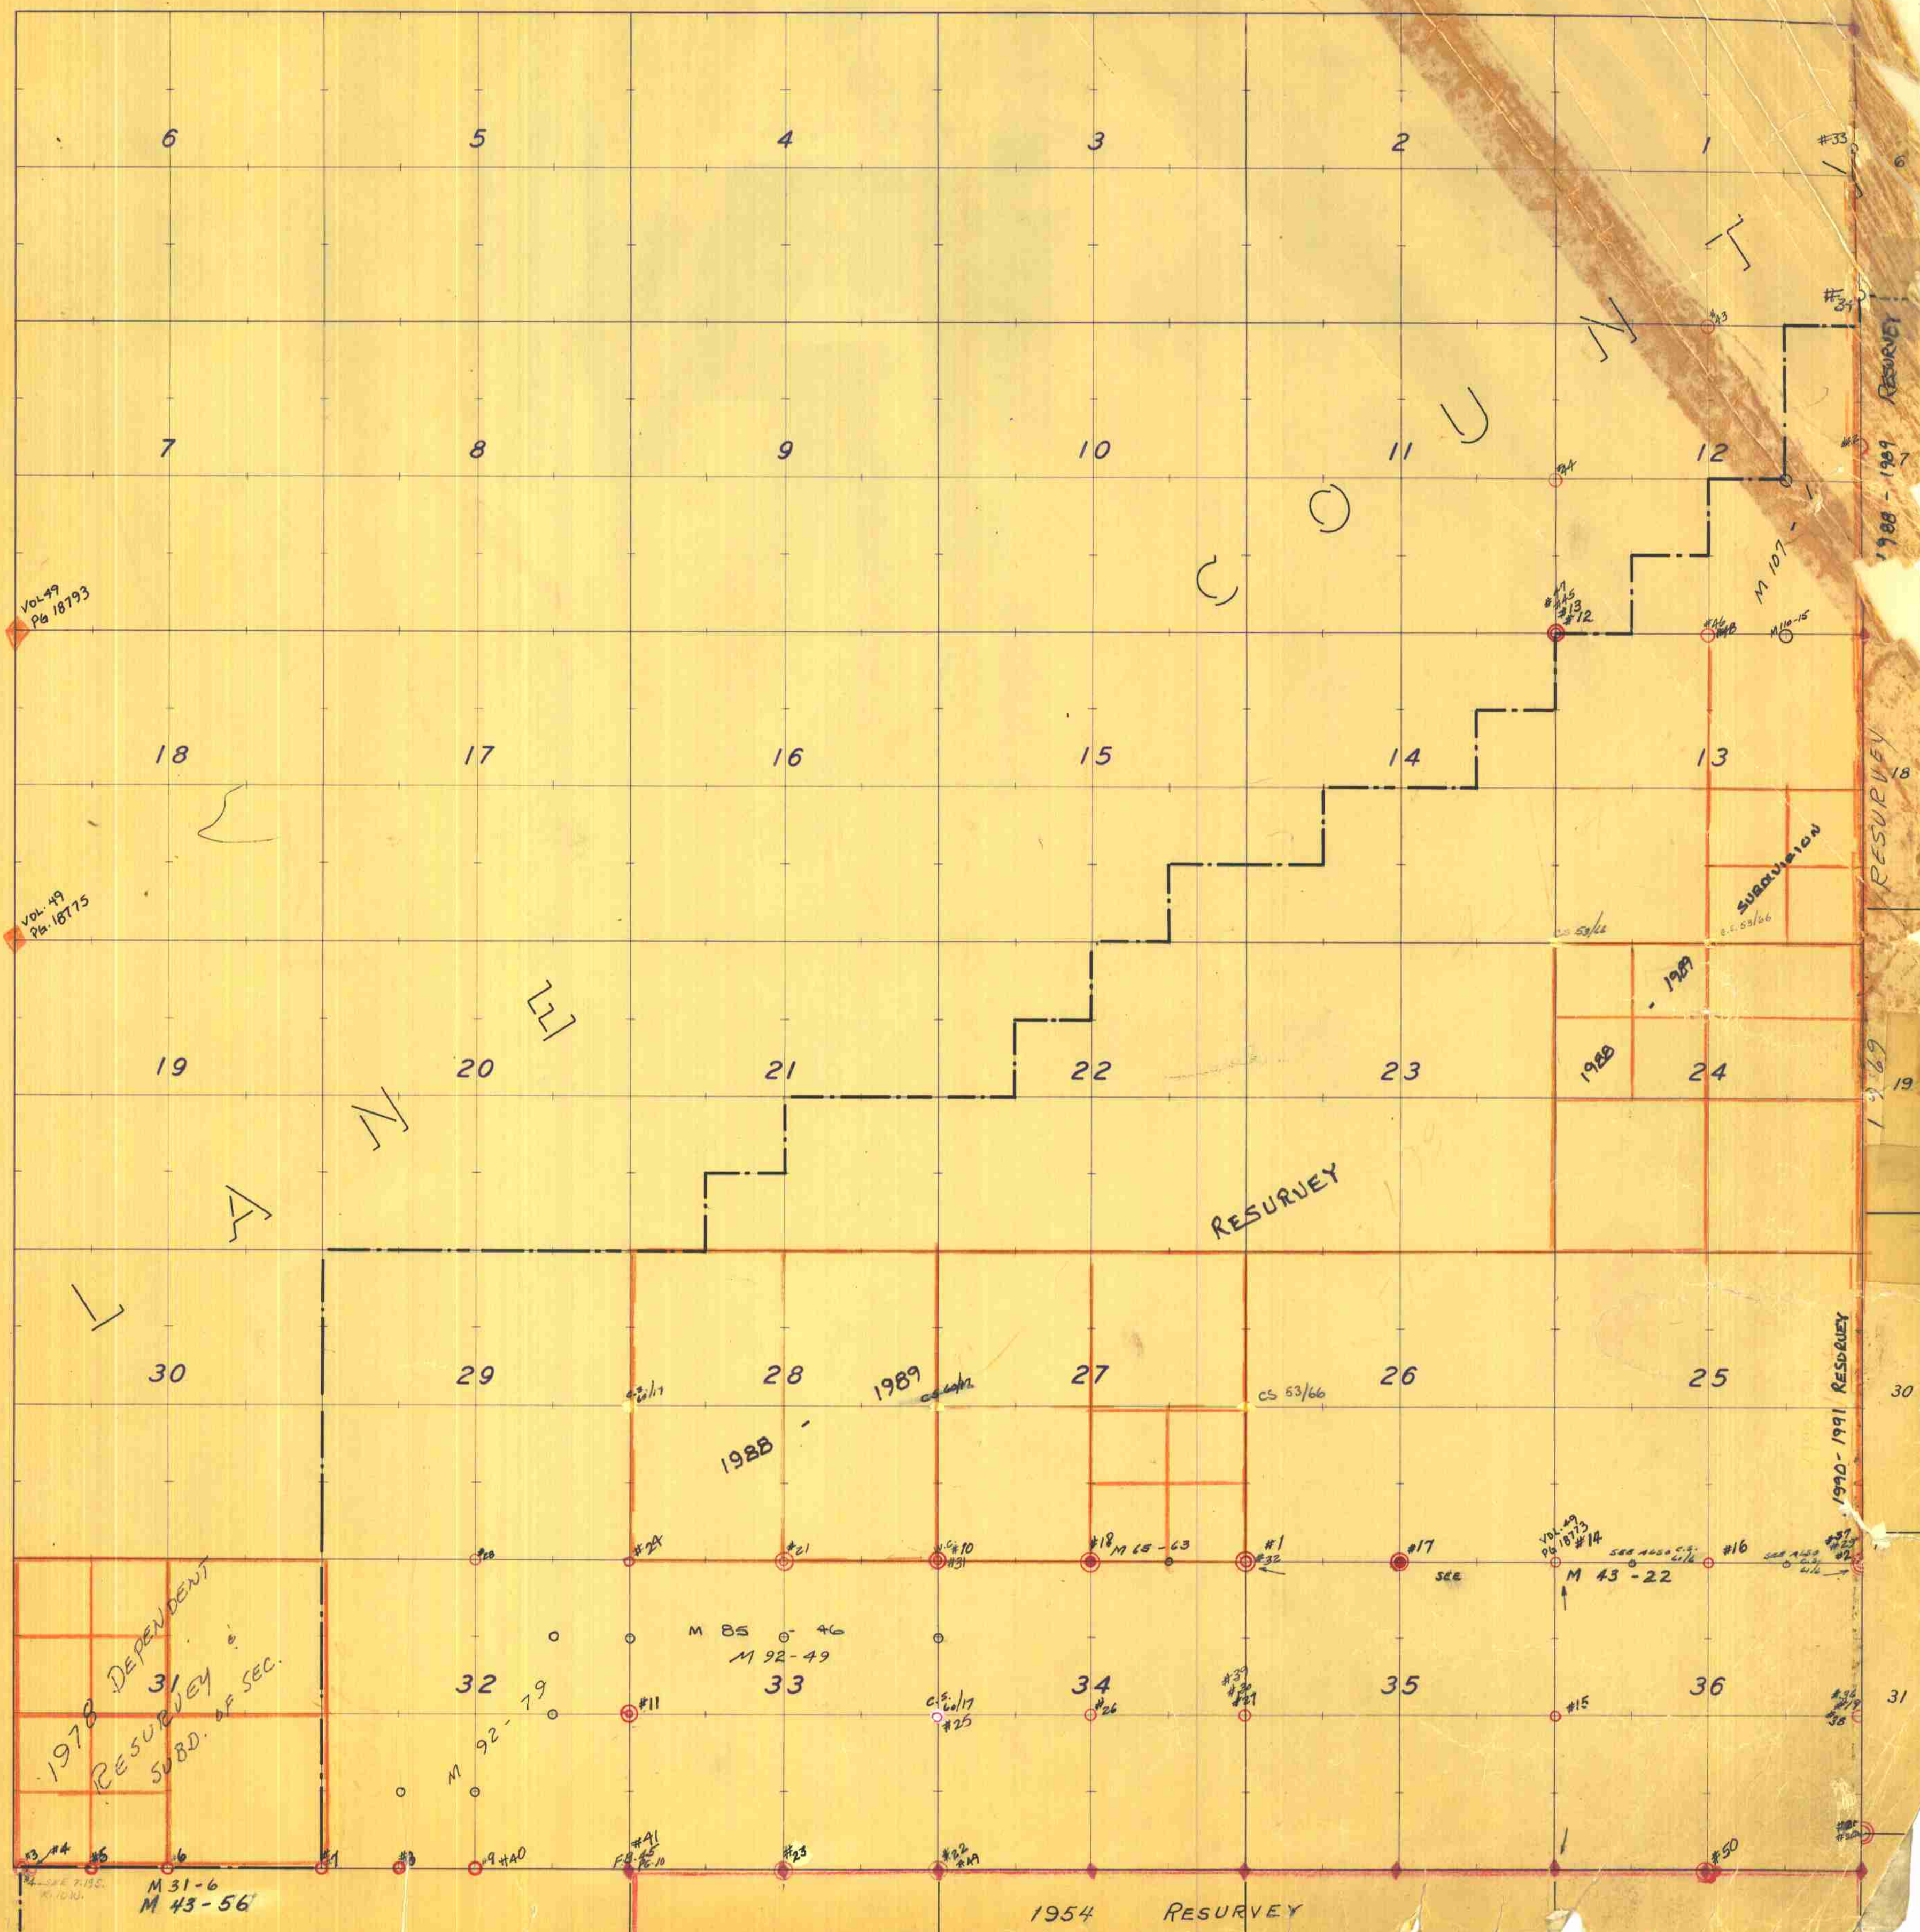

3

T. 19 S., R. 10 W.

CORNERS RENEWED BY  
 BUREAU OF LAND MANAGEMENT -----●-----  
 COUNTY SURVEYOR'S OFFICE -----○-----  
 PRIVATE SURVEYORS -----○-----  
 CORNERS FOUND AND USED -----●-----  
 CORNERS LOOKED FOR AND NOT FOUND -----○-----

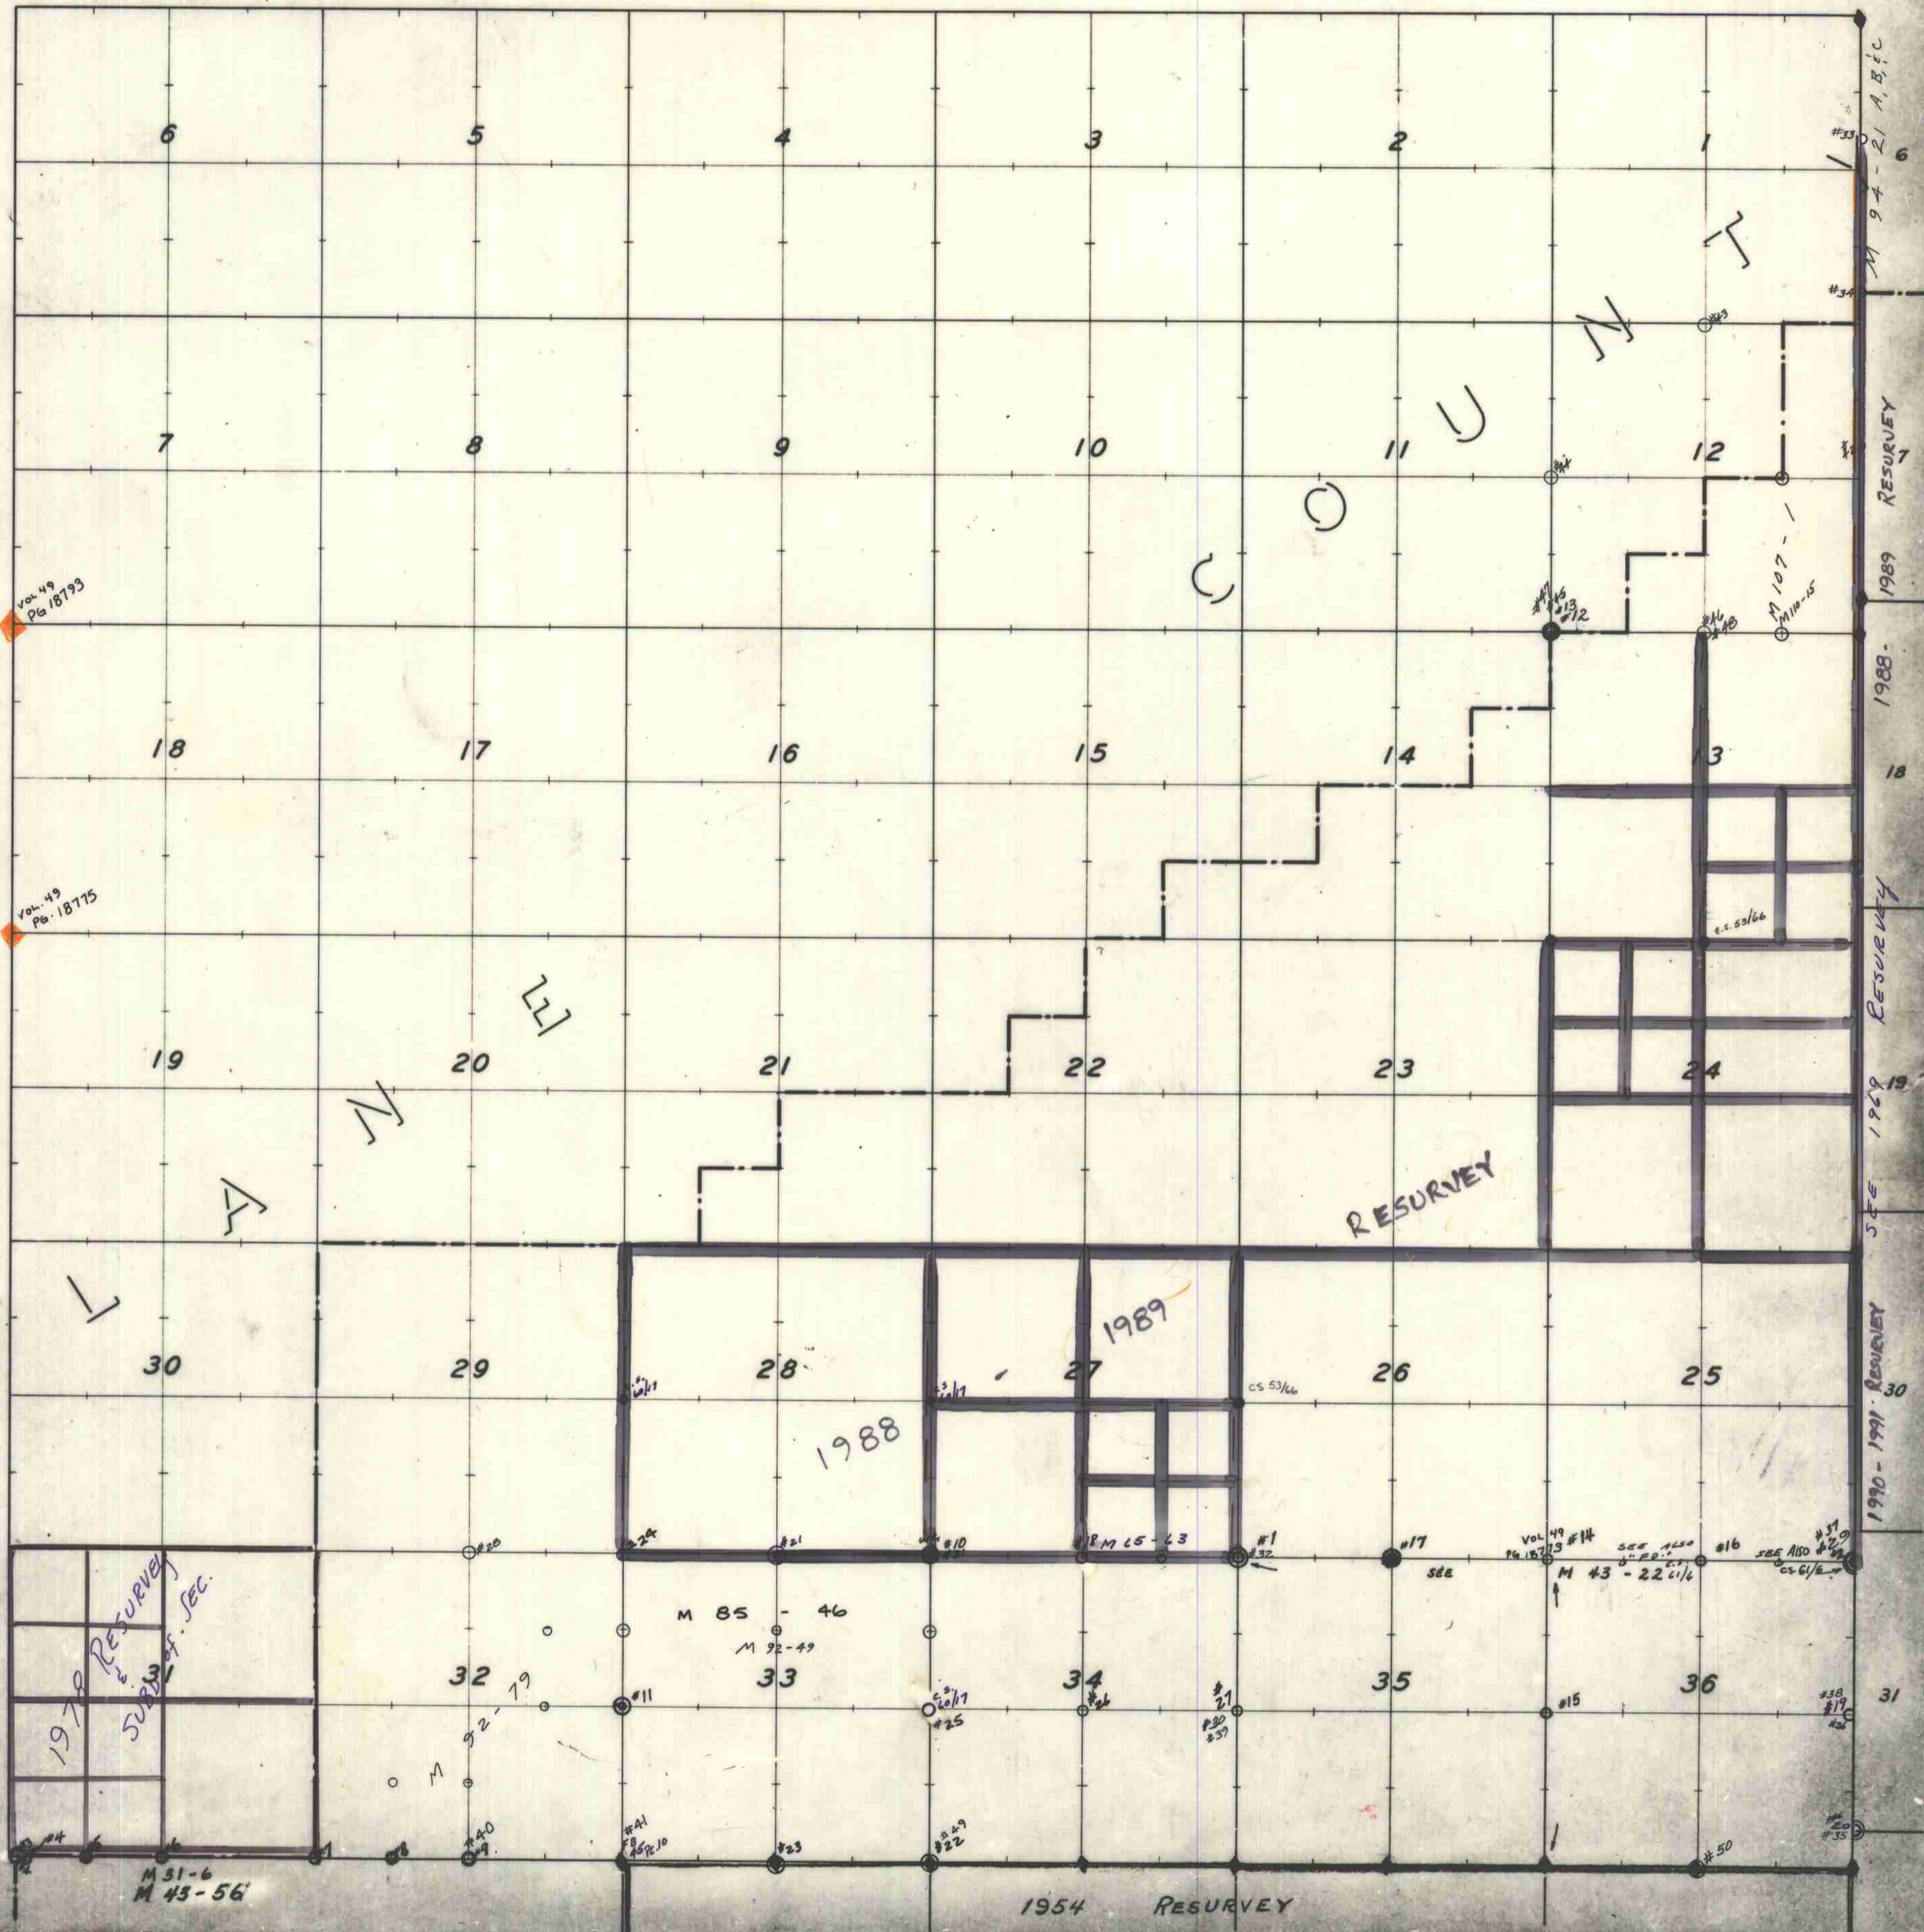

Vol. 49 Pg. 18793

Vol. 49 Pg. 18775

1978 RESURVEY  
SUBD. OF SEC.

M 31-6  
M 43-56

M 85 - 46  
M 92-49

1989

1988

RESURVEY

1954 RESURVEY

#33  
M 94-21 A, B, C  
#34  
RESURVEY  
1989  
1988  
18  
RESURVEY  
1969  
SEE  
1990-1991 RESURVEY  
30  
#31  
#32  
#33  
#34  
#35  
#36  
#37  
#38  
#39  
#40  
#41  
#42  
#43  
#44  
#45  
#46  
#47  
#48  
#49  
#50