


T. 19 S., R. 8 W.

049

CORNERS RENEWED BY
 BUREAU OF LAND MANAGEMENT
 COUNTY SURVEYOR'S OFFICE
 PRIVATE SURVEYORS
 CORNERS FOUND & USED
 CORNERS LOOKED FOR AND NOT FOUND
 DATA BY LANE CO. SURVEYOR

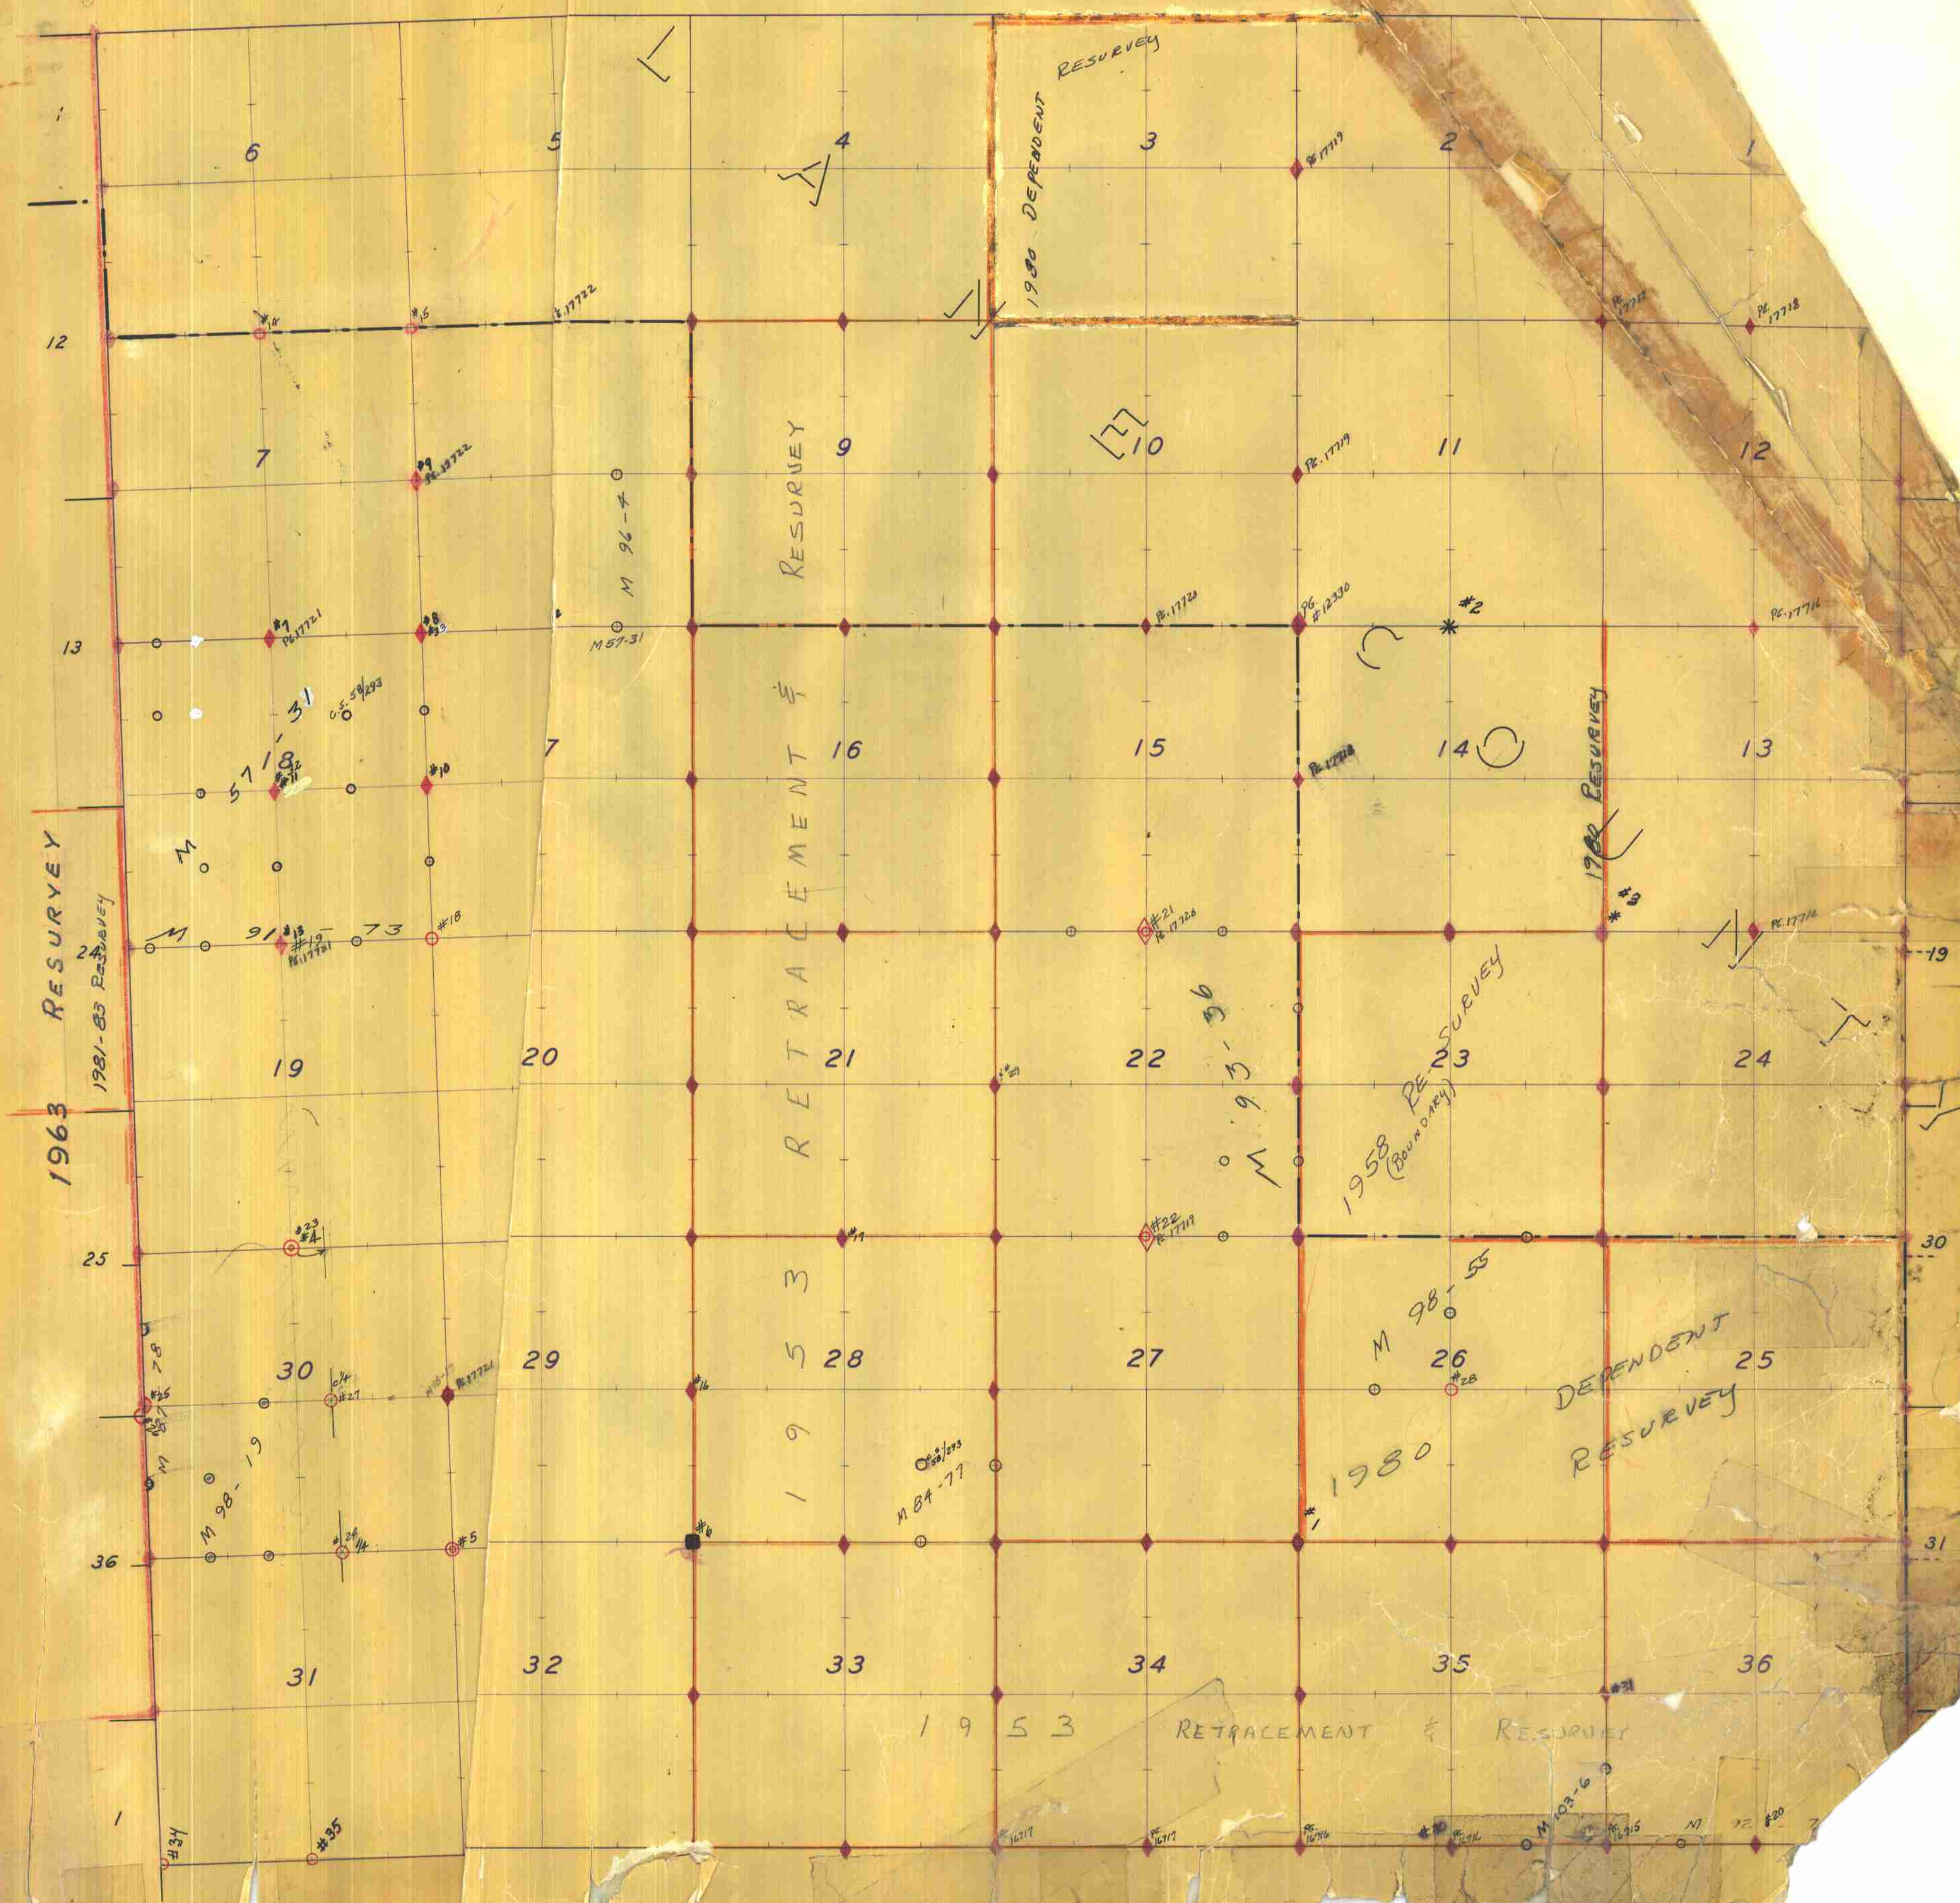

1A

T. 19 S., R. 8 W.

CORNERS RENEWED BY
 BUREAU OF LAND MANAGEMENT -----◆
 COUNTY SURVEYOR'S OFFICE -----○
 PRIVATE SURVEYORS -----○
 CORNERS FOUND AND USED -----■
 CORNERS LOOKED FOR AND NOT FOUND -----●
 DATA BY LANE CO. SURVEYOR *

