


T. 19 S., R. 9 W.

CORNERS RENEWED BY
BUREAU OF LAND MANAGEMENT -----
COUNTY SURVEYOR'S OFFICE -----
PRIVATE SURVEYORS -----
CORNERS FOUND AND USED -----
CORNERS LOOKED FOR AND NOT FOUND -----

1989 - 1990 RESURVEY

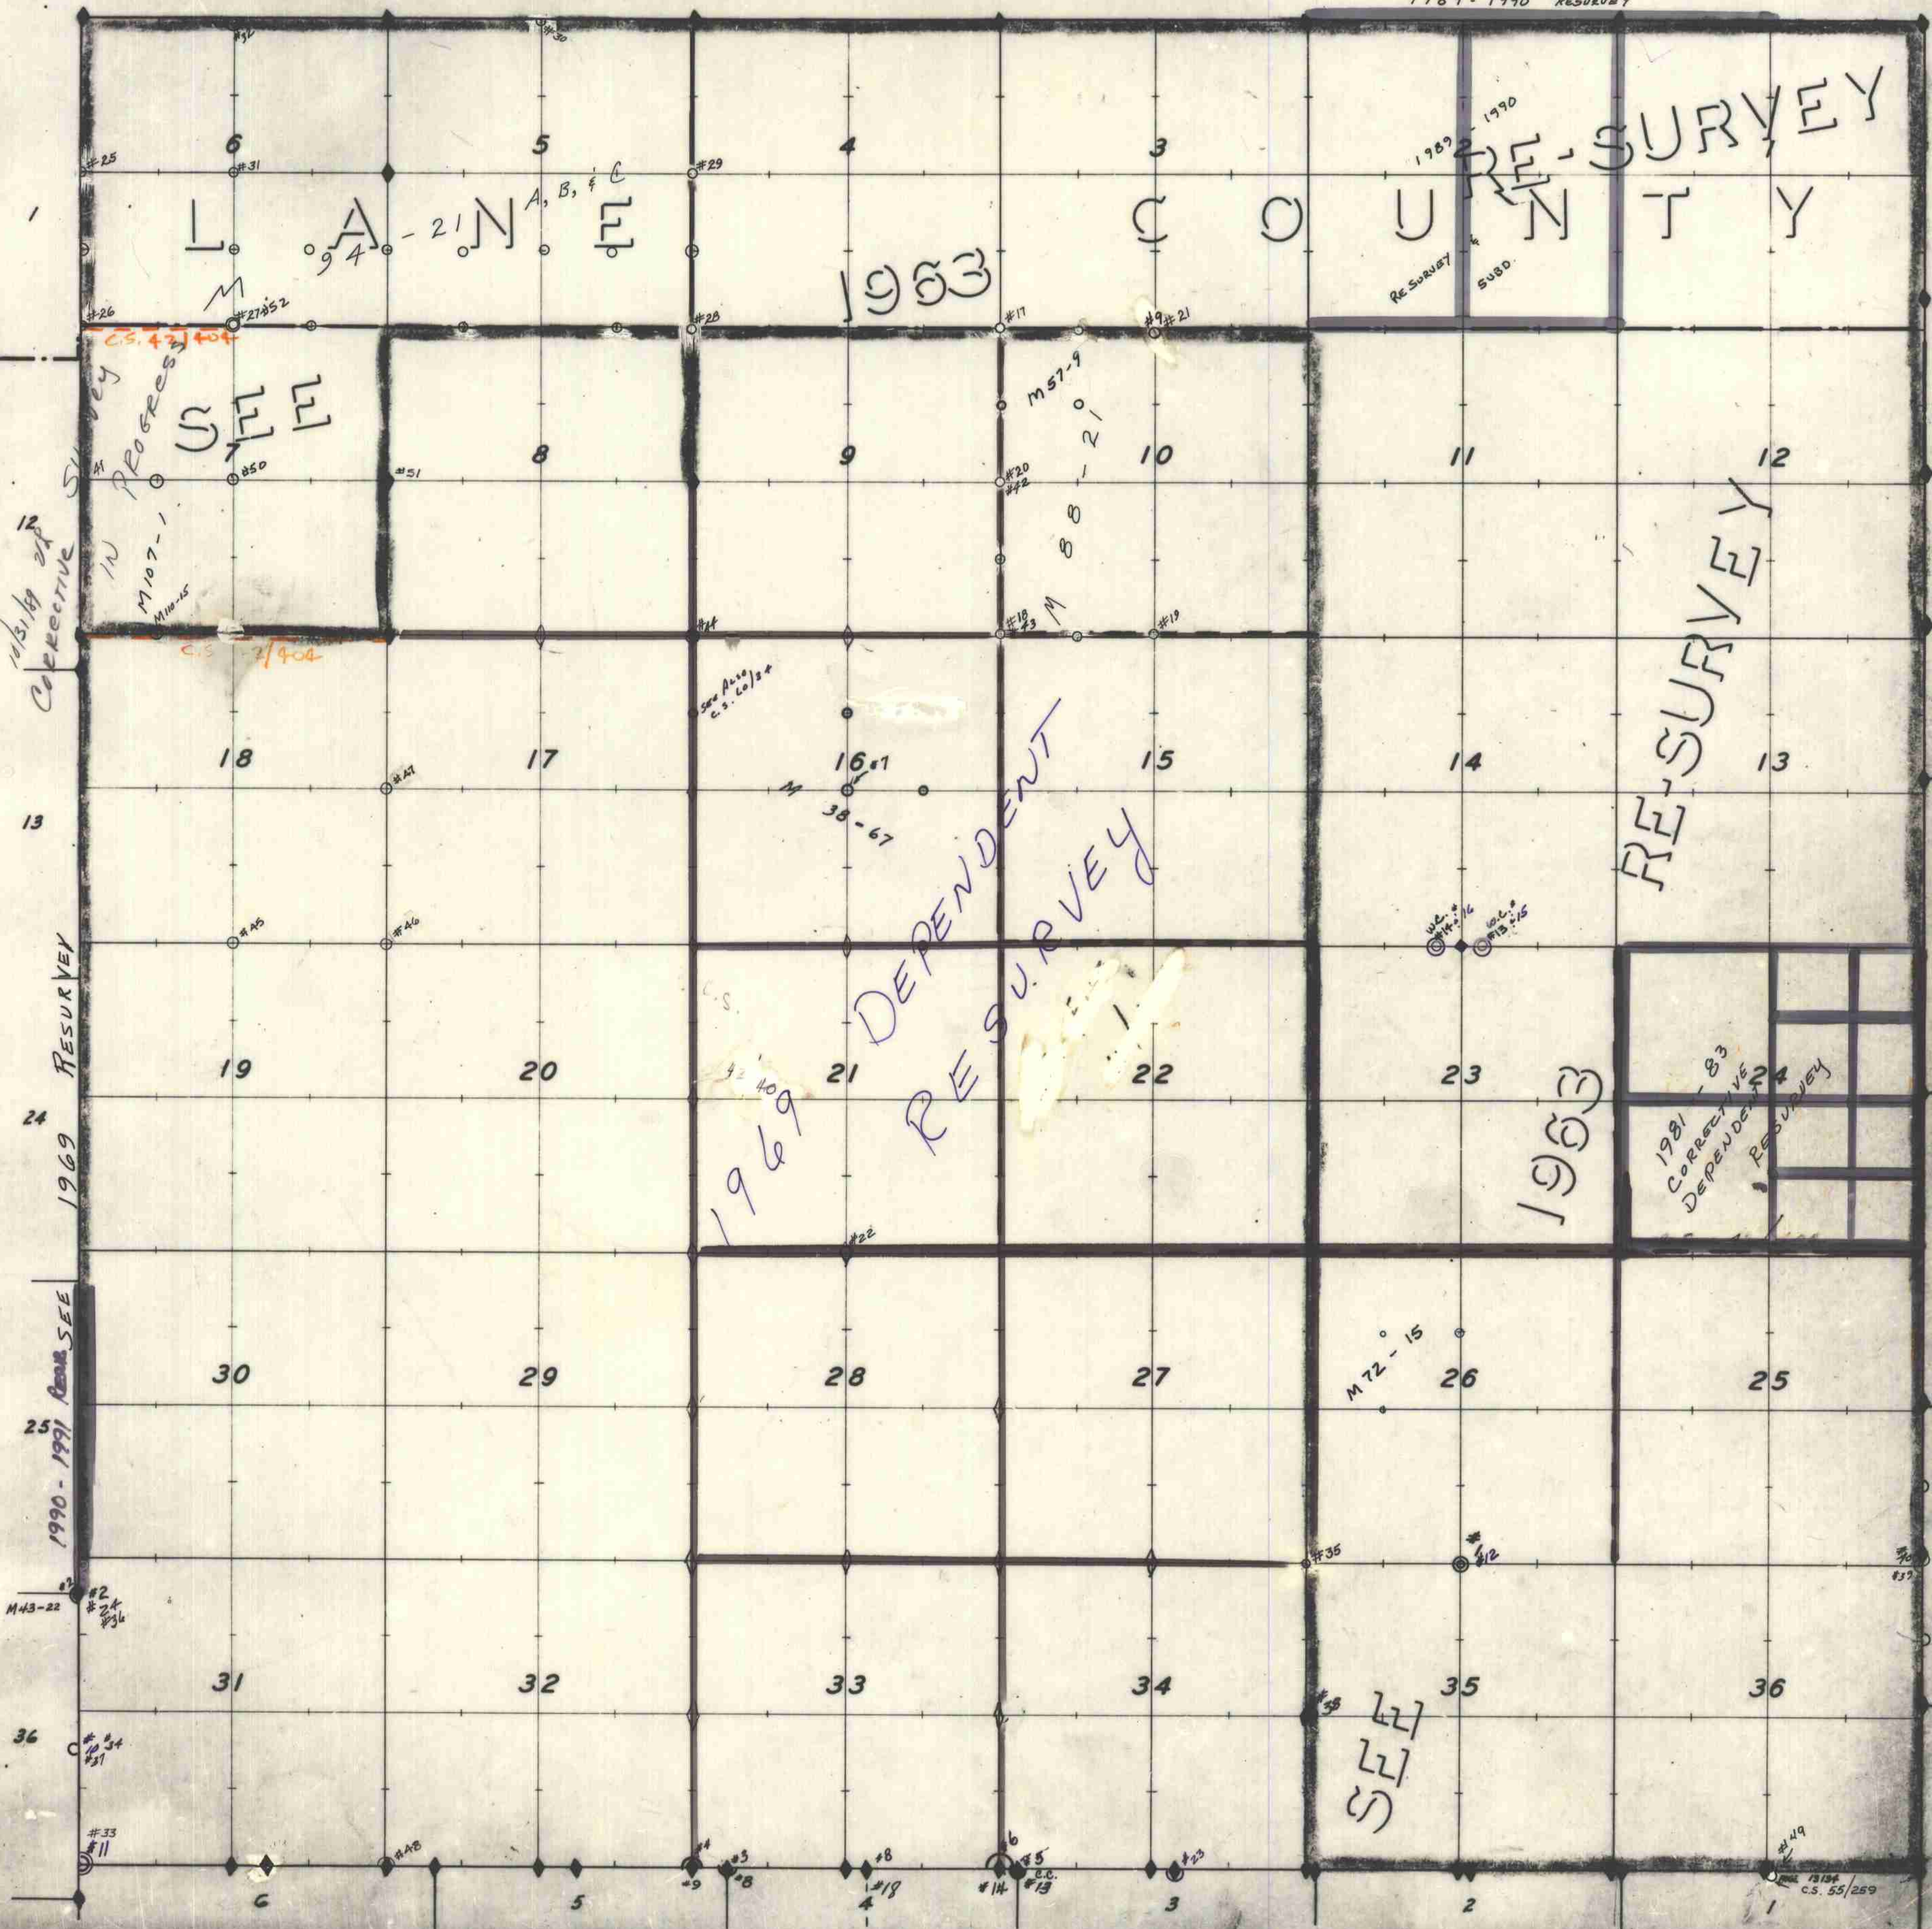

1969 CORRECTIVE SURVEY
PROGRESS
M 107-1
M 110-15
CS 47-104
CS 2/404

1963

1989-1990 RESURVEY
LAIN COUNTY
RE-SURVEY
SUBD.

1969 DEPENDENT RESURVEY

RE-SURVEY

1963

1981-83
CORRECTIVE
DEPENDENT
RESURVEY

1969 RESURVEY
1990-1991 RESURVEY

M 43-22
#2
#24
#34
#31

#33
#11

#48

#9
#8

#8
#18
#4

#14
#13

#23
#22

#14
#13

#23
#22

#35
#12

#39

#49

#49

CS 55/259