


6

T 19 S
T 20 S

T. 20 S., R. 8 W.

CORNERS RENEWED BY
 BUREAU OF LAND MANAGEMENT -----●-----
 COUNTY SURVEYOR'S OFFICE -----○-----
 PRIVATE SURVEYORS -----○-----
 CORNERS FOUND AND USED -----■-----
 CORNERS LOOKED FOR AND NOT FOUND -----○-----

1 9 5 3 R E S U R V E Y

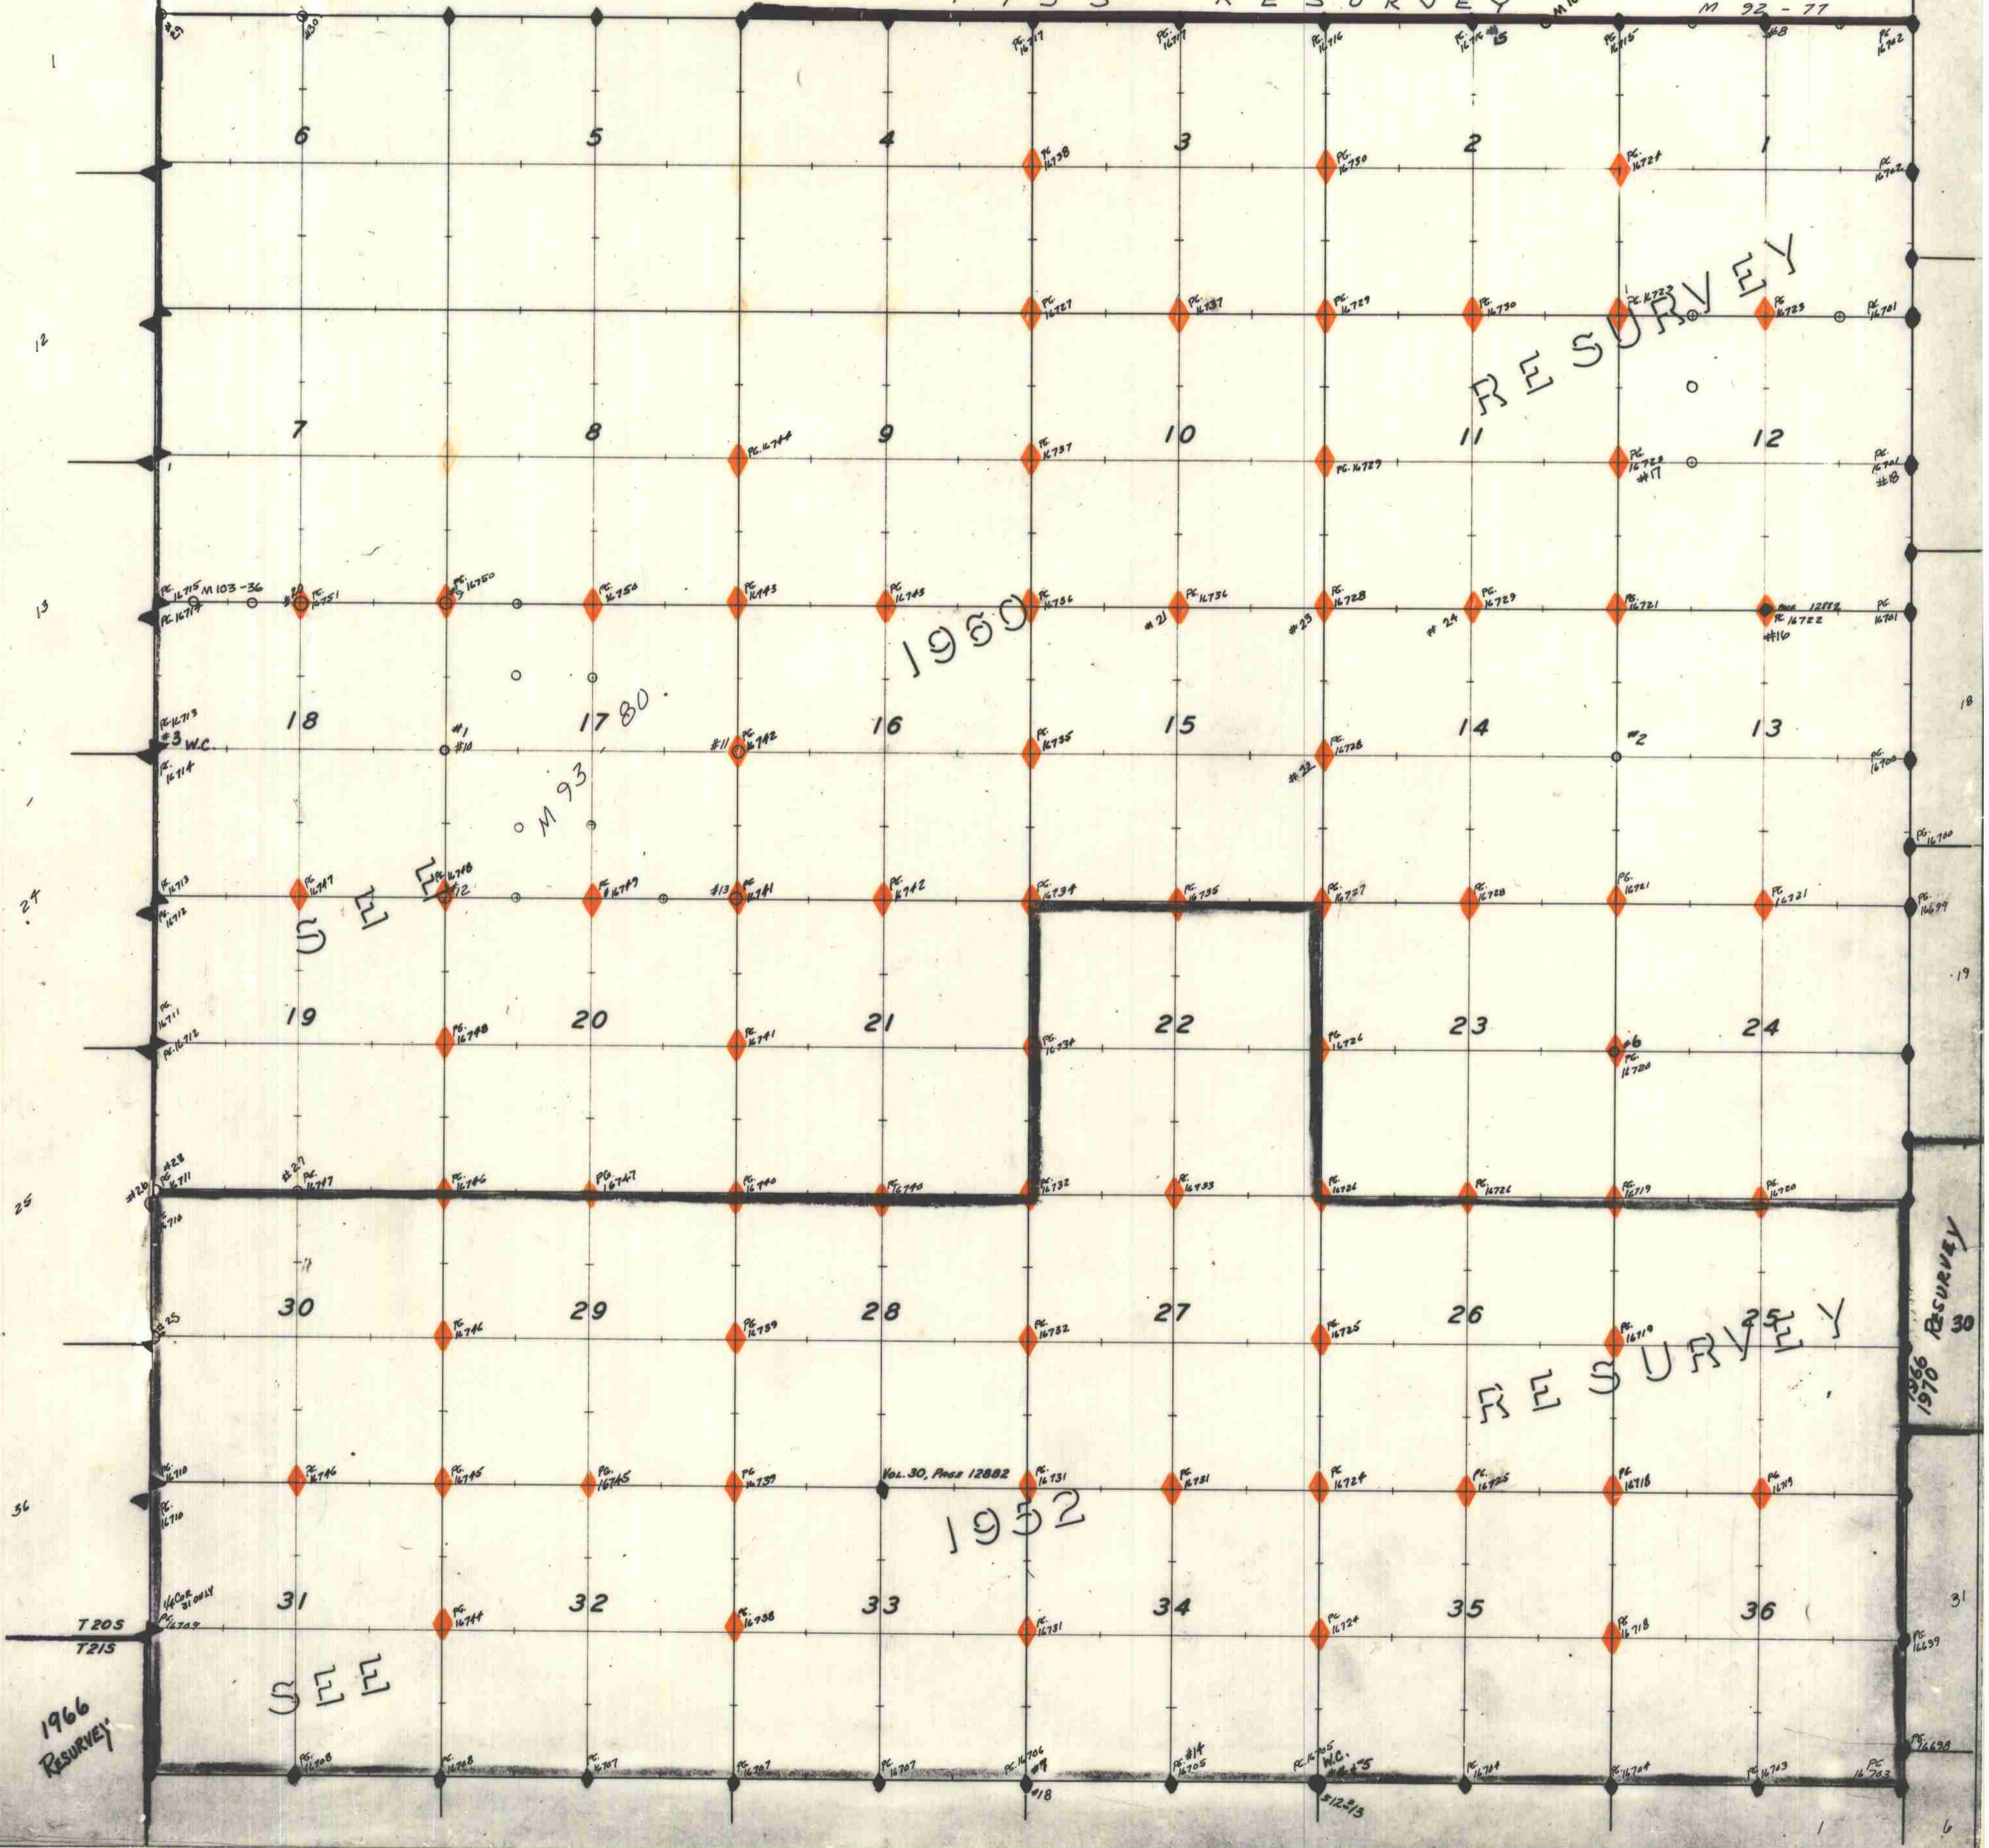

1950

1952

RESURVEY

RESURVEY

1966 RESURVEY

1970 RESURVEY

SEE

1966 RESURVEY

T 20 S
T 21 S

1

6