

Douglas County Surveyor's Record of
Government Corners Renewed

20 T. S. 9 R. W. W. M.


BY H. T. Lewis
Infr. #722
Nov. 10, 1939
Ren. cor. Vol. 1
Pg. 6

CORNER OF SEC. 36, T. 20 S., R. 10 W. & SEC. 31, T. 20 S.,
R. 9 W. SEE CORNER NO. 16
At this corner I found the original pine set for this corner,
on the cap of which was marked as follows:
This pipe has been upset by a falling tree,
but as the N. W. witness tree was in place,
I reset the pipe, from which
A Cedar, 8" diam., bears N. 65° E. 17ft.
Marked T. 20 S., R. 9 W., S. 31. R. T. C. S. 722

By John M. Phillips
For Snellstrom Lumber Co.
February 1960
C. S. File No. 51/69

1/4 Section Corner to Sections 14 and 23
Note - See C. S. File No. 51/69 for the desc. of this corner.
Data furnished by B.L.M. since the notes are not yet
recorded in the Surveyor's Office.

Upon searching for this corner in a freshly logged area:
1. I found the 72" Fir stump & put a B.L.M. B.T. tag on it.
Scribe is in good shape.
2. I also found the 50" Fir Stump & put a tag on it.
Scribe was not found, however.
3. I found a broken off Cedar stump where the 21" Cedar was
called for. No identification.
4. Where Cedar Corner was located, I found only a root hole.
I reset this 1/4 corner from the two Fir B.T. Stumps & marked
the corner with a 2" pipe four feet long sunk 40" in the ground.

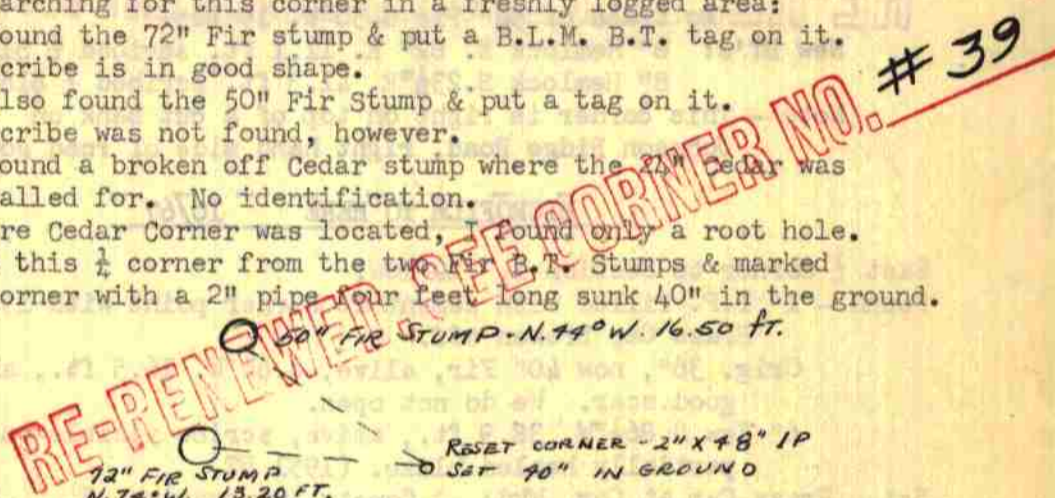

Mile E. Godfrey, Deputy Co. Surv.
Wm. Steffel & Mike Stone
September 1964
C. S. File No. 53/66

Section Corner to Sections 3 - 4 - 9 - 10.
Corner set on affidavit of Fred Zeigler, see reverse side of
original field notes in C. S. File No. 53/66.

Brass Cap & BT. mentioned in affidavit have been washed away.
Set - Brass Cap at Cor. Mkd: County Surveyor's T20S R9W S 4 S 3
Office, 1964 S 9 S 10

Pile Boulders around Corner.
New BT's: 50" D. Fir N. 70° W. 62.4 ft. Mkd: T20S R9W S4 CS BT.
60" D. Fir N. 30° E. 151.1 ft. Mkd: T20S R9W S3 CS BT.

Clear cut area S.E. & S.W. of corner. No trees available.
Note - Corner is in bottom of draw, approx. 75 ft. from forks in draw,
up left fork.

WIT. COR. to 1/4 Corner to Sections 6 and 5.
Corner renewed from trees referenced out from 1/4 Corner by
Merle Weaver (See affidavit in C.S. File No. 53/66) to wit:

8" Maple N. 85° W. 27.0 ft. - 14" Fir S. W. 47.8 ft.
Alum. Tags on both of these trees gave dist. to 1/4 Corner.
The corner position, as measured from these trees, falls part way up the
cut bank on the west side of Forest Service Road.
Set - Wit. Cor. 80 ft. S. of 1/4 Cor. Mkd: County Surveyor's Office, 1964
T20S R9W W.C. 1/4 S 6/S 5 80 ft. N. to Cor.

New BT's: 14" D. Fir N. 20° W. 40.4 ft. Mkd: W.C. 1/4 S 6 CS BT.
16" D. Fir South 45.2 ft. Mkd: W.C. 1/4 S 6 CS BT.
Note - Corner is approximately 30 ft. West of Forest Service Road.

Douglas County Surveyor's Record of
Government Corners Renewed

T. 20 S. T. S. R. 9 W. R. W. W. M.

5

$\frac{1}{4}$ Corner Section 18, only, T20-8W.
Found - GLO Brass Cap mkd. 1954.
26" Fir N. $41\frac{1}{4}^{\circ}$ E. 31 lks. scribed $\frac{1}{4}$ S18 BT
20" Hemlock S. $30\frac{1}{4}^{\circ}$ E. 5 lks. This tree is blown down.
Set - Set Brass Cap for Witness Corner marked:
W. C. 40' West to $\frac{1}{4}$ /S18 T20S R&W
County Surveyor's Office, 1965
New BT's: 12" Hemlock N. 72° W. 7.8 ft. scribed W.C. S18 CS BT.
12" Hemlock N. $40\frac{1}{2}^{\circ}$ E. 4.3 ft. scribed W.C. S18 CS BT.

John M. Powell
Joe Brady
Oct. 13, 1965
C.S. File No. 53/66

6

$\frac{1}{4}$ Corner to Sections 16 and 17.
Found - GLO Brass Cap Mkd: 1953.
34" Fir N. $7\frac{1}{2}^{\circ}$ E. 14 lks. scribed $\frac{1}{4}$ S16 BT. This tree
has been cut. //
No trace of 54" Fir S. 50° W. 19 lks.
New BT's: 6" Hemlock N. 82° E. 11.1 ft. scribed $\frac{1}{4}$ S16 CS BT.
8" Hemlock S. $23\frac{1}{2}^{\circ}$ E. 41.3 ft. scribed $\frac{1}{4}$ S16 CS BT.
Note - This corner is right on top of a cut bank on
Johnson Ridge Road, right hand side of road going North.

RE-RENEWED SEE CORNER NO. //

MICROFILM TO HERE 10767

7

East $\frac{1}{4}$ Corner to Section 1, T20-10W.
Found - 1" I.P. filled with cement at corner point with 1951
Brass Cap broken off.
Orig. 36", now 40" Fir, alive, S. 66° W. 16.5 ft., shows
good scar. We do not open.
6" Yew S. $86\frac{1}{2}^{\circ}$ W. 38.9 ft., alive, scribe visible on
partially healed blaze. (1951 BT)
Set - Brass Cap at Cor. Mkd: County Surveyor's R T 20 S R
(Deposit old pipe Office 10 $\frac{1}{4}$ S 1 9
alongside) 1968 W W
Note - This corner lies on very steep N. slope approx. 50 ft.
south of small creek, course N. W.

John M. Powell
Frank Jones & W. Penley
G. S. File No. 53/66

April 11, 1968

8

Closing Corner Sections 5 and 4.
Found - 1921 G.L.O. Brass Cap with badly rusted pipe, buried under
48" Cedar Log.
14" Maple, now 20" shattered stump, S. 38° E. 17.8 ft., no
scribe found on unhealed blaze.
30"(?) Alder, now 24" Stump, S. 15° W. 40.3 ft., blaze
decayed, no scribe.
Set - Brass Cap at Cor. Mkd: County Surveyor's CC T 19 S
(Deposit old corner Office S 5 S 4
material alongside) 1968 T 20 S R 9 W
New BT: 30" Maple N. 12° W. 67.6 ft. mkd. "CC S4 S5 CS BT.
No other trees available.
Note - This corner lies 20 ft. E. of small ravine, course N.E.
and 200 ft. S. of Middle fork of Smith River.

7/19/68

9

Section Corner to Sections 32 and 33., T19 - 9 W.
Found - 1921 G.L.O. Brass Cap, in place & firmly set.
Orig. 20", now 26" Fir sawed stump, N. 83° W. 22.4 ft., shows scar.
No trace other BT, due to slide.
There being no trees close, we set $\frac{5}{8}$ " I. Rod in front of BT. Stump
on N. 83° W. bearing 20.9 ft.
Set - $\frac{5}{8}$ " I.R. North 10.0 ft.
6" Steel Fence post alongside Brass Cap.
This corner lies on very steep northerly slope approx. 200' ft. from
log landing in Section 5.

7/19/68

10

Closing Corner Sections 6 and 7, T20-9W.
Found - Concrete filled I.P., no brass cap, broken off.
Orig. 30", now 34" Cedar, alive, N. 37° E. 34.3 ft., shows good scar.
Rescribe "T20S R9W S6 CC CS BT".
Orig. 40" Cedar, now 42" sawed stump, S. $82\frac{1}{2}^{\circ}$ E. 61.4 ft. scribe vis.
No other Trees to S.E. No suitable trees close N.E. or W.
Note - Corner Pipe was under logging debris which we removed.
(continued next page)

Douglas County Surveyor's Record of
Government Corners Renewed

T. 20 S. T. S. R. 9 W. R. W. W. M.

KOKE-CHAPMAN CO., EUGENE, ORE. 97001

Vernon "Ray" Tracy
Jack Heritage & V. Perron
July, 1968
C. S. File No. 53/66

(continued)

Set - Brass Cap at Cor. Mkd: County Surveyor's T 20 S R9W $\frac{S 6}{S 7}$ R10W
(Dep. old Pipe Alongside) Office, 1968
Note - This corner lies approx. 600 ft. W. of ridge, course N. & S. and
on N. side of ravine 15 ft. inlogged off unit.

7/10/68

Witness Cor. to $\frac{1}{4}$ Corner to Sections 17 and 16. 11
Found - GLO Brass Cap, nearly out of ground due to slide & Co. Surv. BT.,
as recorded in Ren. #6.
6" Hemlock N. 82° E. 11.1 ft., down & dead.
8" Hemlock S. 23 $\frac{1}{2}$ ° E. 41.3 ft., scribe visible, we add "WC".
At True Corner Set 5/8" x 30" I.R. & move Brass Cap S. 30 ft. to
point for witness corner & add "30 ft. N. to Cor." to Brass Cap.
New BT's: 6" Hemlock N. 84° E. 28.1 ft. mkd. "W C $\frac{1}{4}$ S16 BT".
8" Hemlock S. 67° E. 21.2 ft. mkd. "W C $\frac{1}{4}$ S16 CS BT".
1953 Fir Stump of BT about to slide out. Witness Corner now lies in
brush 10 ft. E. of top of cut bank on E. side of road about 50' above road.
7/10/68

S 197 '68

$\frac{1}{4}$ Corner Sections 26 & 25 12
Found - 1954 Cad. Brass cap out of place as determined from BT's as follows:
Orig. now 62" Fir N. 83° E 29.7' Sawed Stump--burned no scribe visible.
Orig. now 50" Fir N. 51° W. 13.7 " Sawed stump--1954 Rescribe visible.
1954 8" Hemlock S. 76° E. 7.3 " Now shattered stump. Scribe visible.
S.W. Hemlock down & out of place/
Reset - Brass cap at Cor. point & set steel fence post along side.
Mkd. new B.T.
12" Cedar N. 79° W. 98.5 " Mkd. S26 CS BT
No trees close to East. This cor. lies 30 ft. East of cold water Creek
Access Road. 5-15-69

RE-RENEWED, SEE CORNER NO. #52

Vernon "Ray" Tracy
Jack Heritage & Vernon Perron
6-19-69
C. S. File No. 53/66

Section Corner to Sections 4 & 3, T 19S, 20S R 9W 13
Found - 1921 G.L.O. I.P. & Brass Cap Broken--No trace O.B.T.S. We
measure from Sec. Cor. 33 & 34 of T 19S R 9W to locate pipe. Record
Dist. is 335.3. We make it 332.0 Ft. on bearing of N. 86° E. S 8.86° W
at Cor. point in place of old pipe
Set - 1" I.P. & Brass Cap Mkd: County Surveyors T 19S R 9W T 20S R 9W
Office, 1969 C. C. S4/ S3
& Mkd. new B.T.
48" D. Fir (stump) S. 27° E 45.6 Ft. Mkd. CC S3 CS BT
No other trees or stumps available. This cor. lies on very steep
S. W. Slope 6-19-69

Section Corner To Sections 33 & 34 Only 14
Found - 1921 G.L.O. Brass Cap on broken concrete filled I.P.
in place. T 19S S33/S34 R9W
30" Now 36" Fir N. 84° W. 23.8 Ft. Record S4
N. 31° W --Dead shows good scar. No trace of N. E.
B. T. Found.
Set - 1" I.P. & Brass Cap Mkd: County Surveyors T 19S
Office, 1969 S 33 / 34 R 9W
New B. T.
10" Maple N. 45° W 32.6 Ft. Mkd. T 19S R9W S33 CS Bt
No other trees close to N. E. This Cor. lies on very steep Southerly
slope on E. W. Cutting line. Clear cut to South. June 19, 1969

John M. Powell
Frank Jones & W. Penley
C.S. File No. 53/66

$\frac{1}{4}$ Corner to Sec. 31, T20-9W and Sec. 6, T21-9W. 15
Found - GLO Brass Cap, properly set in 1953. Cap in Fence Row North 203.3 ft.
25" Cedar, now 36", S. 86° W. 91.7 ft.
1 $\frac{1}{2}$ " Iron Pipe in bed rock bears N. 86° E. 351.8 ft. - No trace N.E. BT.
New BT: 19" Cedar N. 73° E. 255.2 ft. mkd: " $\frac{1}{4}$ S31 CS BT".
Reblzd. & Rescrbd: 36" Cedar S. 86° W. 91.7 ft. mkd: " $\frac{1}{4}$ S6 CS BT".
9/19/69

FOCK
ES WARD
2/23 1116-61

Douglas County Surveyor's Record of
Government Corners Renewed

T. 20 S. T. S. R. 9 W. R. W. W. M.

KOKE-CHAPMAN CO., EUGENE, ORE. 21881

Section Corner to T 20 S
R10W S 36 S 31 R9W
S 1

16

Found - GLO Brass Cap properly marked in 1951
16", now 27" Cedar, N. 66 $\frac{1}{2}$ ° E. 17.2 ft., shows good scar. - REN. #1
16", now 19" Cedar, N. 57° W. 34.3 ft., scribe visible, "S".
New BT: 24" Maple S. 24° E. 29.8 ft. mkd: "T21S R10W S1 CS BT".
Also tagged other Bearing Trees.

FD 9/1/83
R. 5510175
M 95-12

John M. Powell
F. Jones & W. Penley
Sept. 1969 C. S. File No. 53/66

~~Section Corner to Sections 1 and 12 only, T21-9W
Found - GLO Brass Cap properly mkd. in 1919 T21S R10W S 1 TWP
1919 S 12~~

WONG
RANGE

~~New BT: 17" D. Fir N. 59 $\frac{1}{2}$ ° E. 40.0 ft. mkd: T21S R9W S 6 CS BT.
Note - I renewed this corner because of new to be built. S. W. Tree
is on top of ridge and will probably be taken out. Sta. 72+30.~~

Section Corner to Secs. 31 & 32, T20-9 and Secs 5 & 6, T21-9W. 17
Found - Unmarked Pipe Cap & also GLO Brass Cap marked in 1953,
34" Cedar, now stob, S. 85 $\frac{1}{2}$ ° W. 58.1 ft., scribe visible.
33" D. Fir, now stump, S. 83° E. 77.2 ft.
11", now 13" Maple, N. 2° E. 103.0 ft., partial scribe visible, 67

New BT's: 14" Maple N. 7° E. 22.3 ft. mkd: T20S R9W S32 CS BT.
12" Maple N. 46° W. 22.6 ft. mkd: T20S R9W S31 CS BT.
15" D. Fir S. 23° E. 23.8 ft. mkd: T21S R9W S 5 CS BT.
16" Maple S. 50° W. 21.7 ft. mkd: T21S R9W S 6 CS BT.
This corner is in E - W Fence Line.

RE-RENEWED
CORNER #10

9/29/69

North $\frac{1}{4}$ Corner Section 4 only, T20-9W. 18
Found Corner established in 1921 by Collier, which is:
a cement filled pipe set in 1921 by G.L.O., from which:
40" Fir bears S. 2° W. 12.4 ft., evidence of face.
Set - 2"x 30" Iron Pipe with Brass Cap Mkd: T 20 S R 9 W

Set pipe alongside corner.
Set fence post with signs \pm 5 ft. S., facing E. 1970 650
April '70

Tom O. McCullough
For. U.S. Forest Serv.
April 1970
C.S. 55/148
John M. Powell
J. Heritage
May 1971
C.S. File No. 53/66

South $\frac{1}{4}$ Corner Section 34 only, T20-9W 19
Found - GLO Brass Cap, date 1953, properly marked.
20" D. Fir, now stump, N. 49 $\frac{1}{2}$ ° E. 33.0 ft. Shows good scar.
Set - Steel fence post along side Brass Cap.
New BT's: 14" Hemlock S. 85° W. 69.7 ft. scribed C.S. BT
30" Cedar S. 44 $\frac{1}{2}$ ° E. 77.4 ft. scribed C.S. BT.
To the north of this corner is clear cut.
Northwest BT buried by logging show.

MARCH 71

Center 1/4 Corner Section 12. 20
Set - 5/8" Iron Rod.
Location Sign on 30" Cedar which bears N. 60° E. 12.5 feet.
7/8/72

Hintz, Richard
J.
M 46-57
For: B.L.M.
Jan 1972

$\frac{1}{4}$ Corner for Section 10 only. (West $\frac{1}{4}$) 21
Found - Badly rusted iron pipe with concrete core firmly set in
ground, brass cap missing.
Orig. 9" now 18" Alder bears N. 80° E., 5.9 ft. well healed and
in good condition/
Orig. 8" Alder, now 16", bears S. 22° E., 25.1 ft. well healed
and in good condition.

Gary Langlit
P. Earle
C.S. 56/43
2/13/74

Set - Brass cap alongside remains of original monument mkd.:
COUNTY SURVEYORS T 20 S R 9 W
OFFICE $\frac{1}{4}$
1974 S 10
2/13/74

200 25

Douglas County Surveyor's Record of
Government Corners Renewed

T. 20 T. S. 9 R. W. W. M.

KOKE-CHAPMAN CO., EUGENE, ORE. 21881

22

1/4 Corner for Secs. 17 and 20
Found - U.S. GLO Brass cap, 1953, properly marked, with a steel fence post alongside.
BT's - 60" now 54" D. Fir stump bears S.76° W., 27.7 ft., scribing partially visible at edge of lower blaze. Note (This stump has had the bark removed, been treated with a liquid preservative and covered with sheet metal.)
The NE BT, marked in 1953, has fallen and slid downhill out of position. The main portion of the tree has been removed in recent logging. Scribing is partially visible near base of root wad.
New Bearing Object - A boat spike, driven in the top of a 58" D. Fir stump, bears N.64° W., 33.1 ft.
Note - This corner lies on steep slope near the bottom of and approx. 150' north of a ravine in a recently logged area. 3/15/74

Gary Langlitz
Surveyors office
P. E. Le
C.S. 6/49
March 15, 1974

Gary L Langlitz, Surveyors office
John Nordling
Feb. 2, 1975
C.S. 57/17

23

1/4 Corner for 3 and 4.
Found - Badly rusted 1" I.P. with brass cap attached. 1921 GLO cap properly marked.
From which:
An orig. 40" now 52" D. Fir bears S.35° E., 23.1 ft. alive and well healed.
An orig. 40" now 52" D. Fir bears N.84° W., 21.8 ft. alive and well healed.
Note: The brass cap and uppermost 4 in. of the orig. monument were inadvertently broken off during the setting of a new monument at the corner. The remaining portion of the orig. monument, a badly rusted 1" I.P. filled with concrete was placed alongside the new monument.
Set - At the corner point we set a 1"x30" I.P with brass cap attached mkd:
COUNTY SURVEYOR T 20 S
OFFICE S 4 S 3
1975 1/4
R9W 2/4/75

L.E. Monrean
P.L. E
D.L.S.
C.S. 57/39
11/4/75

24

1/4 Corner for 31 and 30
Found-U.S. GLO Brass cap, 1953, properly marked;
BT's -A fir, 54", diam. bears N25° W., 34.3 ft. shows good blaze. Other bearing trees not found.
Renewal;
50" Diam. fir bears S21 1/2° W., 81.4 ft. scribed "1/4 S31 CS BT"
Note: Corner lies approx. N82° E 3/8 mile from last landing on road #20-10-29.1. Corner is approx 180 ft. east of ridge running S5° E., & approx 60 ft lower than ridge top. 11/4/75

File 2193
by Ward
M 116-61

25

Witness Corner to
Closing Corner Sec. 1 T21-10 Sec. 6 ~~T21-10~~ ^{T21-9} only
Found-A Cedar 40" now 52" in Dia. bears S42° E, 44.5 ft. (rec 46.2 ft) blazed .
A Cedar 45" now 55" in Dia. bears N38° W, 21.8 ft, scribed "WCC T21S R9&10 W"
Maple bearing tree not found, bearing and distance recorded fall in Large growth of Maples in slide area.
Set Brass Cap at W.C. to C C stamped
T20S R9W
CC S31
S1 S6
R 10 WR 9W
T21 S
Note: Corner lies near so. Bank of Smith River, Nearly directly across from fence running north & south at east end of Fawn Creek Park 11/5/75

175 (11/5/75)

26

Closing Corner to Sec. 4 & 5 REN # 13
Found-38 (Rec. 48) inch dia. fir stump. Stump is rotted, partial scribing visible "CC S 3 BT" Stump bears S27° E., 45.6 ft.
Brass cap not found T 19S R9W
Set-Brass cap at closing corner stamped S 34
S 4 S 3
C.C.
T20S R9W
Set spike in 43" Dia. Fir stump. Spike bears S39° W, 118.4 ft, spike stamped "B.O.". There are no suitable trees for scribing in the southerly quadrants
Corner falls in a steep slide area. Mag. Dec. 1/20/76

L.E. Monrean
P.L. Earle
J.H. Cook
1/20/76
C.S. 59/2

+ + 3-77

Douglas County Surveyor's Record of
Government Corners Renewed

20

T. S.

9

R. W. W. M.

KOKE-CHAPMAN CO., EUGENE, ORE. 21881

27

1/4 Corner for Secs. 7 and 8

Found - 1921 GLO brass cap rusted and broken off at the ground.
A 40" D. Fir, bears S.57 1/2°E., 15.2 ft. Tree has well healed single blaze. We do not open.
A 28" Maple bears S.28°W., 16.5 ft. Tree has well healed blaze. We do not open.
Set - 1" x 30" I.P. at 1/4 cor. 26" into the ground. Attached brass cap is marked "Douglas County Surveyor" T20S R9W 1/4 S7 S8 1977
New BT- A 33" Maple bears S.57 1/2°W., 69.3 ft. Tree double blazed and scribed "1/4 S7 CS BT".

5/10/77

28

Section corner for Secs 6; and Sec. 31 of T.19-9

Found - Remains of the 6" Chitten.
Set - 5/8" x 40" Iron rod S.20°W., 40 lks. from the uproot hole where the 6" Chitten stood.
New BT's- 48" D. Fir bears N.32 1/2°E., 49.0 ft. marked "BT S31 T.19S. R9W"
44" D. Fir bears S.53 1/2°E., 18.2 ft. marked "BT S.6 T.20S. R.9W."

Forrest J. Hales
For: International Paper Co.
June 3, 1978
M 71 - 62

RE-REVIEWED. SECTION CORNER NO. #49

6/3/78

29

Center 1/4 of Sec. 32.

Set - Brass Cap, on a 1 3/8" x 36" pipe, marked: C 1/4 S32 T20S R9W 1981 PLS 377.
New BT's- 14" Hemlock scribed C1/4 S32 BT, bears S.45°E., 32.7-ft.
15" Maple scribed: C 1/4 S32 BT, bears S.49°W., 47.4-ft.

William A. Eimstad
For: Int. Paper Co.
August, 1981
M 89 - 13

8/81

30

1/4 Corner for Secs. 3 and 10

Found - 1921 US GLO brass cap.
New BT's- 42" fir, S.43°W., 25.0 ft.
34" fir stump, N.13°E., 47.7 ft. (dist. to R/R spike in top).

6/82

31

North 1/4 Section 3 only.

Found - 1921 US GLO brass cap lying beside rusted pipe.
Set - Drove 1 1/2" x 36" I. Pipe over top of original pipe and cemented new cap in pipe. New cap marked "T20S R9W 1/4 S3 PLS 752 1982".
New BT's- 42" fir, S.64°E., 44.0 ft.
40" fir, S.8°W., 44.2 ft.

Donald Peel
For: International Paper Co.
June 8, 1982
M 92 - 28

6/82

32

1/4 Corner common to Sec. 30, and Sec. 25, of T.20-10.

Found - 1951 GLO B.C.
BTs - 12" fir stump, bears S.26°W., 9.3-ft. (no marks) 1951 BT.
18" fir bears S.36°E., 20.9-ft. (scar visible) 1951 BT.
New BT - 28" fir bears N.24°W., 40.8-ft. (scribed). 10/82

Les Roberts
L.S.#1039
For: International Paper Co.
Oct. 8, 1982
M 90 - 28

33

Center 1/4 of Sec. 30.

Set - 1-1/2" x 36" I.P. & B.C.
New BTs - 19" alder bears N.10°W., 32.0-ft. (scribed).
37" fir bears S.58°E., 37.4-ft. (scribed). 10/82

34

1/4 Corner common to Secs. 16 & 21.

Found - 1953 G.L.O. B.C.
No 1953 BTs. found.
New BTs - 44" fir bears N.87°W., 22.5-ft. (scribed).
80" fir bears S.10°E., 88.0-ft. (scribed). 12/82

35

Center 1/4 corner of Sec. 21.

Set - 1-1/2" x 36" I.P. with B.C. marked with S-T-R, date, & PLS#1039.
New BTs - 33" fir bears S.42°E., 8.7-ft. (scribed).
42" fir bears N.73°W., 27.0-ft. (scribed).

Les Roberts
PLS # 1039
For: Int. Paper
Dec. 10, 1982
M 90 - 31

**Douglas County Surveyor's Record of
Government Corners Renewed**

T. 20 S. T. S. R. 9 W. R.W.W.M.

ROKE-CHAPMAN CO., EUGENE, ORE. 21881

Les Roberts
PLS #1039
For: International
Paper Co.
Dec. 3, 1982
M 90 - 33

Center 1/4 Corner of Sec. 20. 36
Set - 1 1/2" x 36" I.P. w/B.C.
New BTs- 20" fir bears N.85°W., 21.2-ft. (scribed).
 26" fir bears S.1°E., 23.8-ft. (scribed). 12/82
1/4 Corner common to Secs. 20 & 29. 37
Found - 1953 GLO B.C.
BTs - 24" downed fir bears N.2°E., 32.0-ft. (scar visible) 1953 BT.
New BTs- 15" fir bears S.38°E., 32.7-ft. (scribed).
 17" maple bears N.39°E., 38.5-ft. (scribed). 12/82

Les Roberts
PLS #1039
For: International
Paper Co.
Feb. 1983
M 93-63 & M 93-64

Center 1/4 Corner of Sec. 15. 38
Set - 1 1/2" x 36" Iron Pipe and Brass Cap.
New BT's- 23" fir bears N.77°E., 32.2-ft. (scribed / set washer).
 28" fir bears N.15°W., 54.5-ft. (scribed / set washer).

South 1/4 Corner common to Secs. 14, & 23. 39
Fd. - 2 1/2 " I.P. set in 1960. Ren. # 2.
BT's - 24" cedar stump bears S.65°E., 5.9-ft. (no marks)...1891 BT.
 34" fir stump bears N.44°W., 16.5-ft. (no marks)...1891 BT.
 60" fir stump bears N.74°W., 13.2-ft. (scribe vis)..1953 BT.
 38" fir stump bears S.49°E., 22.7-ft. (scribe vis)..1967 BT.
Set - 1 1/2 " x 36 " I.P. & Brass Cap beside the 2 1/2" pipe
New BT - 12" fir bears S14°E., 6.4-ft. (scribed/set washer). 2/83

Stephen L. Swinehart L.S. 2013
For: U.S. Forest Service - Siuslaw National Forest
July 1983
M 94 - 77

Section corner for 8 and 9 only. (SOUTH) 40
Found - 1954 GLO brass cap (1953-54 Cadastral survey)
 18" fir windfall, rotten hull w/ scribing bears N.63°E., 12.1
 to blaze. (6" N.60°E., 10.6 ft.) root hole matches orig. callow
 36" fir windfall w/healed blaze bears N.6°E., 18.0 ft. to blaze.
 (36", N.25°W., 23.8 ft.)
 18" maple w/BT tag bears S.44 3/4°E., 13.1 ft. Tag, S.59°E., 14.9'.
New BTs - 43" fir, "T20S R9W S8 BT", N.25 3/4°W., 51.3 ft.
 34" fir, "T20S R9W S9 BT, N.70 1/2°E., 42.6 ft.
We raised a stone mound around the monument.

Section corner for Secs. 16 and 17 only. (NORTH) 41
Found - 1953 GLO brass cap
 60" fir stump, S.48°E., 94.4 ft. with visible scribing (55",
 S.48°E., 94.4 ft.)
New BTs- 22" fir "T20S R9W S17 BT" bears S.37°W., 62.0 ft.
 50" fir "X BT" bears N.10 3/4°W., 40.0 ft.
We raised a stone mound around the monument.

South 1/4 corner for section 9 only. 42
Found - Brass cap marked 1/4 S9 rusted off
 1" iron pipe with concrete core (1921)
 7" vine maple windfall with no visible marks - root hole,
 N.1 3/4°W., 49.1 ft. (Mensch, N.1°W., 47.5 ft.)
Set - F.S. Alum. cap and pipe. Buried old pipe alongside
New BTs - 9" fir, "1/4 S9 BT", bears N.28 3/4°W., 64.7 ft.
 6" fir, "1/4 S9 BT" bears N.9 3/4°E., 65.0 ft.
We raised a stone mound around the monument.

North 1/4 corner for section 16 only. 43
Found - Broken stone monument with no visible marks. (1891)
 27" fir stump with healed face and county location tag bears
 N.10°W., 7.9 ft. (N.5°W., 7.9 ft. Theil)
Set - F.S. alum. cap and pipe. Buried stone.
BTs - 8" alder, "1/4 S16 BT" bears S.83°E., 54.1 ft.
 19" hemlock, "1/4 S16 BT" bears S.6 1/2°E., 75.0 ft.
We raised a stone mound around our monument

Douglas County Surveyor's Record of
Government Corners Renewed

T 20

T. S.

R 9

R. W. W. M.

ROKE-CHAPMAN CO., EUGENE, ORE. 21881

44

Section corner for Secs. 9, 10, 16 and 15.

- Found - Orig. fir corner tree, now 44" with dead top (36").
58" fir stump with blaze, N.70°E., 31.5 ft. (36", N.71°E., 30.4 ft.)
58" fir stump, N.13°W., 26.6 ft. (36", N.19°W., 22.8 ft.)
38" fir stump, S.4°W., 22.1 ft. (38", S.9°W., 19.1 ft.)
29" fir stump, S.43°E., 29.3 ft. (15", S.40°E., 30.4 ft.)
- Set - 2" brass caps and 1" x 30" iron pipes for reference monument:
One marked "S9 RM" is N.20°27'W., 41.33 ft. from the corner.
The other marked "S10 RM" is N.70°06'E., 37.88 ft. from the corner.
- We raised stone mounds around the monuments.

Stephen Swinehart
L.S. 2013
For. U.S. Forest
Service
July 1983
M 94 - 77

45

East 1/4 corner for section 9 only.

- Found - GLO brass cap marked "1/4 S9 1921" with concrete core - cap rusted off.
22" fir windfall with healed face - face is N.73°E., 40.8 ft.
(24", N.83°W., 40.9 ft.)
30" fir windfall with possible face - face is S.87°W., 23.0 ft.
(36", S.70°W., 37.6 ft.)
- Set - F.S. alum. cap and pipe. Buried the old pipe alongside.
- New BTs - 16" hemlock, "1/4 S9 BT" bears S.72 1/2°W., 93.1 ft.
12" alder, "1/4 S9 BT" bears N.51 3/4°W., 46.3 ft.
- We raised a stone mound around the monument.

7/83

46

Witness corner for 1/4 corner, Secs. 16 and 17

- Note - The true location of the 1/4 corner is at the top of a cutbank above the 20-9-29.1 road. The 5/8" Iron rod set by the county in 1968 has slid out and lies NW of true corner. Ren. #17
- Found - 28" fir stump with scribing, N.7 1/2°E., 9.2 ft. (1953).
1953 GLO brass cap on 1" iron pipe for witness corner, S.5° W., 30.57 ft. from the true 1/4 corner.
- We X out "30 ft. N. to cor." stmped on cap.
- Found - 12" hemlock with blaze & scribing, N.84 1/4°E., 27.8 ft. (rec. 1968, N.84°E., 28.1 ft.)
16" hemlock with healed blaze, S.67 3/4°E., 20.2 ft. (rec. 1968 S.67°E., 21.2 ft.)
- New Witness BT:
14" hemlock, S.12 1/4°E., 47.2 ft. scribed "1/4 S16 WC" BT".
- We set fence post & signs at the witness corner. It is impractical to set a monument at the true corner location at this time. We searched for but found no evidence of Theil's original corner.

Stephen Swinehart
L.S. 2013
For: International
Paper Company
November 1983
M 95 - 53

47

Section corner for secs. 16, 17, 20 and 21.

- Found - 1953 GLO brass cap on 2" galv. pipe.
48" fir stump with no marks, N.27 3/4°E., 38.2 ft. (1891 rec. N.28°E., 35.6 ft.)
26" fir stump with no marks, S.78 1/4°E., 18.1 ft. (1891 rec. S.76°E., 16.5 ft.)
36" fir stump with no marks S.5 3/4°W., 9.5 ft. (1891, S.9°W., 8.6 ft.)
40" fir stump, S.53 1/4°E., 69.7 ft. (1953, S.52 3/4°E., 70.0 ft.)
23" fir stump with healed face, S.70°W., 91.3 ft. (1953, S.70°W., 92.4 ft.)
36" fir stump with healed face, N.19 1/4°W., 58.8 ft. (1953 rec. N.21°W., 60.1 ft.)
- Set - We set 2 reference monuments:
RM 1, bears N.9°52'E., 34.66 ft.
RM 2 bears S.86°26'W., 69.95 ft.
- We set a steel fence post near the brass cap.
- The reference monuments set at the SW section corner are 5/8" x 30" rebar with a yellow plastic cap marked "S Swinehart" L.S. 2013."

**Douglas County Surveyor's Record of
Government Corners Renewed**

T 20 T. S. R 9 R. W. W. M.

HOKE-CHAPMAN CO., EUGENE, ORE. 21881

48

Stephen Swinehart
For: International
F er Company
Nc mber 1983
M - 53

Center 1/4 corner for Section 16.
Set - 2 1/2" brass cap in concrete on rock face. Cap marked "T20S R9W S16 LS 2013 1983".
New BTs-62" fir bears S.17°E., (magnetic) 72.0 ft. scribed "C 1/4 S16 BT" on one lower blaze.
34" fir, bears S.86 3/4°E., 110.0 ft. scribed "C 1/4 S16" BT".
We set a steel fence post with BT tag, N.11°W., 22.3 ft.

11/83

CC at SW corner of Sec. 31, T. 19 S., R. 9 W. (Tnsp. corner) Ren #28 **49**
CORNER REPORT ONLY.

History - This corner was originally established in 1899 by Chandler. The corner mon. was a 6" chittum - BTs were: 6" chittum N. 20° E., 40 lks., and 20" fir S. 26 3/4° E., 26 lks.
In 1921, Mensch fnd.the corner & scribed a 4" chittum S. 38° E., 10 lks., as the orig fir BT was dead.
In 1978 (See Co. Surv. file # M71-62) Forrest Hales fnd an up-rooted chittum & set a 5/8" Iron Rod for the closing corner mon., holding the position of the fnd chittum as the orig. northeast bearing tree.

Mon. Fd. - 5/8" I.R. (Set by Hales).

Accessories Fd. - BTs described by Hales survey:

48" D. Fir, single blazed w/scribing bears N. 32 1/2° E., 51.1 ft. (Rec. 49.0 ft.)

40" D. Fir (Rec. 44") single blazed w/visible scribing "S6 T20S R9W BT" bears S. 50° E., 21.4 ft. (Rec. S. 53 1/2° E., 18.2 ft.)

NOTE - I visited this corner with Ernesto Alvarado of the Siuslaw Nat. Forest, who produced a copy (see file) of a Forest Service "CORNER RECORD" card dated 1968. According to the info. on the card, the cor. had been visited by J. Deaton & D. Thrall 10 years prior to the Hales survey. The card shows that a 16" fir stub w/scribing was located & that blazed lines ran E. & S. from the cor. position. This evidently was accepted as the Orig. fir BT reported by Mensch to be dead in 1921 (47 years earlier). Mr. Alvarado indicated that he had set a temporary stake at the Orig. bearing & dist. from a decayed fir stump (stump bears S. 26 3/4° E., 26 lks. from stake)
From the Hales 5/8" I.R. we measure to the temp. stake set by Alvarado N. 22° E., 16.9 ft., & we measure to the 30" fir stump S. 89 1/2° E., 11.3 ft. We did not find any scribing on the fir stump. We fnd blazed line running E. and N. from the general area of the closing cor. (the blazed line to the North was East of the line mkd. by Hales).
Without performing a survey it would not be practical to distinguish if an intersection point could be determined from the found blazed lines.
Bearing Tree tags with no info. (Name, Date, Bearings or Distances) scribed were found. One tag was found on the 48" Hales BT & faced a South Southwest direction. The other was found on a maple stump (approx. 8 ft. Easterly of Hales Monument) & faced North Northwest.

This is a report only -- No monuments or BTs were set or scribed.

No Orig. evidence of the corner mon. or its accessories could be ascertained at this time.

Sketch - See file for sketch and additional documentation.

1/84

50

1/4 Corner for Sections 26 and 27

Found - 1" I.P. with U.S. GLO brass cap protruding 6" above ground from 1953 resurvey. Cap properly marked.
A 10" hemlock now 18" dia. stump 20" high with a well healed blaze bears N.69°W., 32.3 ft. 1953 dependent re-survey
40" fir, now a 33" dia. stump 7 ft. high with protective alum. sheeting on top and a visible scar showing, bears S.33°E., 24.4' (1953 rec. S.31 1/2°E.)

New BT - 14" hemlock double blazed and scribed "1/4 S27 CS BT" bears S.60 1/2°W., 12.6 ft.

Note: See L.D. Roberts PLS 1039, survey, M 96 - 20 for condition report. Corner is located on a newly logged flat. Reproduction is 3 or 4 yrs. old.

Larry (Ed) Monrean, Deputy
Douglas County Surveyors Office
R. W. Smith, S. J. Flause
January 5, 1984
C.S. 62/16

L.E. Monrean, Deputy
Doug. Co. Surveyors
Randall Smith
Stephen Flause
March 22, 1984
C.S. 62/16

925

Douglas County Surveyor's Record of
Government Corners Renewed

T 20 T. S. R 9 R. W. W. M.

KOKE-CHAPMAN CO., EUGENE, ORE. 21981

L.E. Monrean, Deputy, Doug. Co. Surveyors Office
Randall Smith - Stephen Flause
March 22, 1984
C.S. 62/16

51

1/4 Corner for Sections 23 and 26.
Found - 1954 U.S. GLO brass cap on 1" I.P., protruding 6" above ground
Cap properly marked.
A 63" fir, now a 54" stump 3 ft. high with burnt single blaze and
partial scribing visible, bears N.71°W., 16.0 ft. (1954
record, N.68 1/2°W., 15.8 ft.)
36" fir, now a 30" stump 4 ft. high with burnt single blaze and
scribing visible "4S 26 BT" bears S.15°E., 22.6 ft. (1954 rec.
S.16°E., 23.1 ft.)
New BTs - 5" D. fir double blazed and scribed "1/4 S23 CS BT" bears
N.8 1/2°E., 21.6 ft.
4" D. fir double blazed and scribed "1/4 S26 CS BT" bears
S.79 1/2°W., 23.3 ft.
Note: See also L.D. Roberts LS #1039, survey, M 96 - 20 for condition
report.
Corner lies on steep west slope of a north-south ridge covered with 10-15
year old growth.

2/84
52

1/4 Corner for Secs. 25 and 26
Found - 1954 U.S. GLO properly marked brass cap on 1" I.P. protruding
6" above ground.
36" fir, now a 48" stump 5 ft. high with a burnt single blaze,
bears N.49°W., 16.1 ft. (Rec. N.51°W., 13.2 ft.) Orig. BT.
42" fir now a 57" stump 5 ft. high with a burnt single blaze
bears N.83°E., 30.6 ft. (Rec. 29.7 ft.) Orig. BT.
8" hemlock now a 1 ft. high shattered stump with rotted out blaze
bears S.73 1/2°E., 7.6 ft. (1954 BT.)
A 17" cedar now a 17" diam. 2 ft. high stump with a well headed
double blaze bears N.79°W., 98.5 ft. Ren. #12
New BTs - 5" D. fir double blazed & scribed "1/4 S26 CS BT" bears S.5° W.,
18.3 ft.
6" D. fir double blazed and scribed "1/4 S25 CS BT" bears
N.30°E., 34.7 ft.
Note: See also L.D. Roberts LS #1039 survey, M96 - 20, for condition
report.
This corner lies along gentle southeast slope covered with 10-15 year old
reproduction.

3/84

1/4 Corner for Sections 35 and 36
No evidence found of brass cap or BTs set by GLO in 1954. Corner
falls in steep and narrow creek bottom. Creek has been torn up by old
logging.
Set - 2" x 36" alum. pipe and cap by proportionate measure. Buried
purple magnetic marker under cap. Cap stamped T20S R9W 1/4 Cor
S35 + S36 1984 P.L.S. 1039.
Set - 2" x 36" alum. pipe and cap for witness corner. W.C. bears
N.2°01'02" E., 30.0 ft. from 1/4 cor. Buried purple mag-
netic marker under 36" alum. pipe. Cap stamped "T20S
R9W W.C. S35 + S36 1984 P.L.S. 1039".
New BT - 8" alder, N.54°E., 20.0 ft. Bark scribed/painted brass washer
Set metal fence post beside brass cap. Wired survey monument sign to
fence post. Corner lies 8 ft. south of 2 ft. creek in steep narrow canyon.

53

South 1/4 Corner for Sec. 35 only.
CORNER REPORT ONLY.
Found - 1954 GLO brass cap, properly marked, set firmly in ground.
1954 BTs gone.
17" maple stump, N.58°W., 26.6 ft. (no marks) (1966 rec. N.58 1/4°
W., 25.7 ft.
63" fir stump bears N.62°E., 78.5 ft. (scribe vis.) 1966 BT. Rec.
N.62°E., 79.2 ft.
42" cedar snag, S.35°W., 25.6 ft. (no marks) International Paper
Location tag nail to snag. No Record.
Set - Metal fence post beside brass cap. Wired survey attention sign
to fence post.
Corner lies on top of narrow ridge. Ridge runs N.45°E. and S.45°W. Corner
is in stand of 15-20 year old reproduction.

RE-RENEWED CORNER NO. # 56

Les Roberts PLS #1039
For: International Paper Company
March, 1984
M 96 - 26 - C.S. 58/280

Douglas County Surveyor's Record of
Government Corners Renewed

T. 20 S. T. S. R. 9 W. R. W. W. M.

ROBE-CHAPMAN CO., EUGENE, ORE. 97401

55

SE Corner of Sec. 35.
Found - 1954 GLO BC, properly mkd., on a 2" I.P. protruding 12" above grnd.
BTs - Orig. 36", now 38" burned & rotted fir stump bears N.82°E.,
153.5-ft. per M 96-26. (Rec. N.81-1/2°E., 153.1-ft.-1967BLM Resurvey)
Orig. 36", now 45", 4-ft. high fir stump with a burned out center
bears S.81°E., 118.0-ft. per M 96-26. (Rec. S.81-1/2°E., 116.8-ft.-
-1967 B.L.M. Resurvey).

No other orig. evidence found.

1954 B.L.M. BT, a 12", now 13" hemlock stump, 1-1/2-ft. high,
w/partial scribing visible bears N.14°W., 8.8-ft. per M 96-26
(Rec. N.18°W., 9.2-ft. per 1967 BLM Resurvey).

1954 B.L.M. BT, a 14", now 18" hemlock stump, 1-ft. high, with
downed BT, with scribing visible: "T20S R9W", bears N.55°E.,
22.1-ft. per M 96-26. (Rec. N.53-1/2°E., 21.8-ft. per 1967
B.L.M. Resurvey).

New BTs- 7" D.Fir dbl.blazed & scribed: "T20S R9W S36 CSBT" bears
N.84-1/2°E., 22.8-ft.

5" D.Fir dbl.blazed & scribed: "T20S R9W S35 CSBT" bears
N.21°W., 32.1-ft.

Note - See file for sketch.

4/84

56

South 1/4 Section Corner for Sec. 35 only.

Found - 1954 GLO BC, properly mkd., on a 1" I.P. protruding 4" above grnd.
NO Orig. evidence found.

NO evidence of 1954 Resurvey found.

SEE ALSO # 54

BTs - a 1967 BLM Resurvey BT, 67", now a 63", 3-ft. high fir stump
with scribing visible: "1/4 S35 BT", bears N.65°E., 78.5-ft.
(Rec. N.62°E., 79.2-ft.).

a 1967 BLM Resurvey BT, 20", now a 17", 4-ft. high maple stump,
bears N.58°W., 26.6-ft. per M 96-26 (Rec. N.58-1/4°W., 25.7-ft.

New BTs- 6" D.Fir dbl.blazed & scribed: "1/4 S35 CSBT" bears N.71-1/2°E.,
7.1-ft.

4" D.Fir dbl.blazed & scribed: "X BT" bears N.21°W., 5.9-ft.

Note - See file for sketch.

4/84

57

Center 1/4 Corner for Section 34.

Set - 3 1/2" brass cap in drill hole in solid rock. Cap stamped with
S-T-R, date and PLS #1039.

New BTs-23" hemlock, N.47°W., 31.0 ft., scribed/painted red/brass washer.

New Accessories:

R.R. spike in side of 24" fir stump, S.01°W., 17.1 ft. to spike.

Metal fence post beside alum. cap. Wired land survey monument to
fence post.

Corner lies on NE slope about 70 ft. east of ridge. Ridge bears N.10°W.

Corner is also about 140 ft. west of small creek. Creek bears N.10°W.

58

1/4 Corner for Sections 1 and 12.

Found : A 1" pipe with B.L.M. cap marked "T20S R9W, 1/4 S1, S12, 1954.

BT's : A 22" Fir snag bears N 37°W, 6.7 ft.

21" Fir snag bears S 16°W, 23.5 ft. With bark scribing and tag.

New BT's : 8" Douglas Fir bears N5°E, 14.0 ft. Scribed "1/4 S1 BT".

8" Douglas Fir bears S8°E, 3.1 ft. Scribed "1/4 S12 BT".

Note : Set a 6' Aluminum post with attention sign next to monument.

59

1/4 Section Corner for Sections 12 and 13.

Found : A Standard B.L.M. 2 1/2" Dia. cap on pipe. B.L.M. Survey in
1954.

BT's : A 26" Cedar stump bears N61°E, 15.46 ft. with visible scribing
" 1/4 BT".

Other stump not looked for.

New BT's: A 24" Fir stump bears N/1°W, 24.80 ft. With tag attached.

48" x 6" high stump bears S74°W, 57.31 ft. With spike
nail and L.S. cap in center top of stump.

Note; Monument lies 100 ft. ± East of creek.

Larry (Ed) Monrean, L.S. #1830
Deputy County Surveyors Office
Randall W. Smith
Stephen Flause
April 4, 1984
C.S. 62/18

Les Roberts LS 1039
For: International
Paper Co.
March 21, 1984
M 90- 53

BY FDOK
Don Wayne
5/19/83
C.S. 63/153

Donald Branch
International Paper Co
2-3-87
M 101 - 14
C.S. 63/48

**Douglas County Surveyor's Record of
Government Corners Renewed**

T20S T. S. R 9 W R.W.W.M.

MOORE-CHAPMAN CO., EUGENE, ORE. 21881

Donald Branch
International Paper
Co.
2-3-87
M101 - 14
C.S. 63-48

1/4 Corner for Section 12 only. 60
 Found : A 1" Pipe with 2" BLM Cap buried 6" in the ground marked
 "T20S R9W | R8W, 1/4 S12 | 1954. Set Witness post with attention
 BT's : A 16" Hemlock (down) bears S 74°W, 21'± to hole. With blaze and
 BT tag.
 50" Fir bears N41 1/2°W, 19.7 ft. With signs.
 New BT's: 8" Hemlock bears S5°E, 16.0 ft. Scribed "1/4 S7 BT".
 Note : Monument is at toe of fill of road 50' West .

1/4 Corner for Sections 26 and 35 61
 (Note: Corner previously referenced out Aug. 21, 1985. See C.S. 63/50
 for reference notes.)
 CORNER REPORT
 Found - 1953 GLO brass cap pulled out of ground by recent logging activity
 24" Fir stump, S.36°W., 8.0 ft. 1953 BT. (Rec. S.36 3/4°W., 7.9 ft.)
 38" Fir stump, N.45°E., 6.1 ft. 1953 BT. (Rec. N.45 1/2°E., 5.9 ft.)
 Set - Re-set 1953 GLO brass cap firmly in ground using "P.K." nails set
 in 8/21/85. Buried purple magnetic marker under iron pipe.
 Set metal fence post, with survey attention sign wired to, beside
 brass cap. Painted BT stumps red.
 No new accessories. Corner lies on flat ground about 150 ft. North of
 Smith River Road.

9/14/87

62

1/4 Corner for Sections 29 and 30.
 (Note: Corner previously reference out Aug. 21, 1985. See C.S. 63/50 for
 reference notes.)
 CORNER REPORT
 Found - 1953 GLO brass cap bent over from recent logging activity.
 60" Fir stump, N.43°W., 60.5 ft. (no marks) 1877 BT(record
 N.44 1/2°W., 58.1 ft.)
 20" maple, S.39°E., 22.1 ft. (scar visible) 1953 BT.(record
 S.36°E., 23.1 ft.)
 24" maple, N.53°W., 60.4 ft. (scribe vis.) 1953 BT. Rec. N.53°W.,
 59.4 ft.)
 24" cedar, S.05°W., 34.0 ft. to 6" spike in base. 8/21/85 R.P.
 40" maple, N.74°W., 68.6 ft. to 6" spike in base. 8/21/85 R.P.
 Set - RE-set 1953 GLO brass cap firmly in ground using distances of
 34 ft. and 68.6 ft. from 6" spikes set in 8/21/85. Buried
 purple magnetic ;marker under iron pipe.
 Set alum. fence post,with land survey monument sign attached to,
 beside brass cap. Painted all BTs red.

New Accessories:

Drove 6" spikes into base of 1953 GLO bearing trees.
 20" maple S.39°E., 21.8 ft. to 6" spike.
 24" maple, N.53°W., 61.2 ft. to 6" spike.

Corner lies about 150 ft. North of Bear Creek and about 30 ft. East of
 small side creek.

9/14/87

63

Reference Monument to SW Corner Section 28.
 (Note: Corner previously referenced out Nov. 4, 1985. See C.S. 63/50
 for reference notes.)

CORNER REPORT

Found - NE Reference monument has been up-rooted by recent logging
 activity.
 1953 GLO brass cap R.M. bears S.44° 53' 45" W., 59.04 ft.
 37" Fir, S.49 1/2°W., 54.5 ft. (scar vis.) 1953 BT. Rec. S.50°W.,
 54.8 ft.
 40" Fir stump, N.06°W., 115.5 ft. (scar vis.) 1953 BT. Rec.
 N.13 3/4°W., 115.5 ft.
 49" fir stump, S.73 1/2°E., 70.0 ft. scar vis., 1953 BT. Rec. S.73 1/2°E.
 70.0 ft.)
 49" fir stump, N.84 1/2°E., 84.7 ft. scar vis. No record.
 54" fir stump, N.44 1/2°E., 80.4 ft. 1953 BT. Rec. N.44 1/4°E., 80.5 ft.
 Set - Re-set N.E. reference monument using "P.K." nail R.P.'s set on
 11/4/85. Buried purple magnetic marker under iron pipe.
 Set metal fence post, with land survey monument sign attached to,
 beside brass cap.

9/14/87

Les Roberts, L. S. No. 1039
 November 14, 1987
 C.S. 63/50

Douglas County Surveyor's Record of
Government Corners Renewed

T 20 T. S. R 9 R. W. W. M.

HOKE-CHAPMAN CO., EUGENE, ORE. 91881

Les Roberts
L.S. # 1039
November 26, 1986
C.S. 63/50

West 1/4 Corner for Section 27

64

CORNER REPORT

Found - 1953 GLO survey brass cap up-rooted by recent logging.
32" maple stump, S.46°E., 21.3 ft. (scar vis.) 1953 BT.
(Rec. S.43½°E., 19.8 ft.)
48" cedar stump, N.46°W., 22.7 ft. (no marks) 1953 BT.
(Record N.46°W., 21.8 ft.)
8" spike in top of 48" cedar stump, N.45°W., 21.3 ft. to spike.
8" spike in side of 18" maple stump, S.79°E., 36.9 ft. to spike.

Set - Re-set 1953 GLO brass cap firmly in ground using distances of
21.3 ft. and 36.9 ft. from 8" spikes set in 3/13/86. Buried
purple magnetic marker under iron pipe.
Set metal fence post, with survey attention sign wired to,
beside brass cap.

Corner lies on steep East slope about 350 ft. west of West Branch Road
11/26/86

South 1/4 Corner for Section 27

65

CONDITION REPORT

Found - 1953 GLO brass cap bent over from recent logging activity.
50" fir stump, S.59°W., 76.4 ft. (scar vis.) 1953 BT.
(Record, S.59°W., 72.6 ft.)
(NE maple BT set in 1953 is gone. and 6" alder set in 1967 is down.)

Set - Re-set 1953 GLO brass cap firmly in ground using hub and tack
R.P.'s set on 3/13/86. Buried purplemagnetic marker under
iron pipe.
Set metal fence post, with survey attention sign wired to,
beside brass cap.

Corner lies on steep East slope about 50ft. West of Smith River Road.
Corner is also about 500 ft. North of Scare Creek Bridge.

11/26/86

1/4 Corner for Sections 33 and 34

66

Found - 1953 GLO brass cap set firmly in the ground.
53" cedar, N.81°W., 67.9 ft. (no marks), 1877 BT (Rec.
N.80½°W., 66.0 ft.)
10" hemlockstump, N.75°E., 15.5 ft. (scribe vis.) 1953 BT.
(Rec. N.77¼°E., 15.2 ft.)
19" maple, N.74°W., 14.1 ft. (scar vis) 1953 BT. (Rec. N.75 3/4°W.
14.5 ft.)
NE cedar BT set by Theil in 1877 and found in 1953 is gone.

Because of planned logging activity in this area in the near future:
I SET the following R.P.'s:
50" fir stump, S.10°E., 24.15 to 6" steel spike.
20" fir snag, N.77°E., 27.60 ft. to 6" steel spike.
20" maple, N.72°W., 14.50 ft. to 6" steel spike.

Corner lies on west slope in NW corner of old unit. Logging unit is about
15 years old.

10/31/88

Les Roberts
L.S. #1039
Ted Baker
Notekeeper
Oct. 31, 1988
C.S. 63/85

Section corner for Secs. 27, 28, 33 and 34

67

Found - 1953 GLO Brass cap set firmly in the ground.
16" fir, N.14°E., 20.0 ft. (scar vis) 1953 BT (Rec. N.13½°E.19.8')
18" fir, S.51°W., 24.3 ft. (scar vis) 1953 BT (Rec. S.56¼°W.,
25.7 ft.)
24" fir, N.52°W., 18.0 ft. (scar vis.) 1953 BT (Rec. N.51 3/4°W.,
17.8 ft.)
28" fir, S.08°E., (scar vis.) 1953 BT.(Rec. S.10°E., 2.3 ft.)

Because of planned logging activity in this area in the near future
I SET the following R.P.'s:
16" fir, N.26°E., 17.95 ft. to 6" steel spike.
18" fir, S.48°W., 24.30 ft. to 6" steel spike.
28" fir, S.32°E., 1.75 ft. to 6" steel spike.

10/31/88

see the next PG

For 64 A, 65 A, 66 A : 67 A

**Douglas County Surveyor's Record of
Government Corners Renewed**

T. 20 T. S. R 9 R. W. W. M.

KOKE-CHAPMAN CO., EUGENE, ORE. 91881

Robert Ward Jr
L S 1091
For: Siuslaw Nat Forest
June 1991
M 113 - 37 A & B

Section Corner for Sections 31 & 32 only. 64
A
Fnd. - 1921 G L O. brass cap attached to a badly rusted iron pipe.
17" Fir bears N.21°E., 20 4 ft. (healed face)
Set - U.S F S. alum corner monument stamped "T19S R9W S31 S32 T20S R9W S6
L.S. 1091 1991"
New BTs-23" Fir bears S34°E., 29.1 ft. (scribed "T20S R9W S6 BT")
15" Maple bears S.16°W., 7.9 ft. (bark scribed "T20S R9WS6 BT")
25" maple bears N 73°W , 26.1 ft (bark scribed "T19S R9WS31 BT")
8/12/91

Robert Ward, Jr
For: International
Paper Co.
2/93
M 116 - 61

C 1/4 Corner Section 31 65
A
Set- 3 1/4" Dia. Aluminum cap on a 3/4" x 36" RLS 1091
aluminum rod. Marked: C1/4 * S 31
New BTs-31" Hemlock S46°E 44.9'. 1993
32" Hemlock N2°W 23.1'.
32" Hemlock N32°W 50.7'.
44" Hemlock N86°W 21.4'.
Note- All BT's blazed and scribed "C 1/4 S 31 BT" 2/93

1/4 Corner for Sections 31 and 32. 66
A
Fnd: 2 1/2" BLM Brass cap with the following accessories,
33" Fir N58°W 14.8'.
21" fir stump N29°E 5.7'.
New BTs-30" Fir N5°E , 35'. Blazed and scribed "1/4 S32 BT"
2/93

Section corner for Sections 31 & 32 T. 20 S. R. 9 W Ren. No. 17 67A
and Sections 5 & 6 T. 21 S. R. 9 W.
Fnd- 2 1/2 BLM Brass cap with the following accessories:
17" Maple N 8°E, 22.1'
11" Maple N 42°W, 22.4'
17" Maple S 47°W, 21.1'
Fir BT is uprooted. (Ren. No. 17)
New BT- 20" Alder S 30°E 30.8'. Barkscribed "T21S R9W S5 BT" 2/93

Les Roberts
For: International
Paper Co.
March 1993
CS 63/149
M 116 - 60

West 1/4 Corner Section 30, T. 20 S. R 8 W. only. 68
Found- 1950 G.L.O. Brass cap set firmly in the ground and marked "W.C. S 1/2
S30". True corner bears N 1° 27'E, 7.26'. At true corner I find
a 14" rotted fir stub, no marks visible.
New Accessories -
8" Fir, N 76°E, 5.4' (Scribed "W.C. 1/2 S B.T.")
8" Fir, S 03°W, 9.1' (Scribed "W.C. 1/2 S B.T.")
72" aluminum post, with land survey monument sign attached to,
beside brass cap. Painted all bearing trees red.
Note - Also found 2 bearing trees for true 1/2 corner.
14" Fir Stump, S 85°E, 14.5' (No marks), 1883 BT. Rec. S 85 1/2°E 13.9'
18" Fir Stump, N 33°E, 23.9' (Scar vis.), 1950 BT. Rec. N 33°E
25.7'. 3/93

East 1/4 Corner Section 25 only 69
Found - 22" Fir, N 85°W, 15.8' (Scar vis), 1954 BT. Record N 85 3/4°W,
15.8'.
28" Fir, S 12°W, 6.6' (Scar Vis), 1954 BT. Record S 13°W, 6.6'
See also Vol. 43 Pg 16710 for B.L.M. renewal.
Set - 72" aluminum post, with land monument survey sign atted to,
beside brass cap.
Note - Corner lies on West slope about 50' South of the N.W. corner
of Section 30. 3/93

N.W. Corner Section 30 T. 20 S. R. 8 W. only 70
Found - 1950 G.L.O. Brass Cap set firmly in the ground.
20" Fir, S 58°E, 16.5' (scar vis.), 1950 BT. Record S 58°E, 16.5'.
39" Fir, N 47°E, 19.8' (scar vis.), 1950 BT. Record N 47 1/2°E, 19.8'.
See also Vol. 43, Pg 16711 for B.L.M. Renewal.
Set - 72" aluminum post, with land monument survey sign attached to, beside
brass cap. Painted all bearing trees red.
Note - Corner lies on West slope about 200' South of creek. Creek flows
West. 3/93

Douglas County Surveyor's Record of
Government Corners Renewed

T 20 T. S. 9W R. W. W. M.

FOKE-CHAPMAN CO., EUGENE, ORE. 31881

71

North $\frac{1}{4}$ Cor. Sec. 1

Found - 1953 G.L.O. Brass cap in good condition.
2 $\frac{1}{2}$ " brass cap bears N.89°12'50"W., 81.75' - ($\frac{1}{4}$ cor. secs. 36.)
22" Fir, stump bears S.55 $\frac{1}{2}$ °E., 37.8', visible scribing.
20" Fir, stump bears S.69°W., 27.4', healed face.

New BTs -

17" Fir, bears S.22 $\frac{1}{2}$ °W., 53.8', blazed & scribed " $\frac{1}{4}$ S1 BT"
10" Fir, bears S.43 $\frac{3}{4}$ °E., 15.6', blazed & scribed " $\frac{1}{4}$ S1 BT"

Note - Corner lies on a gradual NW slope.

-- -- -- -- --

NW Cor. Sec. 6 T20-8; SW Cor. Sec. 31 T19-8

72

Found - 3 $\frac{1}{2}$ " Brass cap in good condition.

30" Fir, bears S.20°E., 57.1', healed face.
51" Hemlock, bears S.82 $\frac{1}{2}$ °W., 24.3', healed face.
46" Fir stump, bears N.53 $\frac{1}{2}$ °W., 49.4', no marks.
31" Cedar, bears N.3 $\frac{3}{4}$ °E., 54.2', healed face.

New BT- 15" Hemlock, bears S.84 $\frac{1}{2}$ °E., 41.6', blazed & scribed
"T20S R8W S6 BT"

Note - Corner lies on a North facing bench.

-- -- -- -- --

73

Wayne Donovan
L.S. #2553
5/19/93
C.S. File 63/153