


T. 20 S., R. 9 W.

CORNERS RENEWED BY
BUREAU OF LAND MANAGEMENT -----◆-----
COUNTY SURVEYOR'S OFFICE -----○-----
PRIVATE SURVEYORS -----○-----
CORNERS FOUND AND USED -----■-----
CORNERS LOOKED FOR AND NOT FOUND -----●-----

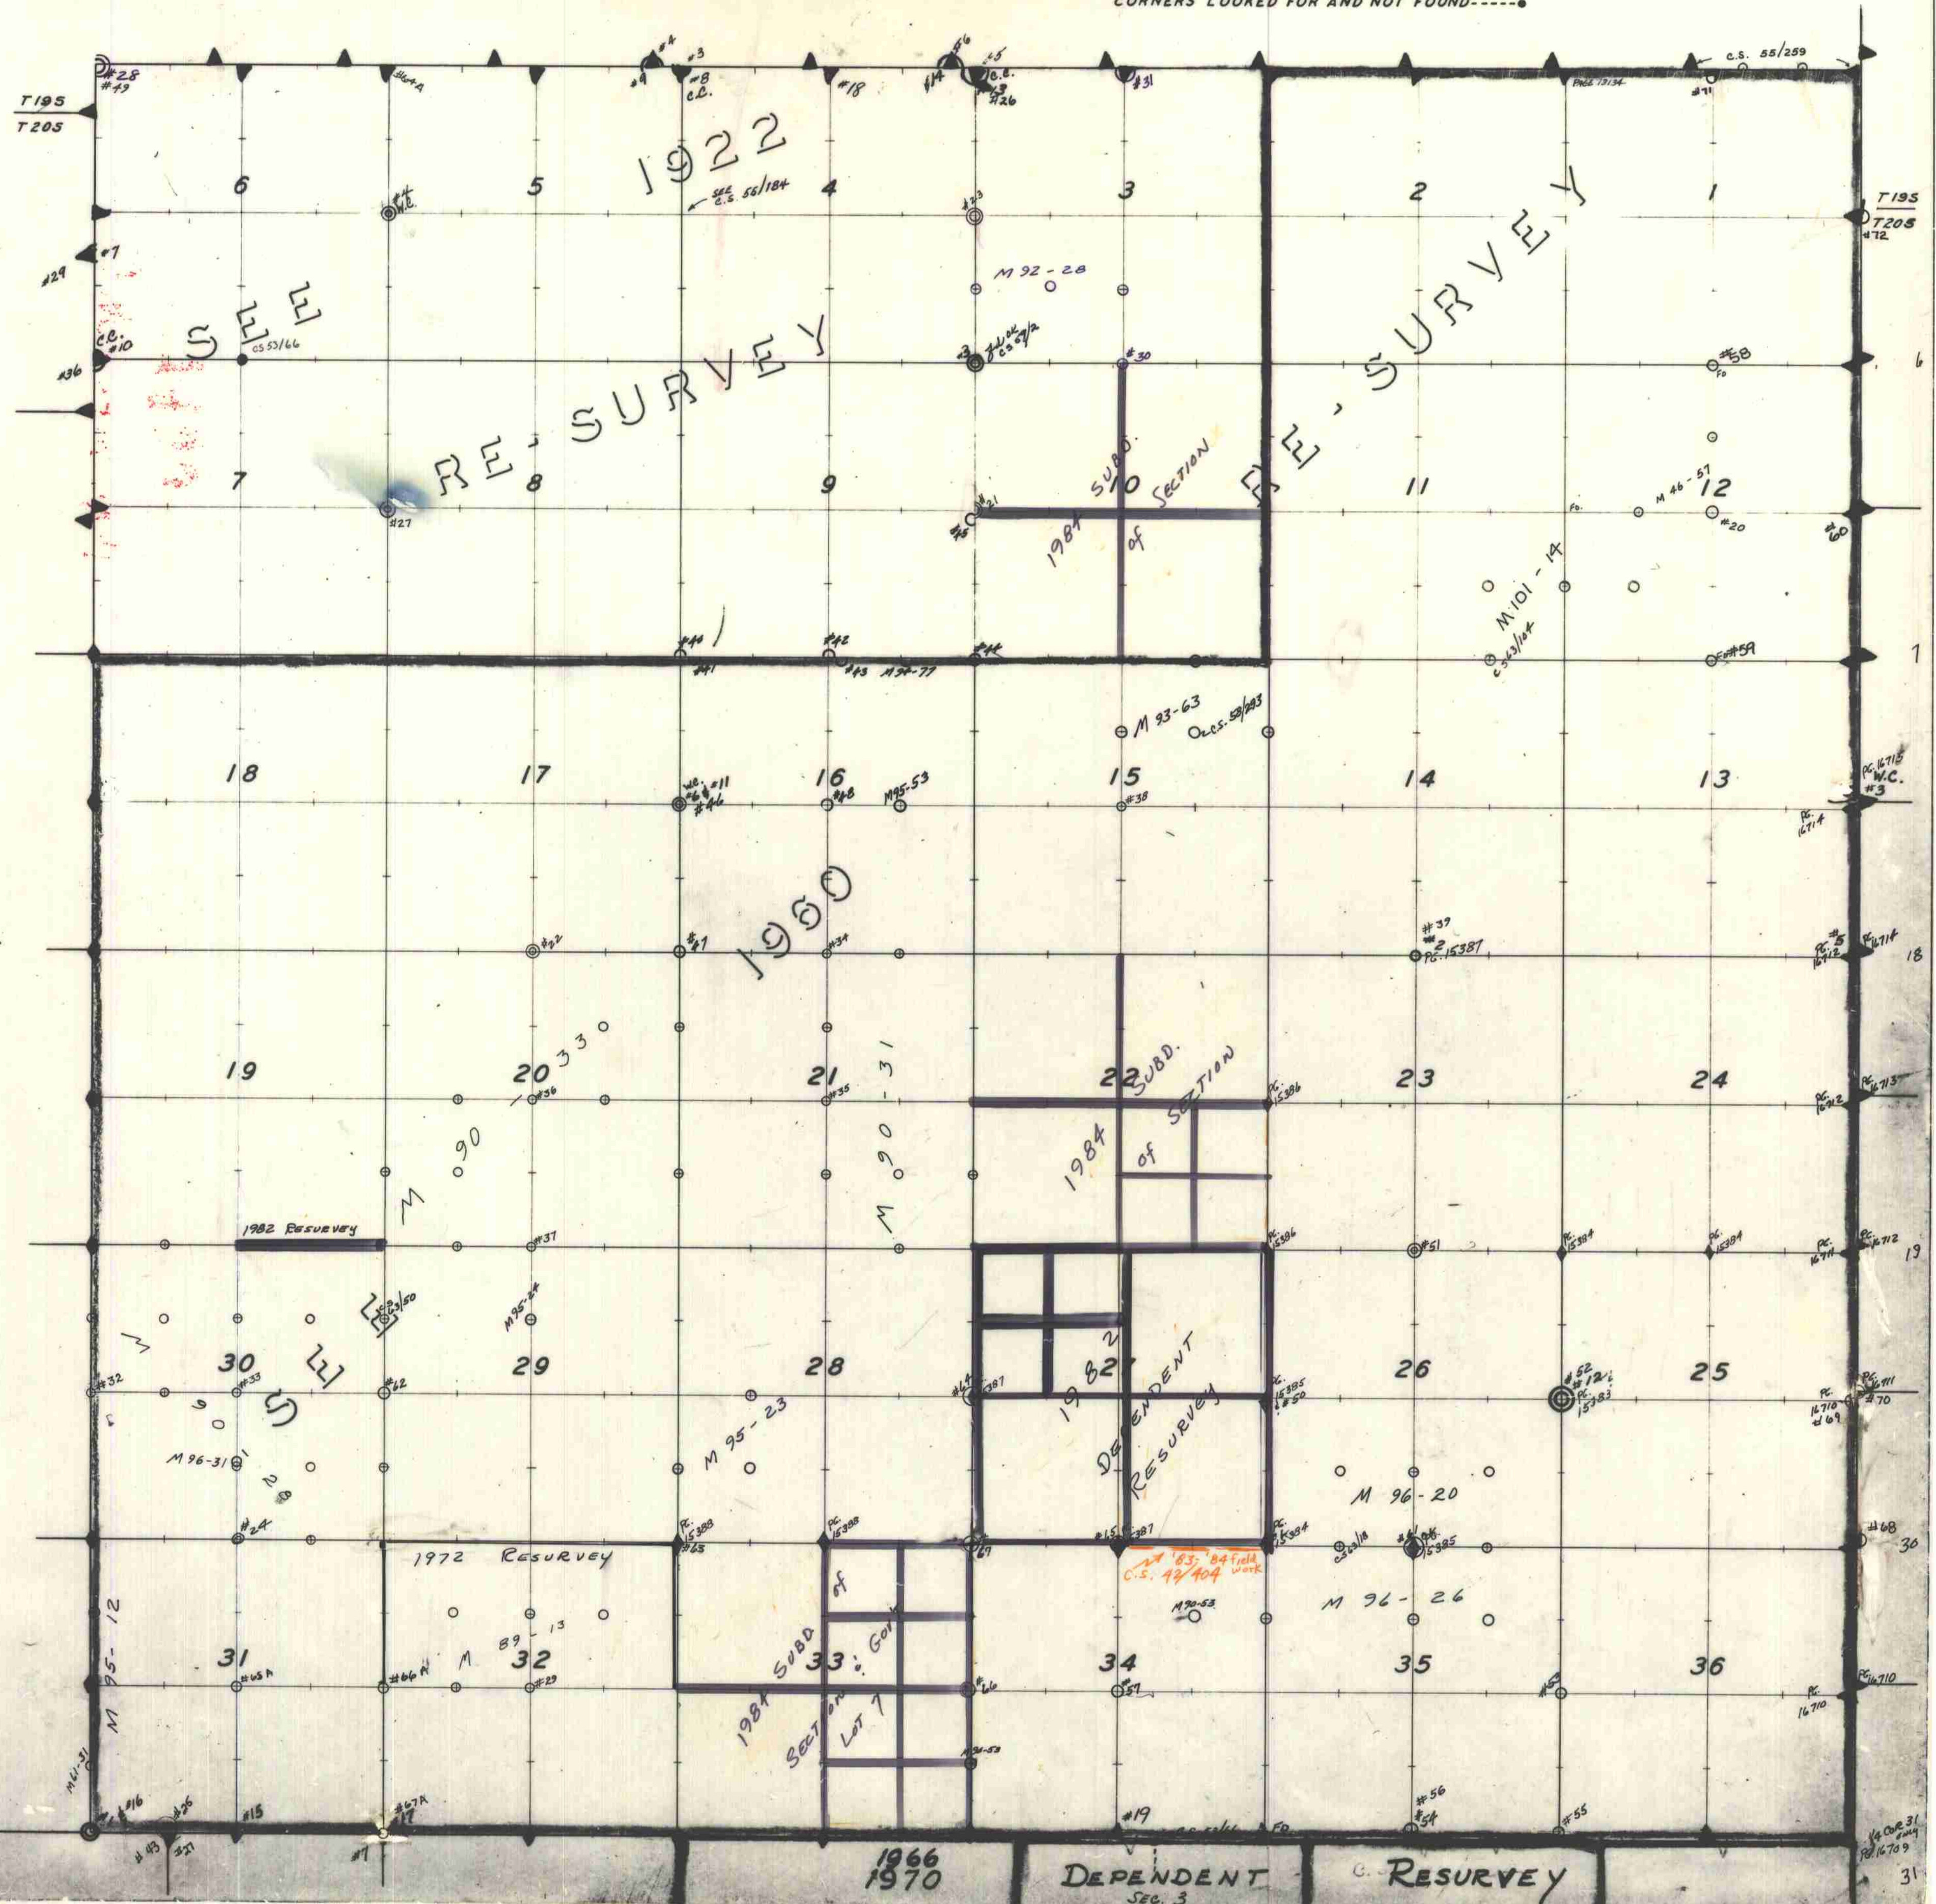

SEE

RE SURVEY

1922

1966

1982 RESURVEY

1984 SUBD. of SECTION 22

1982 DEPENDENT RESURVEY

1972 RESURVEY

1984 SUBD. of SECTION 33

1966 1970

DEPENDENT RESURVEY

RESURVEY