


Douglas County Surveyor's Record of
Government Corners Renewed

21 T. S. 4 R. W. W. M.

KOKE-CHAPMAN CO., EUGENE, ORE. 21881

$\frac{1}{4}$ Section Corner to Sections 6, T21-4 W. & Sec. 1, T21-5W. **39**
Found - Orig. 36", now 60" Cedar, shows good scribing on old face.
Orig. 12", now mostly rotted Fir Stump. We do find good scribing near base "T".
Richardson's BT's recorded but do not find auto spring set for corner.
We find BT's thus:

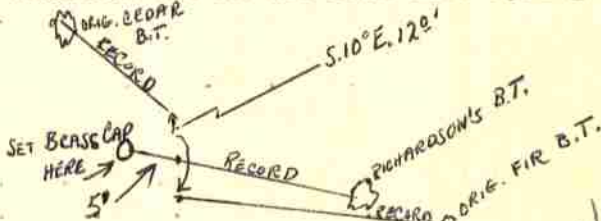

Set Brass Cap at Corner Mkd: County Surveyor's Office, 1961
 $\frac{1}{4}$ R5W S1/S6 R4W T21S
New BT: 12" W. Fir bears N. 38° W. 17.2 ft. scribed $\frac{1}{4}$ S1 CS BT.
Dec. 1968 - FOUND O.K. V.R.T.

Section Corner to Secs. 6 & 7, T21-4W. & Secs. 1 & 12, T21-5W. **40**
Found - Orig. 18", now 44" Fir Stump N. 84 $\frac{1}{2}$ ° W. 89.1 ft. We open & find good scribe marks.
Orig. NE. BT. down. SE & SW BT's. not found.
Set Brass Cap Mkd: S 1 | S 6 County Surveyor's Office, 1961
R5W S12 | S 7 T21S R4W
New BT's: 5" R. Fir N. 58 $\frac{1}{2}$ ° E. 54.0 ft. scribed S 6 CS BT.
5" Chinqn. S. 61° E. 26.6 ft. scribed S 7 CS BT.
10" R. Fir bears S. 43 $\frac{1}{2}$ ° W. 42.4 ft. scribed S12 T21S R5W CSBT.
8" R. Fir bears N. 40 $\frac{1}{2}$ ° W. 53.1 ft. scribed S 1 T21S R5W

$\frac{1}{4}$ Section Corner to Sections 19 and 18. **41**
Found - $\frac{3}{4}$ " Iron Peg by old squared Post, scribed " $\frac{1}{4}$ S" & from which:
48" D. Fir Stp. bears N. 30° E. 24.0 ft. scribed:
" $\frac{1}{4}$ S S18 RS", probably scribed by Thiel about 30 years ago, Probable face is near center, which is rotted of the stump.
As this peg is near where the computed $\frac{1}{4}$ corner should be, I set a 1" x 30" Alum. Pipe over the Iron Peg & from which:
11" D. Fir bears S. 45° W. 50.5 ft. scribed " $\frac{1}{4}$ S BT".
12" D. Fir bears N. 72° E. 37.6 ft. scribed " $\frac{1}{4}$ S BT".

$\frac{1}{4}$ Sec. Cor. to Sec. 19, T21-4W. & Sec. 24, T21-5W. **42**
No valid evidence found except for very old fenceline going due E. from computed corner. The fences going Nrthy & W'ly. are random. Valid bearing trees were non-existent.
Set - 1" x 36" Steel Pipe 1 ft. below top of field, from which:
6" D. Fir bears S. 88° E. 31.8 ft. scribed " $\frac{1}{4}$ S BT".
9" D. Fir bears S. 34° W. 65.3 ft. scribed " $\frac{1}{4}$ S BT".
Also, the pipe is approximately 30 ft. West & 5 ft. N. of corner of the field.
FND OK 7/92 BY FINDORFF 1993-0016

Center $\frac{1}{4}$ of Section 19. **43**
Set a 1" x 30" Alum. Pipe, from which a:
10" D. Fir bears S. 47° W. 102.9 ft., scribed "C $\frac{1}{4}$ BT".
48" D. Fir Stp. bears S. 87° W. 66.4 ft., scribed "C $\frac{1}{4}$ BT".
26" D. Fir bears S. 84° E. 55.7 ft., scribed "C $\frac{1}{4}$ BT".

$\frac{1}{4}$ Corner to Sections 19 and 20. **44**
No evidence found.
Set - 5/8" x 30" Iron Bar, from which a:
14" Red Cedar bears due E, 35.1 ft.
22" D. Fir bears N. 37° W, 35.0 ft. (both scribed " $\frac{1}{4}$ S BT")

James W. Hyron, Deputy County Surveyor
Clete Putnam
June 21, 1961
G. S. File No. 49/68

Bruce A. Shaner
For Lee Kruse & Weyerhaeuser Co.
February 1962
Map File RM 2 - 17

Fd. # 215ed
6/90
M110-25

Fd. 6/90
M110-29

Fd. 6/90
M110-29

FOOK PER GOILE
NOV. 1986 M103-9

RE-FILED

SEE ALSO: Vol. 1 Pg 192 #135

Fd. OK 1/4/89
L. Roberts
C.S. 63185