


T. 21 S., R. 4 W.

CORNERS RENEWED BY
 BUREAU OF LAND MANAGEMENT-----
 COUNTY SURVEYOR'S OFFICE-----
 PRIVATE SURVEYORS-----
 CORNERS FOUND AND USED-----
 CORNERS LOOKED FOR AND NOT FOUND-----
 DATA BY LANE COUNTY SURVEYOR-----*

1970 RESURVEY

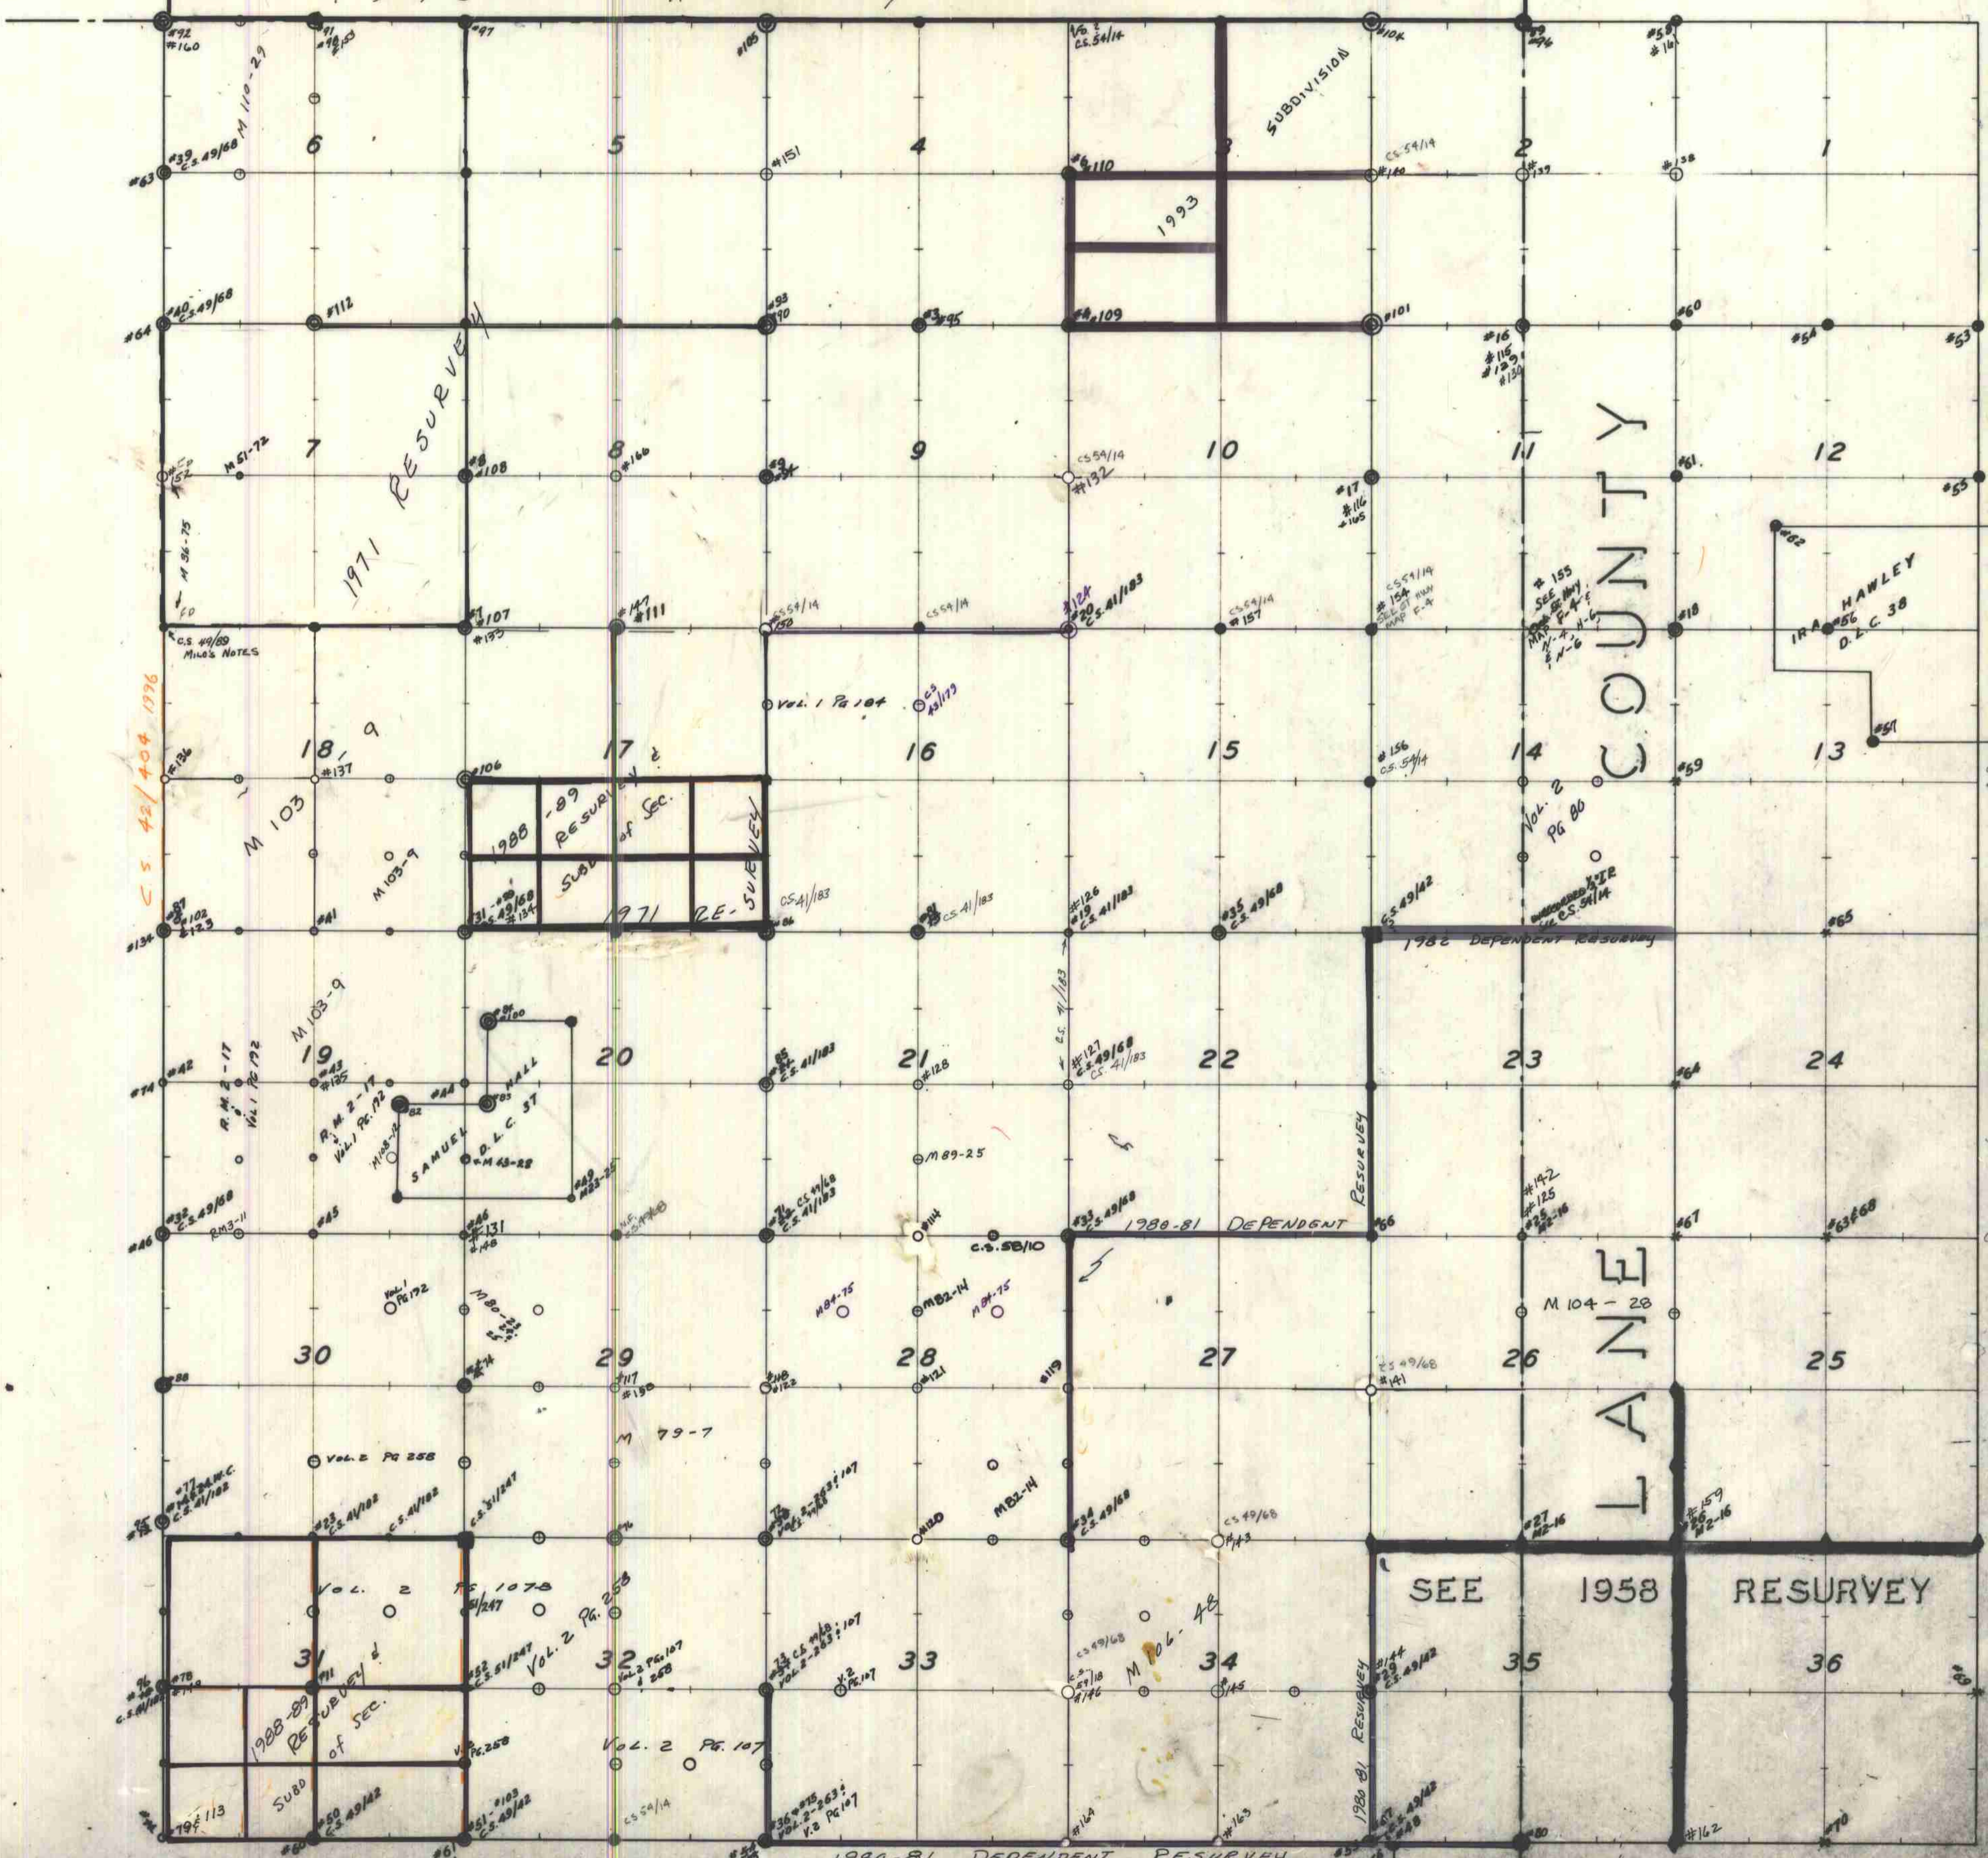

C.S. 42/404 1996

1988-89 RESURVEY of Sec.

1988-89 RESURVEY of Sec.

1980-81 DEPENDENT RESURVEY C.S. 42/404

SEE 1958 RESURVEY

HAWLEY D.L.C. 38