

Douglas County Surveyor's Record of  
Government Corners Renewed

21 T. S. 5 R. W. W. M.

ROKE-CHAPMAN CO., EUGENE, ORE. 21887

50

By Wilford N.  
Haines  
For Keith  
Roberts.  
April 1959  
C.S. File No.  
51/14

1/4 Section Corner to Sections 33 & 34.  
Found Stump of 12" Fir N.62°W. 49.7 ft.  
Rock & 12" Oak has been destroyed by Road Construction. - Ren. No. 4  
Set Lot Marker 1" x 1" x 36" T. Irons with Cap inscribed  
"Wilford N. Haines #239 - Survey Point", N.62°W. 10.0 ft. 101  
from 1/4 Corner.

51

By Arthur  
R. Evans  
C.S. File  
No. 40/389  
M 14-50

1/4 Section Corner to Sections 26 & 27.  
Found Axle & Old Scribed Stake.  
Also Old B.T. - N.71°W. 91.0 ft. 36" Fir  
New BT. - N.10°E. 13.8 ft. - Blazed & Scribed.

Nov. 1951

52

Renewed Corner 

S36	S31	T21S
S 1	S 6	T22S


  
R6W R5W.

Found - Orig. 20", now 40" W. Oak S.7 1/2°E. 95.7 ft., shows good scar, I do not open.  
Orig. 24", now 40" Oak Stump S.13°W. 138.6 ft., I open near base & find good scribe marks "D 1".  
I also find Stone with + on top at Corner set by Haines, 1943.

New BT's:

40" R. Fir bears S.21°E. 31.0 ft. scribed S 6 T22S R5W CS BT.  
8" R. Fir bears N.72°E. 56.0 ft. scribed S31 T21S R5W CS BT.  
10" B. Oak bears S.28°W. 18.8 ft. scribed S 1 T22S R6W CS BT.  
8" W. Oak bears N. 2°W. 10.0 ft. scribed S36 T21S R6W CS BT.

RE-RENEWED SEE CORNER NO. # 180

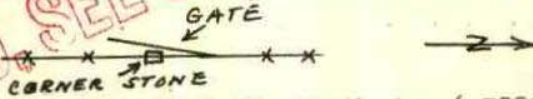

53

Section Corner, Secs. 32 & 33, T21S R5W, & Secs. 4 & 5, T22S R5W.  
Found - 12", now 40" Fir N.42°E. 11.2 ft., shows good scar, I do not open.

Remains of rotted Stump, checks bearing & distance for Original N.W. BT.

Fir Snag, previously opened, shows good scribing, B. 50 1/2°W. 89.0 ft. (Cole). # 189

Cole's N.69°E. 58.0 ft. BT., previously opened. - Ren. # 1

I find 1" Iron Pipe at Corner driven in, 1 1/2" Iron Pipe Set by Cole.  
I do not set Brass Cap at Corner.

New BT's: 9" R. Fir bears N.51°W. 18.0 ft. scribed T21S R5W S32 CS BT.  
6" R. Fir bears S.38 1/2°W. 39.5 ft. scribed T22S R5W S5 CS BT.  
8" R. Fir bears S.20°E. 31.0 ft. scribed T22S R5W S4 CS BT.

1/4 Section Corner to Sec. 32, T21S R5W, & Sec. 5, T22S R5W.  
Found - No Original BT's.

Both of Theil's BT's: 20", now mostly rotted Chinquipin Stump, good scribing "BT", fd. S.11°E. 29.7 ft.

14", now 30" Fir Stump, checks bearing & distance for N.W. BT. # 188

Set Brass Cap at Corner at County Surveyor's Office, 1959

New BT's: 

S32	T21S
S 5	T22S R5W

  
38" R. Fir bears N. 7°E. 19.4 ft. scribed 1/4 S32 CS BT.  
17" Laurel " S.54 1/2°E. 44.2 ft. scribed 1/4 S 5 CS BT.  
13" R. Fir bears S.71 1/2°E. 70.3 ft. scribed 1/4 S 5 CS BT.

FD. & USED BY PEEL 2/92 M 114-60 FD OK - M121-24 - 11/10/99

FD. B.C.  
8/84  
F. I. WILLIAMS  
1197-48

M. Godfrey & S. Hilow  
For W. E. Clevenger  
June 19, 1959  
C. S. File No. 49/158  
M 15 - 18

James W. Byron, deputy county surveyor  
Milo Godfrey  
Clete Putnam  
August 19, 1959  
C. S. File No. 49/59