

Douglas County Surveyor's Record of  
Government Corners Renewed

21 T.S. 5 R.W.W.M.

HOKE-CHAPMAN CO., EUGENE, ORE. 97101


Lester E. Calder  
For Weyerhaeuser Company  
Dec. 1, 1960  
C. S. File No. 51/147

62  
Corner Common to Secs. 33 & 34-T21S-5W & Secs. 3 & 4-22S-5W  
GLO Survey Record - 1855  
Post, gone - 30" Fir S.23°W. 174 lks. Gone  
36" Fir S.15°E. 256 lks. Gone  
24" Fir N.3½°E. 211 lks. Gone  
20" Fir N.80°W. 309 lks. Now 44" Fir Stump, scribing probably destroyed in logging.  
County Survey Record - 1938 - *Ren # 3*  
2" Iron Pipe - No Trace  
12" Chnqpn N.10°E. 271.5 ft. No Trace  
21" Fir N.40°W. 104.0 ft. Now 24" Fir Stump-scribed "BT"  
44" Fir N.80°W. 205.0 ft. Original BT  
8" Alder S.30°E. 244.7 ft. Now 10" & dead-scribing visible.  
Set 1" x 30" aluminum pipe for corner using the two existing County BT's and the one original GLO BT.  
Referenced by W. Wilt(plates & "W" nails only) Decl. 20°  
6" Fir S.70°E. 82.2 ft.  
4" I.Cedar S.37°E. 36.8 ft.  
4" Fir S.78°W. 44.2 ft.  
24" Fir stp. N.46°W. 104.0 ft (CSBT)

62

63  
¼ Section Cor. to Secs. 1, T21-5W. & Sec. 6, T21-4W.  
Found - Orig. 36", now 60" Cedar, shows good scribing on old face.  
Orig. 12", now mostly rotted Fir Stump. We do find good scribing near base "T".  
Richardson's BT. as recorded but do not find auto spring set for cor.  
We find BT's. thus:

*Fd 6/90  
M110-292  
M110-31*

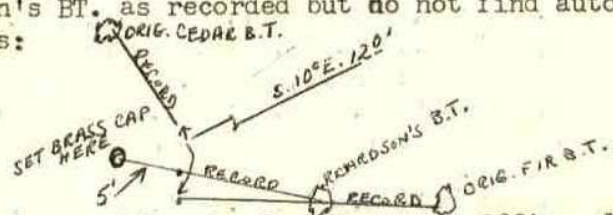

Set Brass Cap at Corner Mkd: County Surveyor's Office, 1961  
¼ R5W S1/S6 R4W T21S  
New BT: 12" W.Fir bears N.38°W. 17.2 ft. scribed ½ S1 CS BT.  
*See Fd. O.K. MAY, 1965 - B.P.R.*

64  
Sec. Cor. to Secs. 1 & 12, T21-5W. & Secs. 6 & 7, T21-4W.  
Found - Orig. 18", now 44" Fir Stump N.84½°W. 89.1 ft. We open & find good scribe marks.  
Orig. N.E. BT. down. SE & SW BT's. not found.  
Set Brass Cap Mkd: R5W S1 | S6 T21S County Surveyor's Office, 1961  
S12 | S7 R4W  
New BT's: 5" R.Fir N.58½°E. 54.0 ft. scribed S 6 CS BT.  
5" Chinquipin S.61°E. 26.6 ft. scribed S 7 CS BT.  
10" R.Fir bears S.43½°W. 42.4 ft. scribed S12 T21S R5W CS BT.  
8" R.Fir bears N.40½°W. 53.1 ft. scribed S 1 T21S R5WCS BT.

*Fd 6/90  
M110-25  
M110-31*

65  
Sec. Cor. Secs. 19 & 30, T21-5W. & Secs. 24-25, T21-6W.  
Found - Fir Snag, now 20", N.41°W. 4.0 ft., cut open & fd. good scribing.  
Fir Snag, now 43", S.15°W. 13.9 ft., No scars or scribing fd.  
No trace found of N. E. Or S. E. Bearing Trees.  
Set - Brass Cap Mkd: County Surveyor's R6W S24 | S19 R5W T21S  
Office, 1961 S25 | S30  
New BT's: 6" D.Fir N.2½°E. 34.0 ft. Mkd: T21S R5W S19 CS BT.  
18" D.Fir S. 3°W. 41.3 ft. Mkd: T21S R6W S25 CS BT.  
20" R.Cedar S.78°E. 68.6 ft. Mkd: T21S R5W S30 CS BT.  
No suitable trees near to N.W.  
"T" Iron & Cap set by Haines bears N. 4°W. 13.6 ft. - *Ren. #25*  
Nov. 2, 1961

66  
¼ Corner to Sec. 31, T21-5W. & Sec. 36, T21-6W.  
Found - W.Oak, now 30", S.51°E. 106.9 ft. Cut open & fd. good scribing.  
W.Oak, Now 24", N.80°W. 70.0 ft., shows 2 good scars. Didn't open.  
Set - Brass Cap Mkd: County Surveyor's Office, 1961 T21S R6 ¼ 36/31 R5W  
N. & S. Fence bears West 3.4 feet.  
New BT's: 6" W.Oak S.63°E. 4.8 ft. Mkd: ¼ S31 CS BT.  
7" W.Oak N.19½°W. 19.2 ft. Mkd: ¼ S36 CS BT.

RE-DEVELOPED CORNER NO. # 191

James W. Byron, Deputy County Surveyor  
Clete Putnam  
June 21, 1961  
C. S. File No. 49/68

Milo E. Godfrey, Deputy  
Vernon Tracy - Clete Putnam  
October & November 1961  
C. S. File No. 49/89