


T. 21 S., R. 10 W.


CORNERS RENEWED BY
 BUREAU OF LAND MANAGEMENT -----◆
 COUNTY SURVEYOR'S OFFICE -----○
 PRIVATE SURVEYORS -----○
 CORNERS FOUND AND USED -----■
 CORNERS LOOKED FOR AND NOT FOUND -----●

060

T21-9

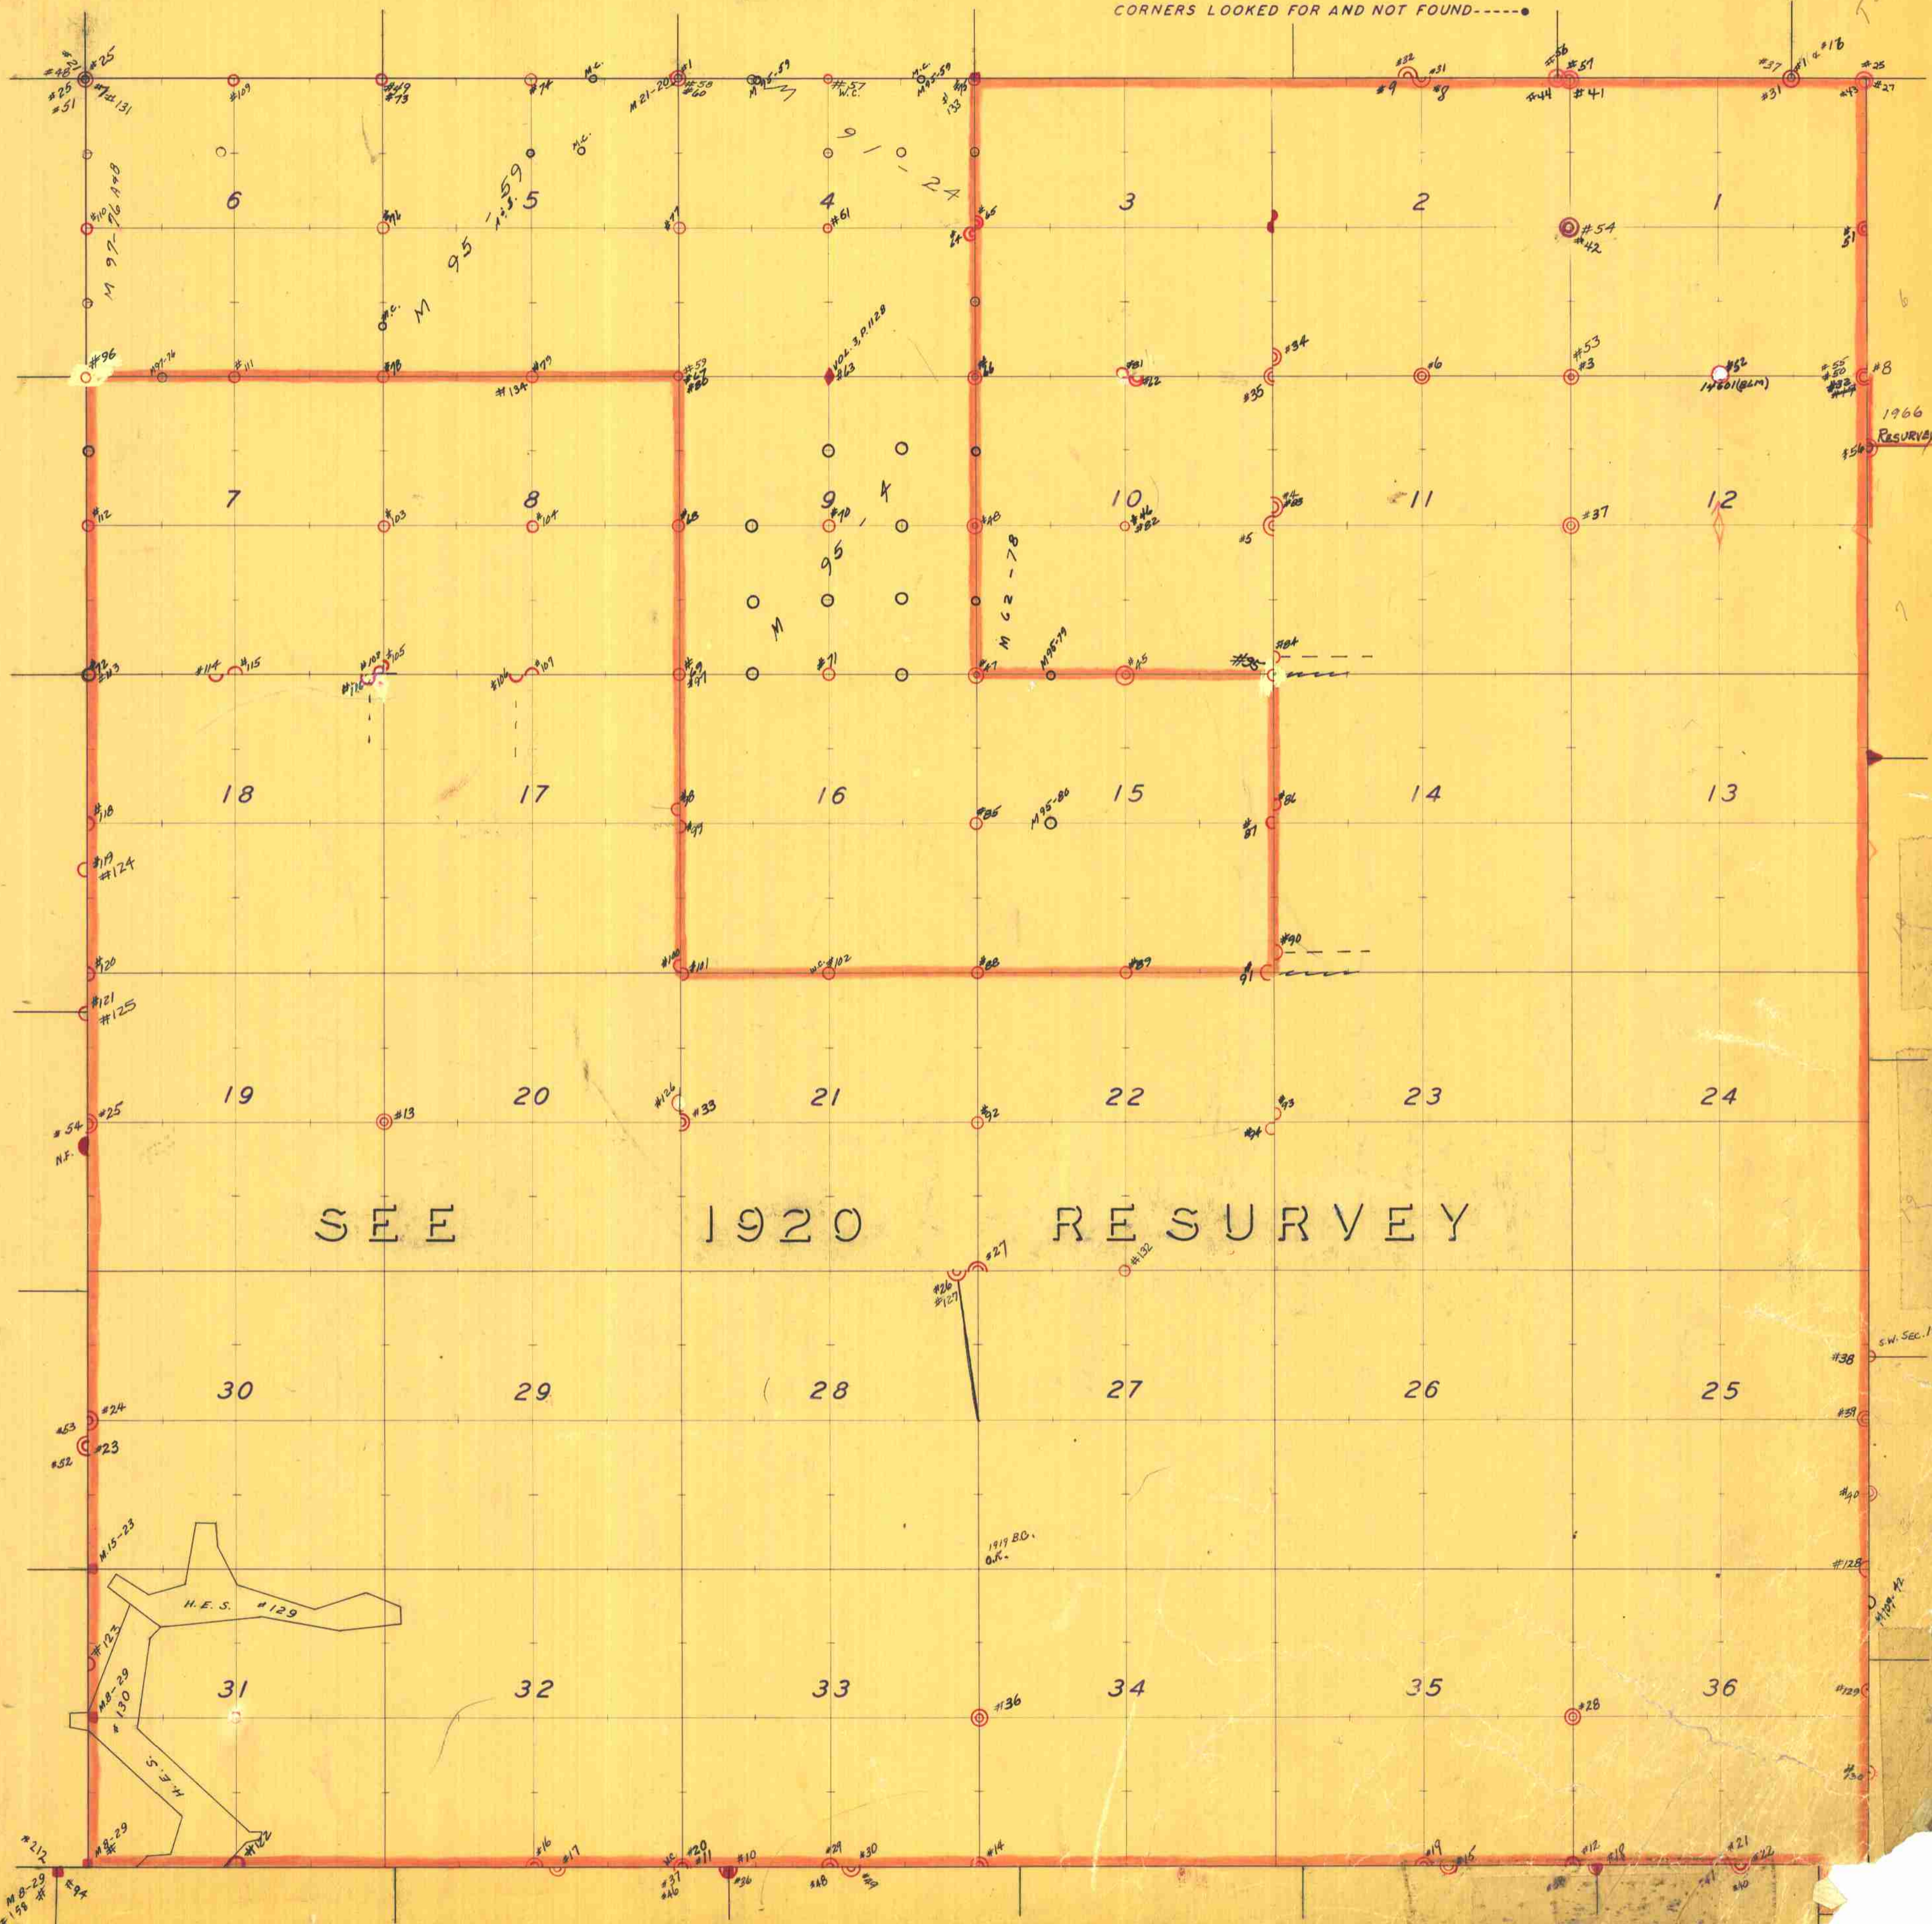

SEE 1920 RESURVEY

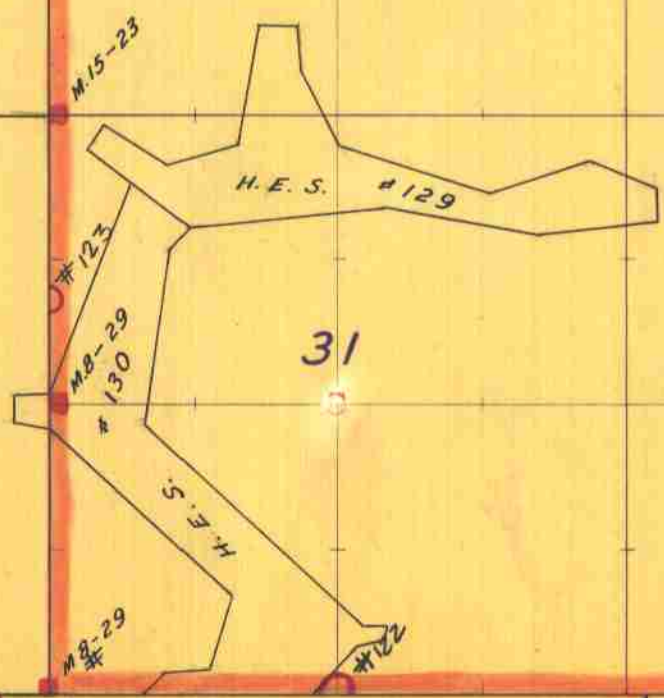

S.W. SEC. 15
 #38
 #39
 #40
 #128
 #129
 #130