


T. 22 S., R. 6 W.

CORNERS RENEWED BY
 BUREAU OF LAND MANAGEMENT-----◆
 COUNTY SURVEYOR'S OFFICE-----○
 PRIVATE SURVEYORS-----○
 CORNERS FOUND AND USED-----■
 CORNERS LOOKED FOR AND NOT FOUND-----●

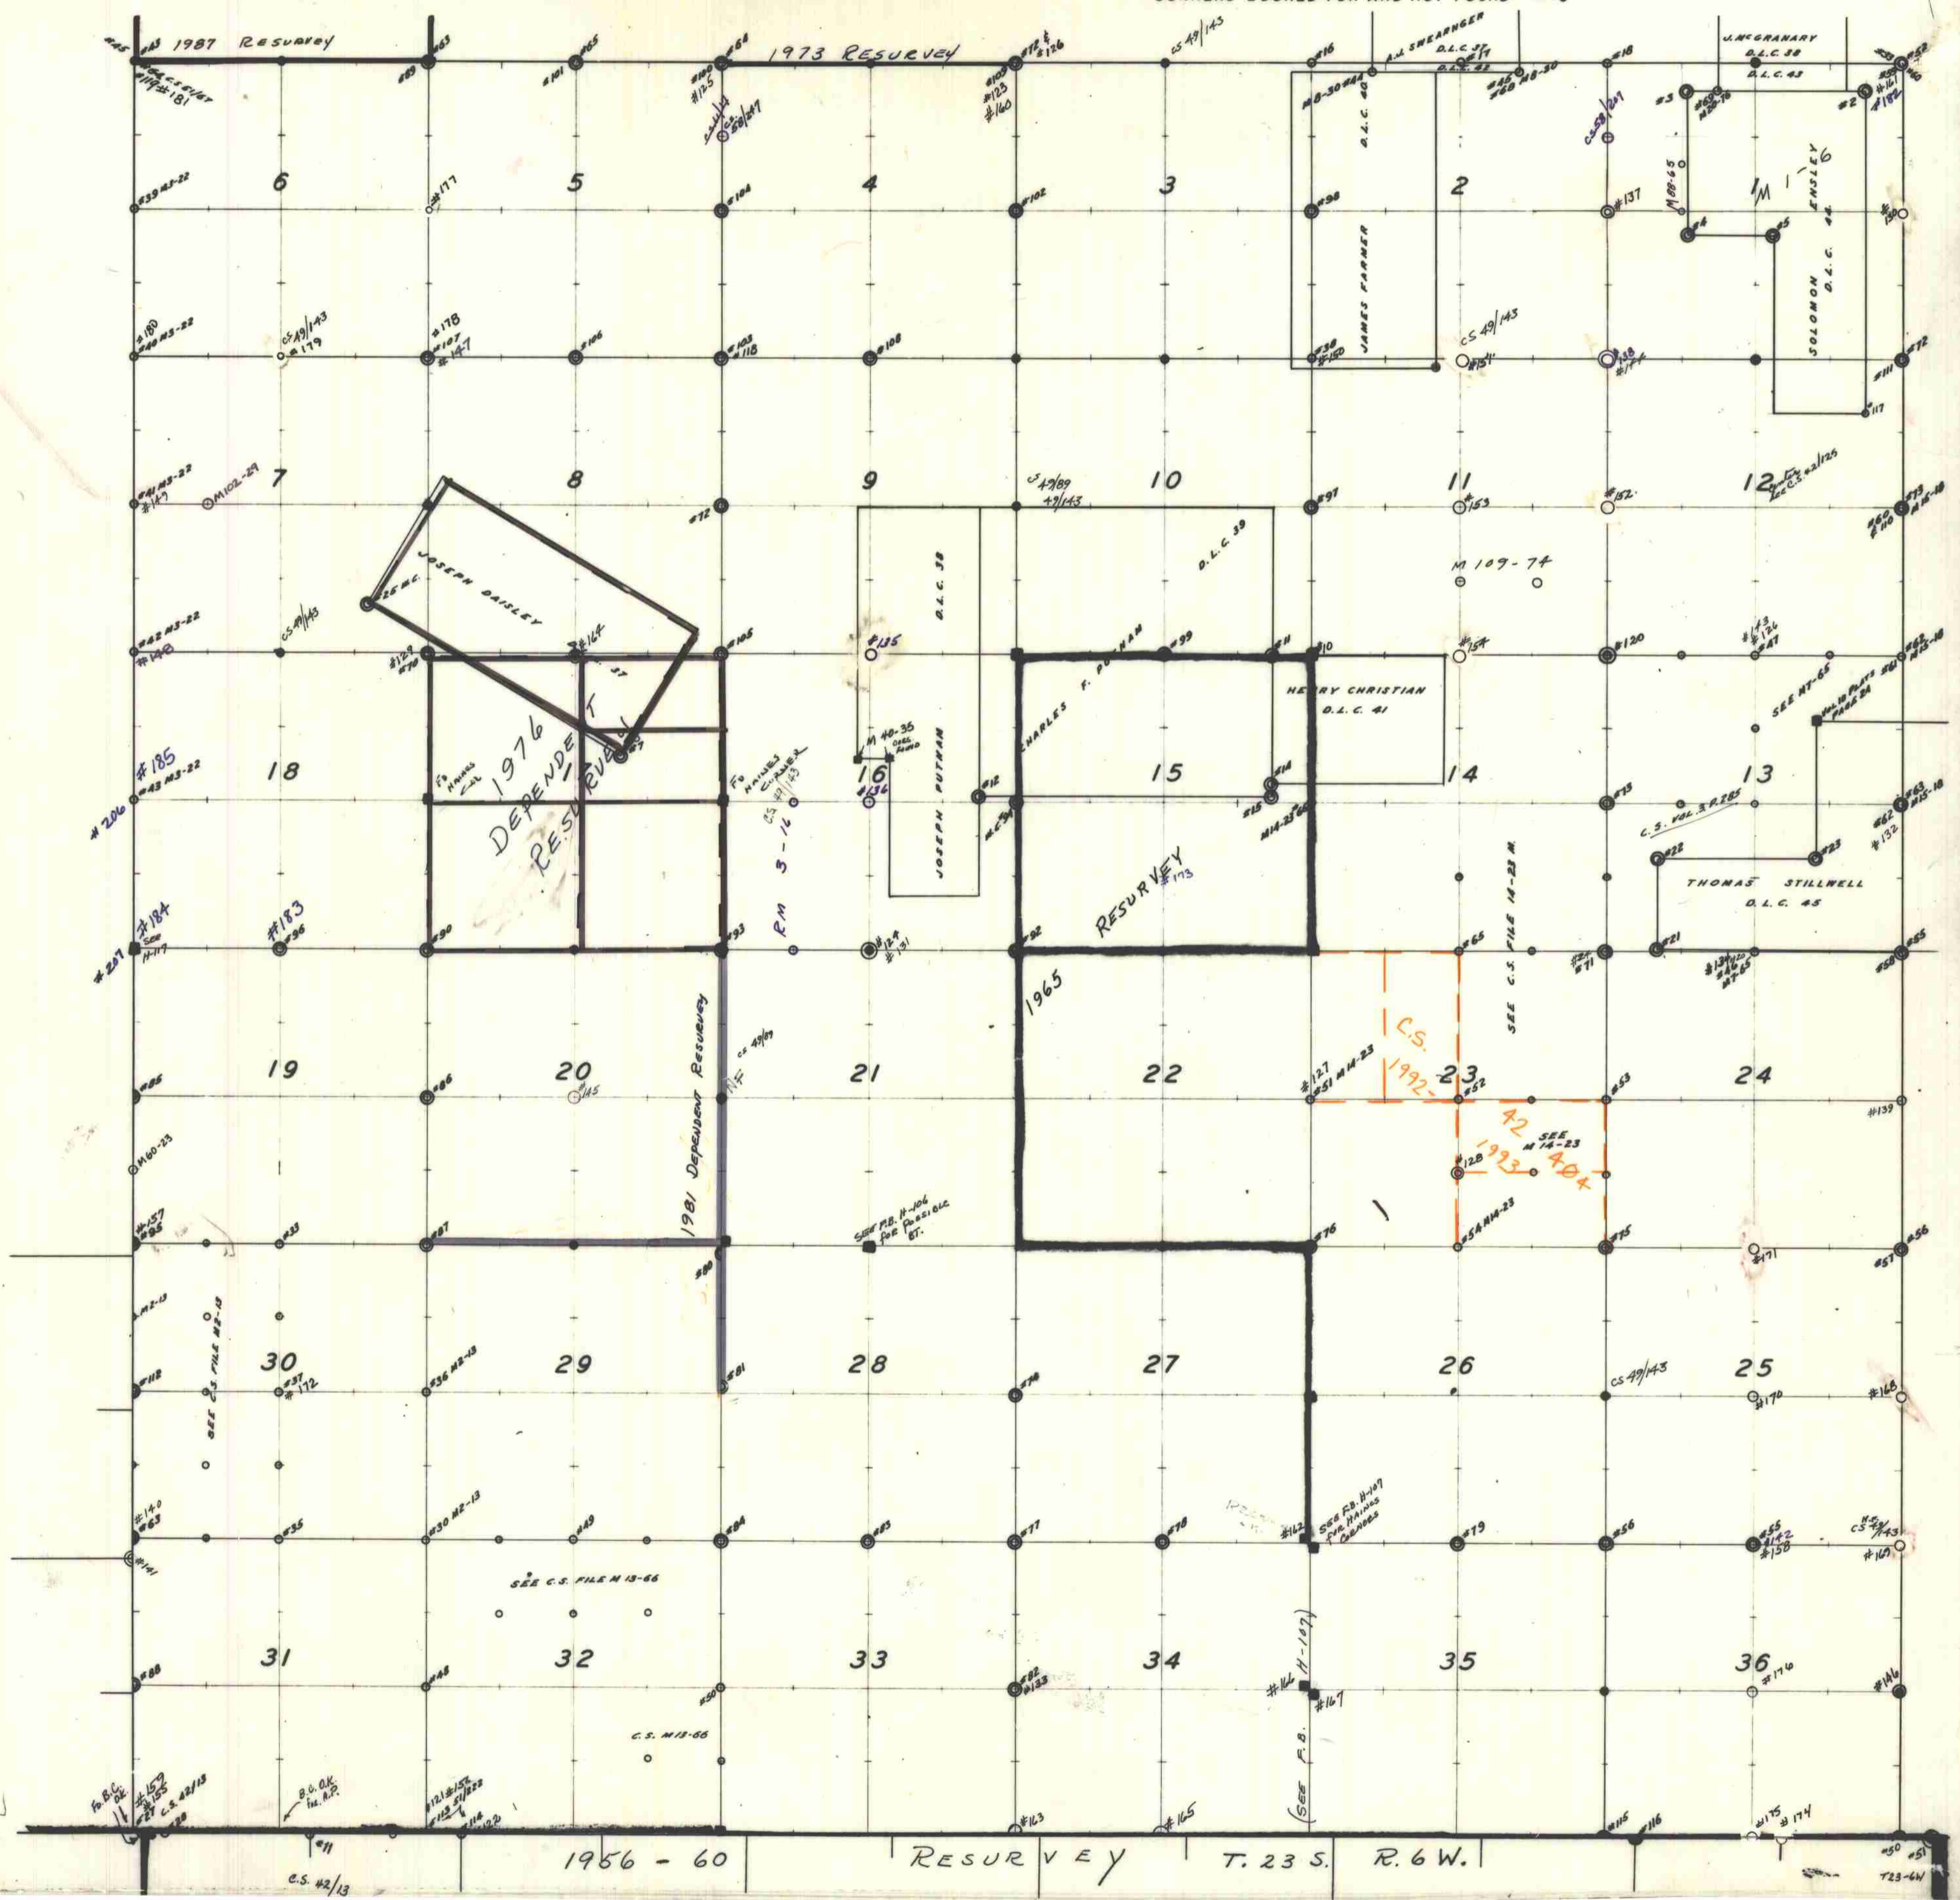

1956 - 60 RESURVEY T. 23 S. R. 6 W.

723-6W