


T. 22 S., R. 10 W.

CORNERS RENEWED BY
 BUREAU OF LAND MANAGEMENT -----◆
 COUNTY SURVEYOR'S OFFICE -----○
 PRIVATE SURVEYORS -----○
 CORNERS FOUND AND USED -----■
 CORNERS LOOKED FOR AND NOT FOUND -----●

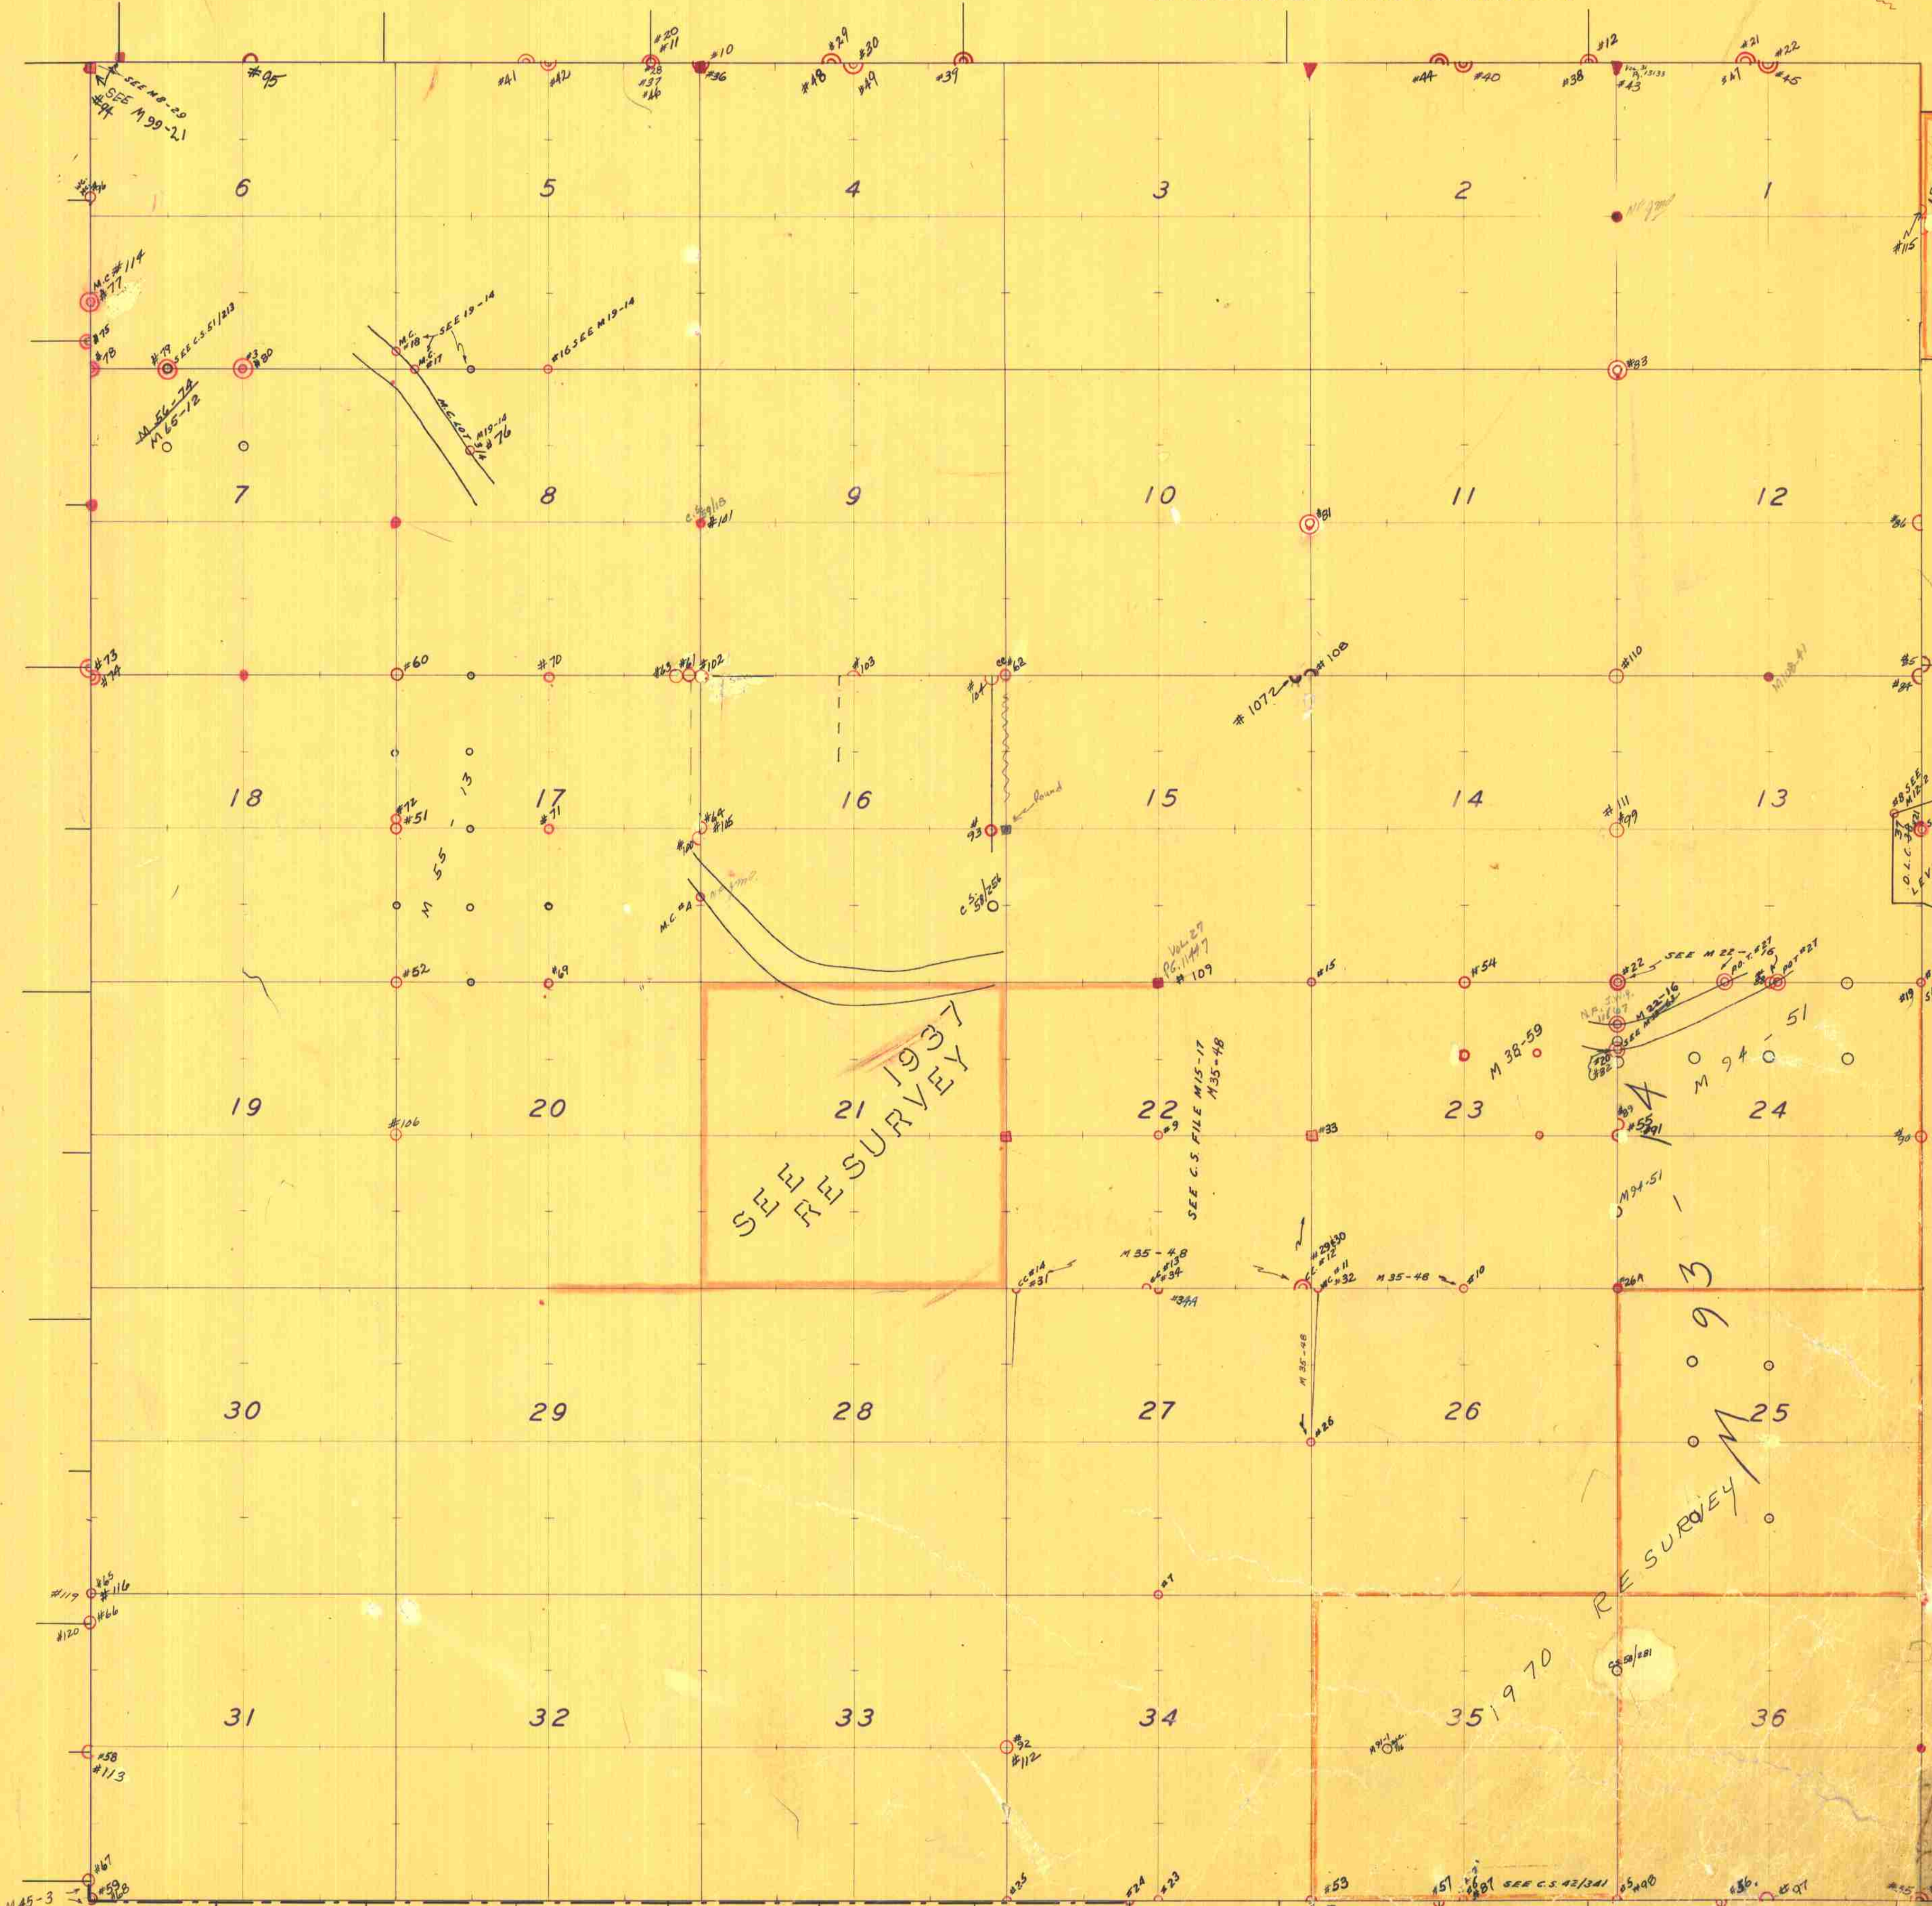

1973 Resurvey
 1984 Resurvey

SEE M 109-17
 D.L.C. LEVI SCOTT
 D.L.C.

SEE M 35-48
 SEE M 38-59
 SEE M 34-51

SEE SURVEY 1937

SEE C.S. FILE M 15-17
 M 35-48

RE SURVEY

RE SURVEY 1970

COOS COUNTY

M 10-19

M 45-3

M 10-19

M 10-19

M 10-19

M 10-19