


T. 22 S., R. 10 W.

CORNERS RENEWED BY
 BUREAU OF LAND MANAGEMENT-----◆
 COUNTY SURVEYOR'S OFFICE-----⊙
 PRIVATE SURVEYORS-----○
 CORNERS FOUND AND USED-----■
 CORNERS LOOKED FOR AND NOT FOUND-----●

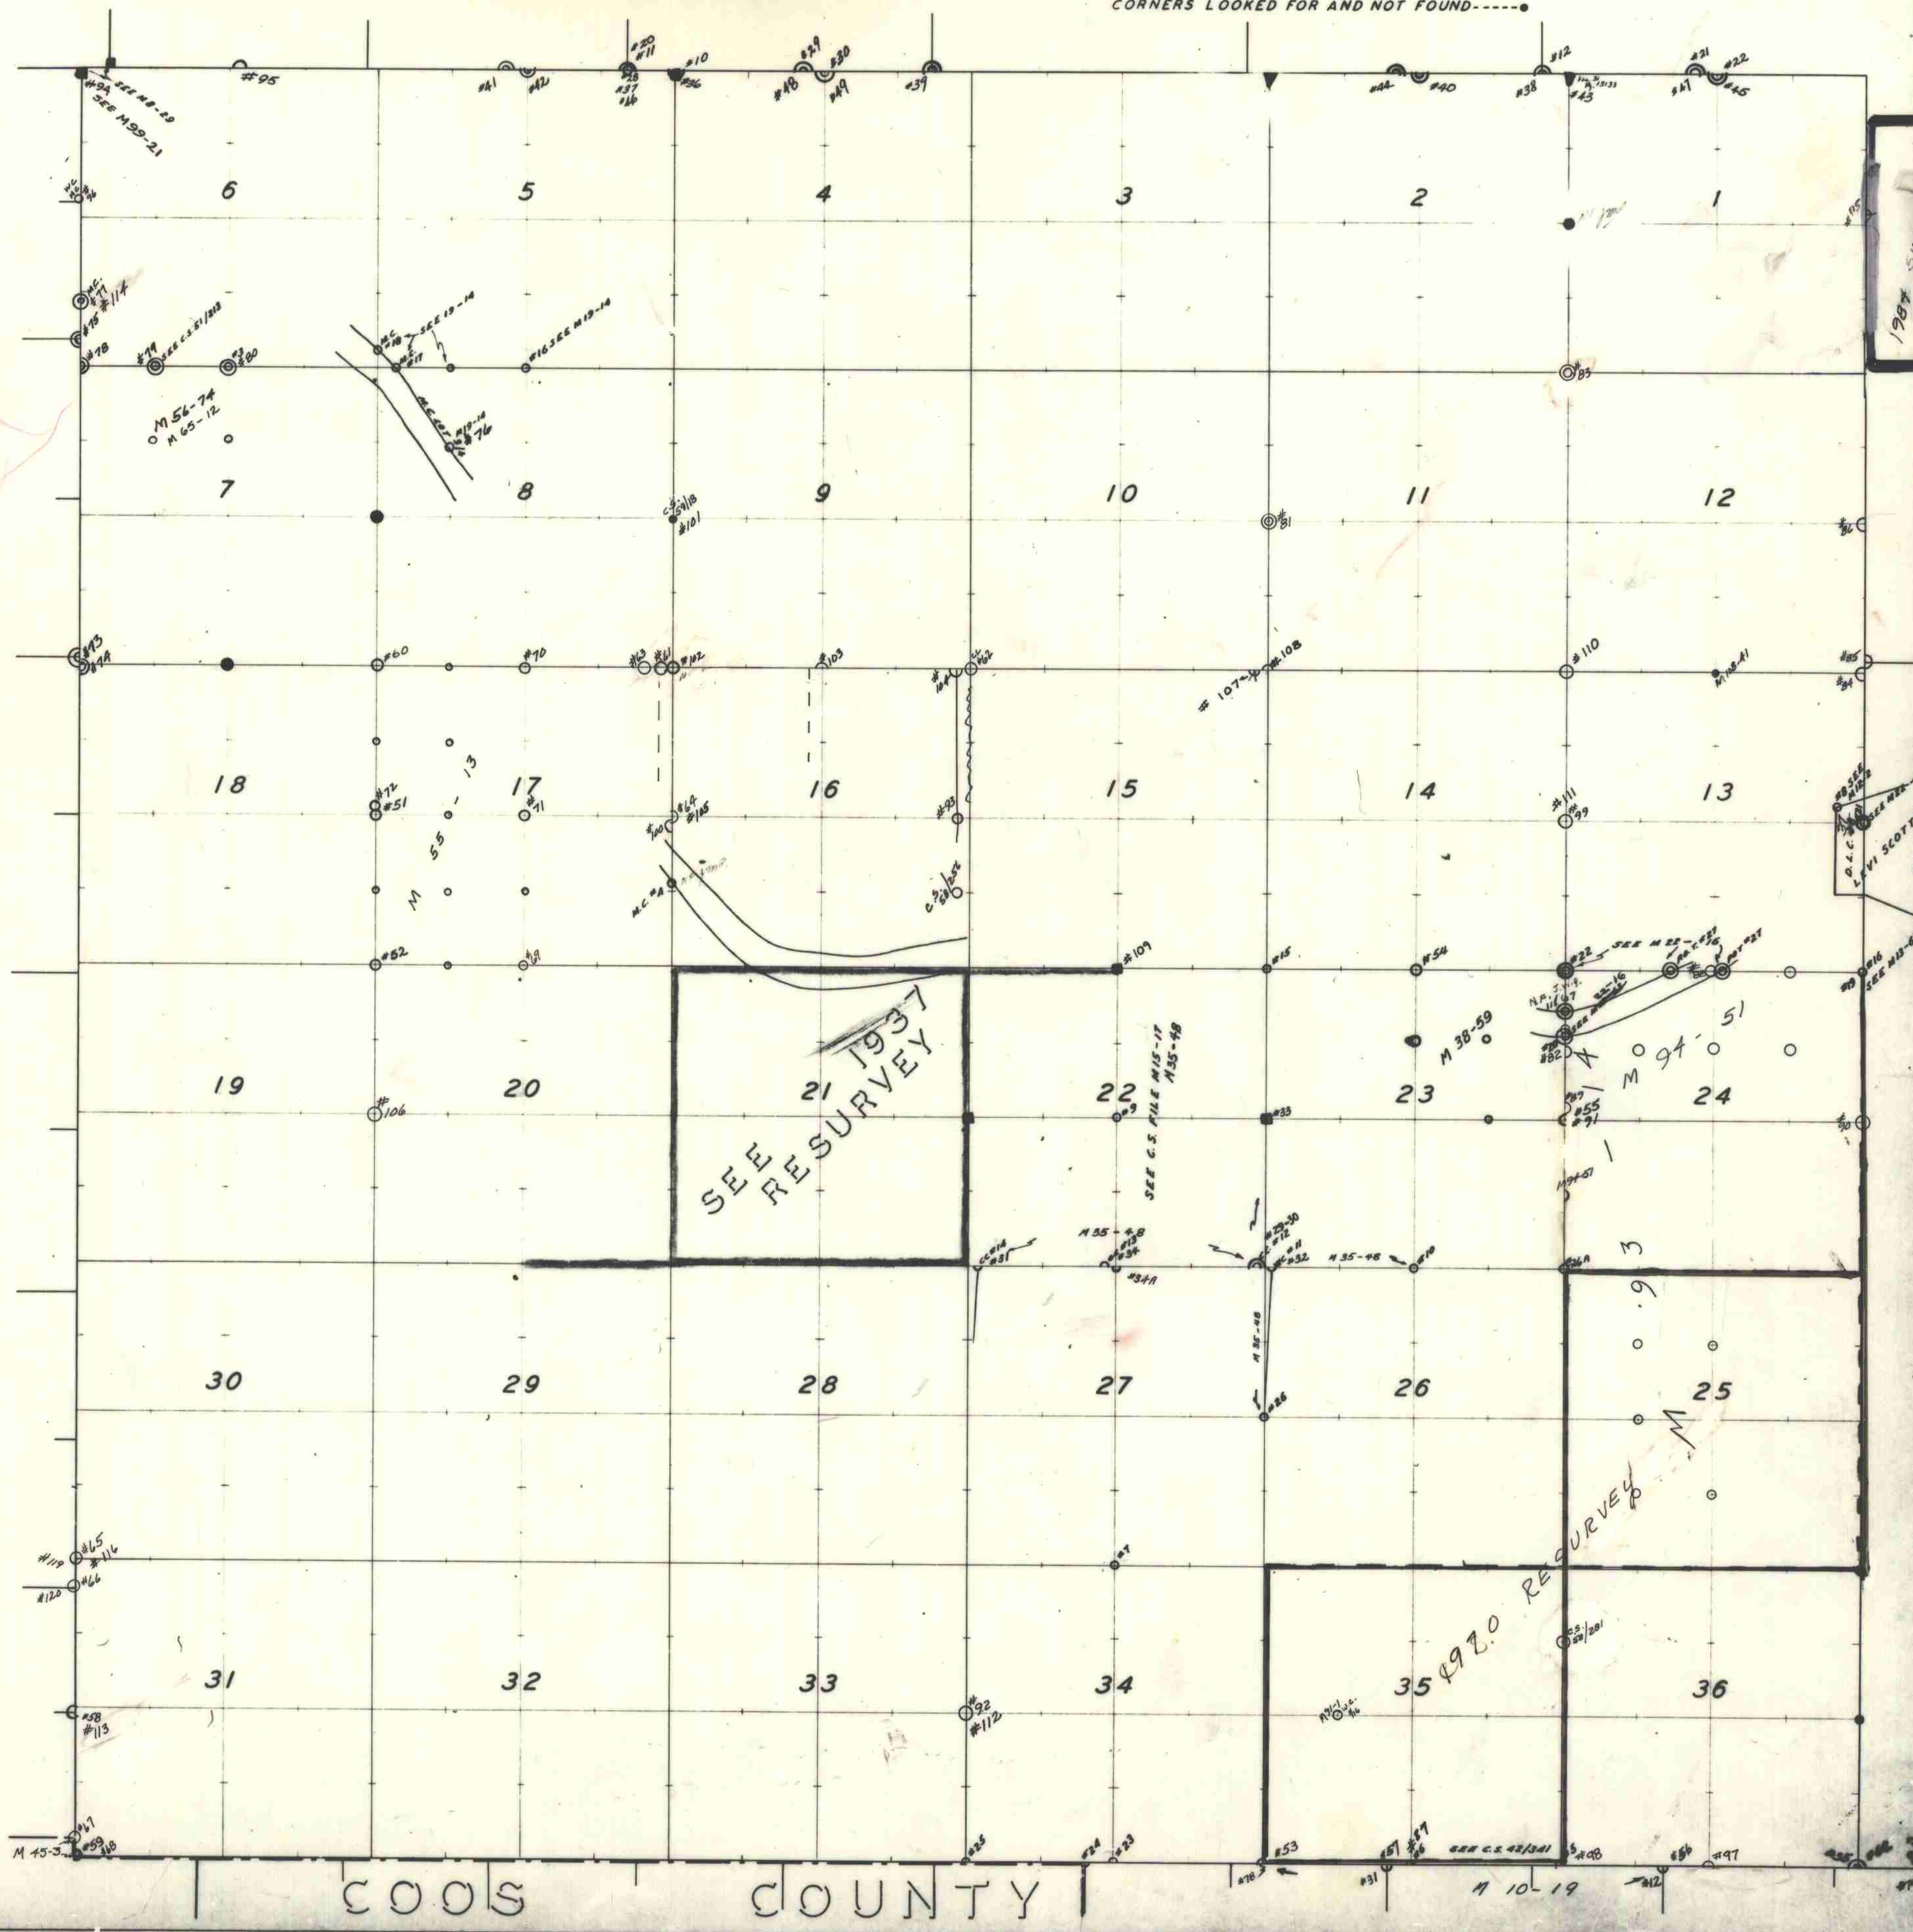

S
W
L
S
S
U
R
V
E
Y
1

35 497.0 RE SURVEY

COOS COUNTY

1987 SURVEY

SEE REB-16
L. V. SCOTTY
G. L. C.

M 10-19

M 45-3

M 56-74
M 65-12

SEE G.S. FILE M 15-17
M 35-49

M 38-59
M 94-51