

Douglas County Surveyor's Record of
Government Corners Renewed

23 T. S. 4 R. W. W. M.

KOKK-CHAPMAN CO., EUGENE, ORE. 21891


(continued)
For Corner set Iron Pipe with Brass cap stamped "S5/S4 T23S R4W
County Surveyor's Office, 1958" S8/S9
Blaze & Scribe one new tree: 14" W. Oak N.50°E. 38.4 ft. T23S R4W S4 CS BT.

James W. Byron, Deputy
Milo Godfrey
S. A. Bilow
January 8, 1959
C. S. File No. 49/42

Section Corner common to Secs. 17, 18, 19, & 20. 33

Found - Axle at Corner & all BT's.
Orig. 24", now 44" Fir N.42°E. 54.8 ft., probably bark
scribed, bark burned, no scribing found.
Orig. 24", now 44" Stump S.59°W. 25.1 ft., no scribing found.
Orig. 10", now 20" Fir N.69°W. 31.0 ft., shows good bark
scriptions "S 18".
Orig. 10", now 20" Fir S.71°E. 46.9 ft., shows scar, I do
not open.

Note - Corner thus:

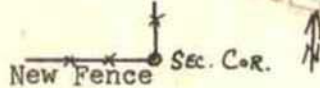

I rescribe Orig. BT's:

Now 44" R. Fir N.42°E. 54.8 ft. scribed S17 T23S R4W CS BT.
Now 20" R. Fir S.71°E. 46.9 ft. scribed S20 T23S R4W CS BT.
Now 20" R. Fir N.69°W. 31.0 ft. scribed S18 T23S R4W CS BT.

Section Corner common to Sections 7, 8, 17 & 18. 34
Found - Orig. 70", now 70" Fir S.36°E. 49.5 ft., shows good
bark scribing "1 1".

No trace of other Orig. BT's by pacing call to West,
checks O. K.

Set Brass Cap at Corner Mkd: County Surveyor's Office, 1959 114

S 7 | S 8
S18 | S17 T.23S. R.4W.

New BT's: 18" Cedar N.48°W. 18.3 ft. scribed S 7 T23S R4W CS BT.
7" R. Fir bears S.69°W. 70.2 ft. scribed S18 T23S R4W CS BT.
Rebark scribe 70" Fir S.36°E. 60.4 ft. (measured to center),
S17 T23S R4W CS BT.
11" Cedar bears N.78°E. 60.9 ft. scribed S 8 T23S R4W.

$\frac{1}{4}$ Section Corner to Sections 7 & 18. 35

Found - Orig. 40", now 60" Fir Stump, shows good bark scribing "BT"
N.35°W. 79.2 ft.

Orig. 6", now 36" Fir S.66°W. 10.6 ft, shows old scar,
I do not open. #163

Set Brass Cap at Corner Mkd: County Surveyor's Office, 1959

$\frac{1}{4}$ S 7
S18 T23S R4W

New BT's: 11" R. Fir bears North 25.7 ft. scribed S 7 CS BT.
15" R. Fir bears S.28 $\frac{1}{2}$ °E. 26.8 ft. scribed S18 CS BT.

Section Corner to Sections 7 & 18, T23S R4W, & Secs. 12 & 13, T23S R5W. 36
Found - $\frac{3}{4}$ " Iron Rod at Corner & all Orig. BT's. I do not open, Ren. #22
All show scars & all check bearing & distance.

I do not set Brass Cap.

I scribe new BT's. to N.E. & N.W. because the Orig. BT's. to North
are good saw logs. 109

New BT's: 12" R. Fir bears N.44°E. 27.7 ft. scribed $\frac{1}{4}$ S 7 CSBT.
11" Cedar bears N.78 $\frac{1}{2}$ °W. 32.7 ft. scribed $\frac{1}{4}$ S12 CS BT.


$\frac{1}{4}$ Section Corner to Sec. 18, T23S R4W, & Sec. 13, T23S R5W. 37

Found - Orig. 40", now 50" Fir Snag, previously opened, shows good
scriptions "4 S".

No trace of Original N. E. BT.

Set Brass Cap at Corner Mkd: $\frac{1}{4}$ S13/S18 T23S County Surveyor's
R5W R4W Office, 1959

New BT's: 16" Cedar bears S.13 $\frac{1}{2}$ °E. 99.0 ft. scribed $\frac{1}{4}$ S18 CS BT.
14" R. Fir bears N.35°W. 12.0 ft. scribed $\frac{1}{4}$ S13 CS BT.
Scribed high above new wire fence which is thus:

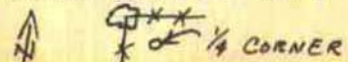

James W. Byron, Deputy County Surveyor
Milo Godfrey
C. Putnam
August 4, 1959
C. S. File No. 49/42