

Douglas County Surveyor's Record of
Government Corners Renewed

T. 23 S. T. S. R. 4 W. R. W. W. M.

KOKE-CHAPMAN CO., EUGENE, ORE. 21881


111

Sec. Cor. To Secs. 18 & 19, T23-4W. & Secs. 13 & 24, T23-5W.
Found - Brass Cap & BT's. as recorded in Ren. #83. Corner lies
in fence corner course N. - S. & W.
40" D.Fir N.60 $\frac{1}{2}$ °W. 46.2 ft., bark scribe in good condition,
metal disc. Mkd:"RD 2741" nailed to tree.
33" D.Fir S.7 $\frac{1}{2}$ °E. 199.3 ft., scribe visible on pitched face.
22" I. Cedar N. 61°E. 223.6 ft., scribe visible.
S. W. BT. dead. Other trees alive & in good condition.
New BT: 30" D.Fir S. 17° W. 181.0 ft. Mkd: T23S R5W S24 CS BT.

Oct. 25, 1965

Sec. Cor. to Sections 15 - 16 - 21 - 22.
Found - Geared Axle at Corner - Ren. #2.
36", now 42" Fir S.34°W. 126.7 ft., shows good bark scribing.
Stump of N. E. BT. N.W. BT. not found.

112

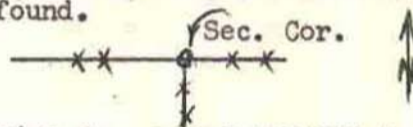

New BT's: Rescribe now 42" R.Fir S.34°W. 126.7 ft., added "CS BT" in wood.
14" W.Oak bears N.14°W. 49.8 ft. scribed S16 T23S R4W CS BT.
16" B.Oak bears N.21°E. 51.5 ft. scribed S15 T23S R4W CS BT.
No trees near to S. E.

FO OK 10/27/94 1995-0005

$\frac{1}{4}$ Corner to Sections 16 and 21.
Found - 1 $\frac{1}{2}$ " I.Pipe at Corner, Ren. #21.
Now 14" Maple N.17°W., not S.8°E, 54.6 ft., shows scribing.
Now 30" Cottonwood, not Oak, S.25°W., not N.31°E. 71.3 ft.,
shows good scribing.

113

New BT: 15" R.Fir bears S.17°W. 86.6 ft. scribed $\frac{1}{4}$ S21 CS BT.
Note - Creek is 80 ft. West.



Sec. Corner to Sections 7 - 8 - 17 - 18.
Found - Brass Cap & BT's. as recorded in Ren. #34.
Orig. 70" Fir S. 36° E. 49.5 ft., bark scribed.
18" Cedar N. 48° W. 18.3 ft., scribe visible, BT. appears to be
dying.
7" D.Fir S. 69° W. 70.2 ft., alive & in good condition.
11" Cedar N. 78° W. 60.9 ft., turned out.
New BT's: 8" D.Fir N. 23° E. 72.3 ft. Mkd: T23S R4W S8 CS BT.
18" D.Fir N. 68° W. 21.1 ft. Mkd: T23S R4W S7 CS BT.
Note - This corner lies approx. 50 ft. N.E. of road, course NW. & SE.

114

Sec. Corner to Sections 4 - 5 - 8 - 9.
Found - Brass Cap, as recorded in Ren. #32, & Oppstein's BT's.
22" W.Oak S.20°E. (not S.10°E) 89.4 ft., shows good scars.
19" W.Oak S. 32° W. 53.4 ft., shows good scars.
24" D.Fir N. 56° W. 33.6 ft., down & dead.
14" W. Oak N. 50° E. 38.4 ft., healed over, alive. 210
New BT: 11" W.Oak N. 13° E. 69.4 ft. Mkd: T23S R4W S4 CS BT.
Note - Fence Corner bears South 30 ft., fences course S. & W.

115

$\frac{1}{4}$ Corner to Sections 7 and 8.
Found - Haines' "T" Iron as recorded Ren. #46 & BT's., as follows: #162
Orig. 30", now 36" Pine S.36°E. 11.2 ft., bark scribed "S", Alive.
Orig. 36", now 40" Fir S.14°W. 27.7 ft., bark scribed "S" BT" Alive.
(Because these BT's. are good saw logs, we mark)
New BT's: 8" W.Fir N. 59° E. 16.9 ft. mkd: $\frac{1}{4}$ S 8 CS BT.
8" D.Fir S. 26° W. 43.4 ft. Mkd: $\frac{1}{4}$ S 7 CS BT.
Note - This corner lies approx. 150.0 ft. E. of ridge top, course N.W. on
edge of change from rolling top to steep East slope.

116

Vernon "Ray" Tracy & James W. Byron, County Surveyor
Mike Stone & Jerry Layne
October 1965
C. S. File No. 54/16

FO OK 8/92 BY NESS
C.S. 63/144

RE-

RE-ENTERED SET CORNER