

Douglas County Surveyor's Record of
Government Corners Renewed

23 T. S. 5 R. W. W. M.

KECK-CHAPMAN CO., EUGENE, ORE. 21001

(continued)

Set Brass Cap at Corner & alongside Anchor Post Mkd:

County Surveyor's $\frac{1}{4}$ S35 T23S R5W
Office, 1959 S 2 T24S

FD. O.K.
10/69 V.R.T.
C.S. 54/16

James W.
Byron
M. Godfrey
C. Putnam

New BT's:

7" R. Fir bears S. 2°E. 19.0 ft. scribed $\frac{1}{4}$ S 2 CS BT.
12" W. Oak S. 76°W. 19.4 ft. (Theil's), shows good
scars. I do not open.

Nov. 27,
1959

C. S.
File
No.
49/42

Section Corner to Sections 29, 30, 31, and 32.

45

Found - Old Fir Stump, now 36" diam, S. 17°E. 194.7 ft. Cut open
and found good orig. scribing "T23S". Stump was rescribed
about 15 yrs. before tree was cut. Found rescribing
"T23S R5W S32".

Remnants of old old Oak Stump bears N. 60 $\frac{3}{4}$ °E. 127.4 ft.
No trace of N.W. or S.W. BT's. can be found.

Set Brass Cap at Corner Mkd: "County Surveyor's Office, 1959

S30 | S29 T23S R5W
S31 | S32

Blaze & Scribe New BT's:

50" Cedar S. 17 $\frac{1}{2}$ °W. 33.3 ft. mkd: "T23S R5W S31 CS BT"

42" Cedar N. 10 $\frac{1}{2}$ °E. 66.0 ft. mkd: "T23S R5W S29 CS BT"

12" W. Oak S. 89 $\frac{1}{2}$ °E. 98.6 ft. mkd: "T23S R5W S32 CS BT"

No suitable tree near in N. W. 9/93 fd. OK. Ken Hotfire M117-52

9/69 FOUND O.K. C.S. 54/16 ; M86-16

Section Corner to Sections 28, 29, 32, 33.

46


Found - Orig. 16", now 20", down & rotted Oak N. 82°E. 25.9.

I find chip of old face showing good reverse scribing, "BT".

Orig. 16", now down & rotted Oak (S. 57°E. 90.5 ft.) record
S. 55°E. 85.1 ft. I find chip of old face showing good
reverse scribing.

Orig. N.W. & S.W. BT's. not found.

Fences Thus:

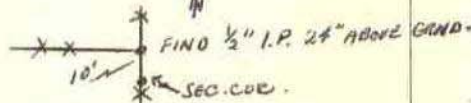

Set Brass Cap at Corner Mkd: County Surveyor's Office, 1959.

S29 | S28 T23S R5W
S32 | S33

New BT's: 26" R. Fir bears S. 76°W. 53.8 ft. scribed S32 T23S R5W CS BT.

4" R. Fir bears S. 15 $\frac{1}{2}$ °W. 18.7 ft. scribed S32 CS BT.

No suitable trees near to N.W., N.E., & S.E.

James W. Byron, Deputy County Surveyor
Milo Godfrey
Clete Putnam
Dec. 14 - 18, 1959
C. S. File No. 49/42

$\frac{1}{4}$ Section Corner Sections 20 and 29.

47

Found - Fir Stump, now 36" diah., S. 23 $\frac{1}{4}$ °W. 48.2 ft. Cut open &
found good scribing "B".

Fir Stump, now 24", N. 16°E. 25.7 ft., showing good scar,
did not open.

At Corner set Iron Pipe with Brass Cap Mkd: "County Surveyor's
Office, 1959, T23S R5W $\frac{1}{4}$ S20"

Blaze & Scribe 2 new Trees: S29

6" D. Fir N. 44 $\frac{1}{2}$ °E. scribed " $\frac{1}{4}$ S20 CS BT" 12.6 ft.

4 $\frac{1}{2}$ " D. Fir S. 44 $\frac{1}{2}$ °E. scribed " $\frac{1}{4}$ S29 CS BT" 17.6 ft.

$\frac{1}{4}$ Section Corner to Sections 23 & 26.

48

Found - 1" Iron Pipe at Corner & Both BT's. as recorded by B.B.I., Ren. #28
1940, both BT's. show good scars.

S.E. BT. now stump.

Corner is near Right bank of stream. I set Witness Corner 50' North.

Set Brass Cap Mkd: Wit. Cor. 50' South to $\frac{1}{4}$ Cor. S23 T23S R5W
County Surveyor's Office, 1959 S26

New BT's: 20" R. Fir S. 71°W. 17.9 ft. scribed WC $\frac{1}{4}$ S26 CS BT.

16" R. Fir N. 12°E. 38.8 ft. scribed WC $\frac{1}{4}$ S23 CS BT.

RE-RENEWED GOVERNMENT CORNER NO. #102