

Douglas County Surveyor's Record of
Government Corners Renewed

23 T. S. 7 R. W. W. M.

KCKE-CHAPMAN CO., EUGENE, ORE. 21881

(continued)

78

Set Brass Cap at Corner Mkd: County Surveyor's Office, 1960
R8W S36/S31 R7W T23S
T24S

New BT's: 18" R. Fir bears N.72°E. 62.5 ft. scribed S31 T23S R7W CS BT.
12" R. Fir bears N.63°W. 53.6 ft. scribed S36 T23S R8W CS BT.

Find Corners Thus
E. 216. S36/S31 T23S
S1/S6 T24S
Record 215.2)

C. S. File No. 49/41
September 26, 1960

Renew C.C. S5/S4 T23S
T24S R7W

79


Found - 42", now 48" Fir S.36°E. 52.8 ft., shows good bark
scribing "4S".

42", now down, 48" Fir S.10°W. 19.8 ft., bark sluffing
off, no scribing found.

Set - Brass Cap at corner mkd: County Surveyor's Office, 1960
C C T23S
S5/S4 T24S R7W

New BT's: 12" R. Fir bears S.54½°W. 21.4 ft. scribed CC S5 T24S R7W CS BT.
10" R. Fir bears N.39°W. 9.6 ft. scribed CC S4 S5 CS BT.
No suitable trees near to S. E.

Note - Govt. notes for this corner received by County Surveyor, Sept, 1960.
Stake Set for Corner & used by others bears S.56°E. 19.3 ft.

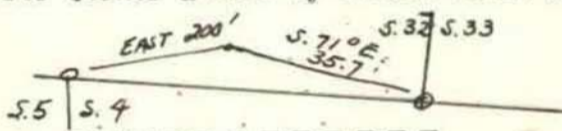

Renew T23S
R8W S1/S6 R7W
T24S

80

Found - Orig. 36", now 48" Fir N.38°W. 56.1 ft., old face
destroyed by fire.

Orig. 36", now 42" Fir S.57°E. 54.8 ft., old face destroyed
by Fire.

Orig. 48", now 65" Fir S.10°W. (Record S.57°E.) 79.2 ft.
Now Stump, shows rotted face.

Set Brass Cap at Corner Mkd: County Surveyor's Office, 1960
C C T23S
S1/S6 T24S
R8W R7W

New BT's: 4" R. Fir bears S.13°W. 15.4 ft. scribed S1 CS BT.
Rescribe, now 42" R. Fir S.57°E. 54.8 ft. CC S6 T24S R7W CS BT.

RE-RENEWED - SEE COR. No. 135


Section Corner to Sections 17, 18, 19 and 20.

Found - Orig. 9", now 36" Fir Stump S.27°W. 19.1 ft., no trace of
other Orig. BT's.

81

BT., previously opened, shows good scribing "23 SW".

Note - Corner Thus:

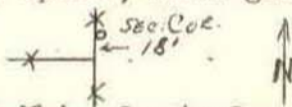

Set Brass Cap at Corner Mkd: County Surveyor's Office, 1960
S18/S17 T23S R7W
S19/S20

New BT's: 14" W. Fir bears N.52°W. 16.3 ft. scribed S18 T23S R7W CS BT.
28" Maple bears S.65°W. 36.6 ft. scribed S19 T23S R7W CS BT.
16" R. Fir bears S.20°E. 38.0 ft. scribed S20 T23S R7W CS BT.
18" Maple bears N.44°E. 25.0 ft. scribed S17 T23S R7W CS BT.

James W. Byron
Milo Godfrey
Clete Putnam

James W. Byron
Milo Godfrey
Clete Putnam
Nov. 9, 1960
C. S. File No. 49/49