


T. 23 S., R. 8 W.

CORNERS RENEWED BY  
 BUREAU OF LAND MANAGEMENT -----◆  
 COUNTY SURVEYOR'S OFFICE -----○  
 PRIVATE SURVEYORS -----○  
 CORNERS FOUND AND USED -----○  
 CORNERS LOOKED FOR AND NOT FOUND -----○

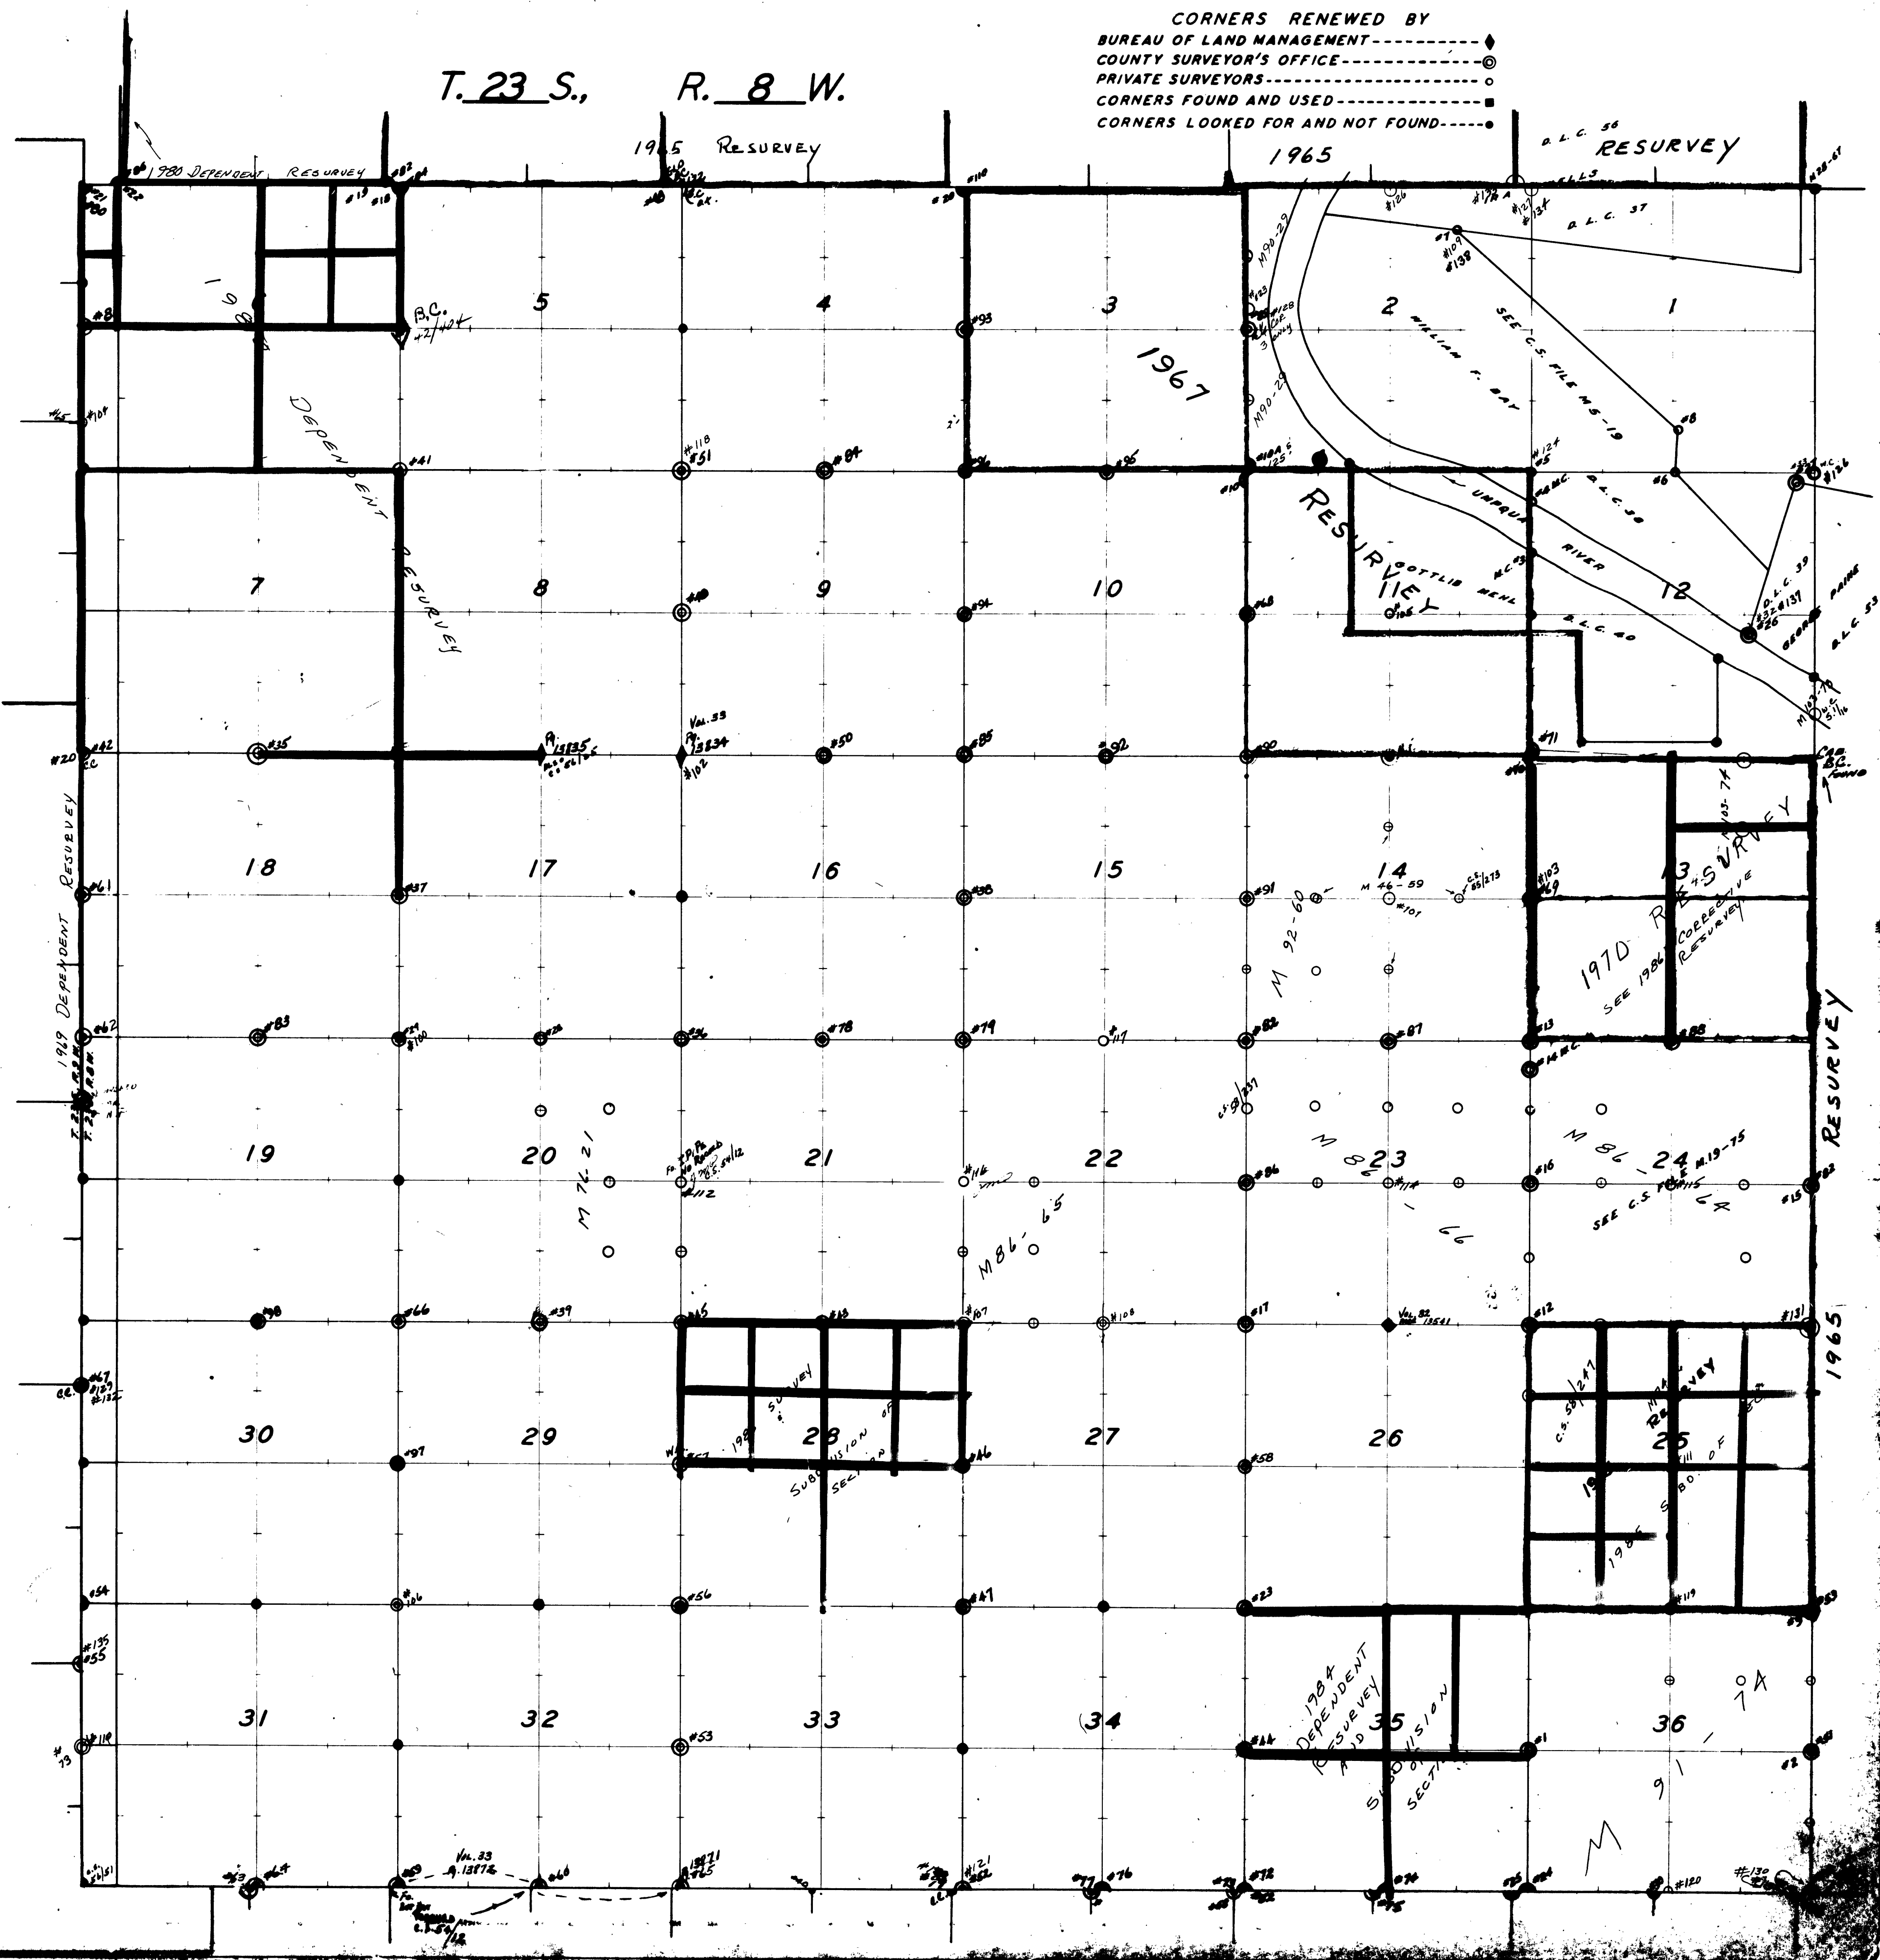

1960 DEPENDENT RESURVEY

1965 RESURVEY

1965

D.L.C. 56 RESURVEY

16

5

4

3

1967

2

1

7

8

9

10

12

18

17

16

15

14

1970 RESURVEY

19

20

21

22

23

M 86-24 SEE C.S. FILE M 19-75

30

29

28

27

26

25

31

32

33

34

35

36

7A

M 33 9-13772

M 33 9-13772

