

Douglas County Surveyor's Record of
Government Corners Renewed


T 23 S T.S. R 10 W R.W.W.M.

KOKE-CHAPMAN CO., EUGENE, ORE. 21881

104

Witness corner for 1/4 corner for Sec's. 24, & 25.

Found - W.C. (pipe & Brass Cap in slide area). Renewal #92.
BT (38" Myrtle bears N.47 1/2°W., 38.8-ft., with location poster.
Set - W.C. (NEW) established from record bearing and on section line,
S.89°16'24"W., 77.0-ft. from the record location of the fd. W.C.,
as determined by measurement from the remaining bearing tree.
W.C. monument consists of 1" x 30" Gal. I.P. with a 2 1/2" B.C.
marked:

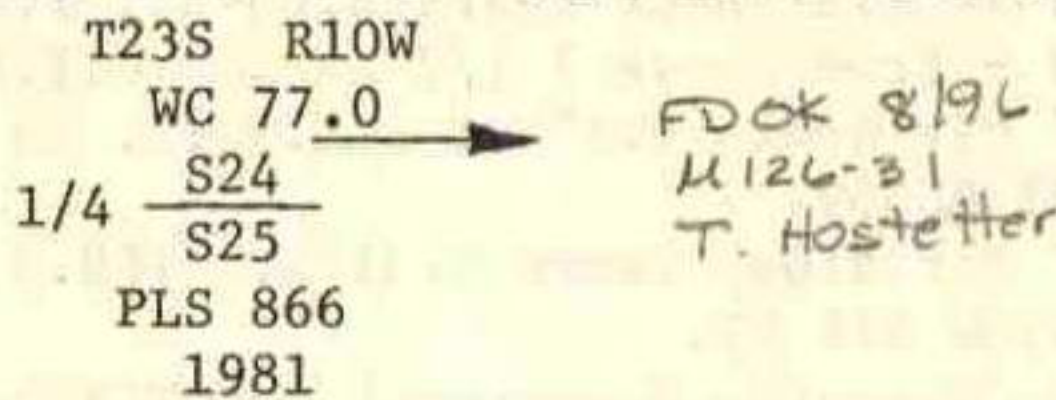

Wm. J. Ruppert
OLS 866
May, 1981
M 87 - 80

BT's - 38" Myrtle (same as above) bears N.41 1/2°E., 34.7-ft. w/poster.
39" Maple bears N.40°35'W., 37.0-ft., scribed WC 1/4 S24 BT.
B.O. - No. end of East guard rail on bridge bears S.82°23'W, 66.5-ft.
* NOTE : No suitable trees nearby in Sec. 25.

FD OK T. Hoshell

105

Section corner for Secs. 13 and 24; and Secs. 18 & 19 of T.23-9 11-95 M123-13
Found - 2 1/2" BLM brass cap on a 2 1/2" I.P. set in 1967.
8" myrtle bears N.69°E., 223.7 ft. (1967) scribed T23S R9W S18 BT.
8" dead, down ash (record maple) bears N.27°W., 427.7 ft. Scribing
not found. (1967)
New BT - 11" Ash bears N.02°E., 81.3 ft. (1981) scribed T23S R9W S18 BT.
11/81

Robert Ward For:
Champion International
Corp.
Sept./Nov. 1981
M 89 - 63

FD OK T. Hoshell

106

1/4 Corner common to Sec. 24, & Sec. 19 of T.23-9. 11-95 M123-13
Set - Oregon State Board of Forestry 1-1/2" x 36" Galv. I.P. with a
3" Bronze cap, placed 34" in ground. (OSBF P/C 34" IG).
BTs. - 20" Hemlock bears N.46°W., 21.2-ft., RS. Ren.# 90.
24" Hemlock bears S.10°E., 25.4-ft., YMLP. Ren.# 90.
BOs - WPCP bears N.57°E., 1.8-ft.
5/8" x 30" I.R. bears N.80° 10' 58"W., 23.71-ft. 9/29/81

Lloyd Smith
For: State of Oregon-
Dept. of Forestry
September 29, 1981
M 89-40

Center 1/4 Corner for Sec. 24. FD OK T. Hoshell 11-95 M123-13 107
Set - OSBF P/C 34" in ground.
BTs. - 83" Myrtle bears N.28°W., 12.7-ft., YMLP. Ren.# 91.
34" Myrtle bears S.70°W., 27.2-ft., RS. Ren.# 91.
BOs - WPCP bears N.60°W., 2.3-ft. Ren.# 91.
5/8" I.R. bears N.10°11'11"E., 1.65-ft. 9/29/81
Fd OK 9/93 M117-80

1/4 Corner for Section 35 only of T.22-10 108
Found - 1970 BLM brass cap on iron pipe. (See Ren. #83)
20" maple (sawed stump) bears N.33°15'E., 32.3 ft., 1970 BT.
Set - 50 d. nail in tip, center of maple stump.
5/8" x 36" iron rod with stamped cap (P.L.S. 497) in top,
center of a 48" sawed fir stump which bears N.56°00'E., 18.90 ft.
6/83

Richard J. Hintz
For: International
Paper Company
June 1983
M 94 - 48

109

1/4 Corner for Secs. 23 and 26
Found - 42" maple log on ground next to a 42" maple stump. Log has a
face with a portion of a scribed "S" visible. Stump has a
corresponding face but no scribing visible.
Set - 2 1/2" x 30" I.P with 2 1/2" brass cap properly mkd. and with
RPLS 2004 stamped.
42" maple stump bears N.50°00'E., 13.2 ft. (1879 BT).
11" alder bears S.53°00'E., 48.2 ft. (1983 BT). Bark scribed 1/4
S26 BT.
13" hemlock bears S.58°00'W., 60.9 ft. (1983 BT) scribed 1/4
S26 BT.

Gregory K. Miller
LS #2004
For: Champion Inter.
Apr.-Aug. 1983
M 95 - 29 A&B