


T. 23 S., R. 10 W.

CORNERS RENEWED BY
BUREAU OF LAND MANAGEMENT
COUNTY SURVEYOR'S OFFICE
PRIVATE SURVEYORS
CORNER FOUND AND USED
CORNER LOOKED FOR AND NOT FOUND

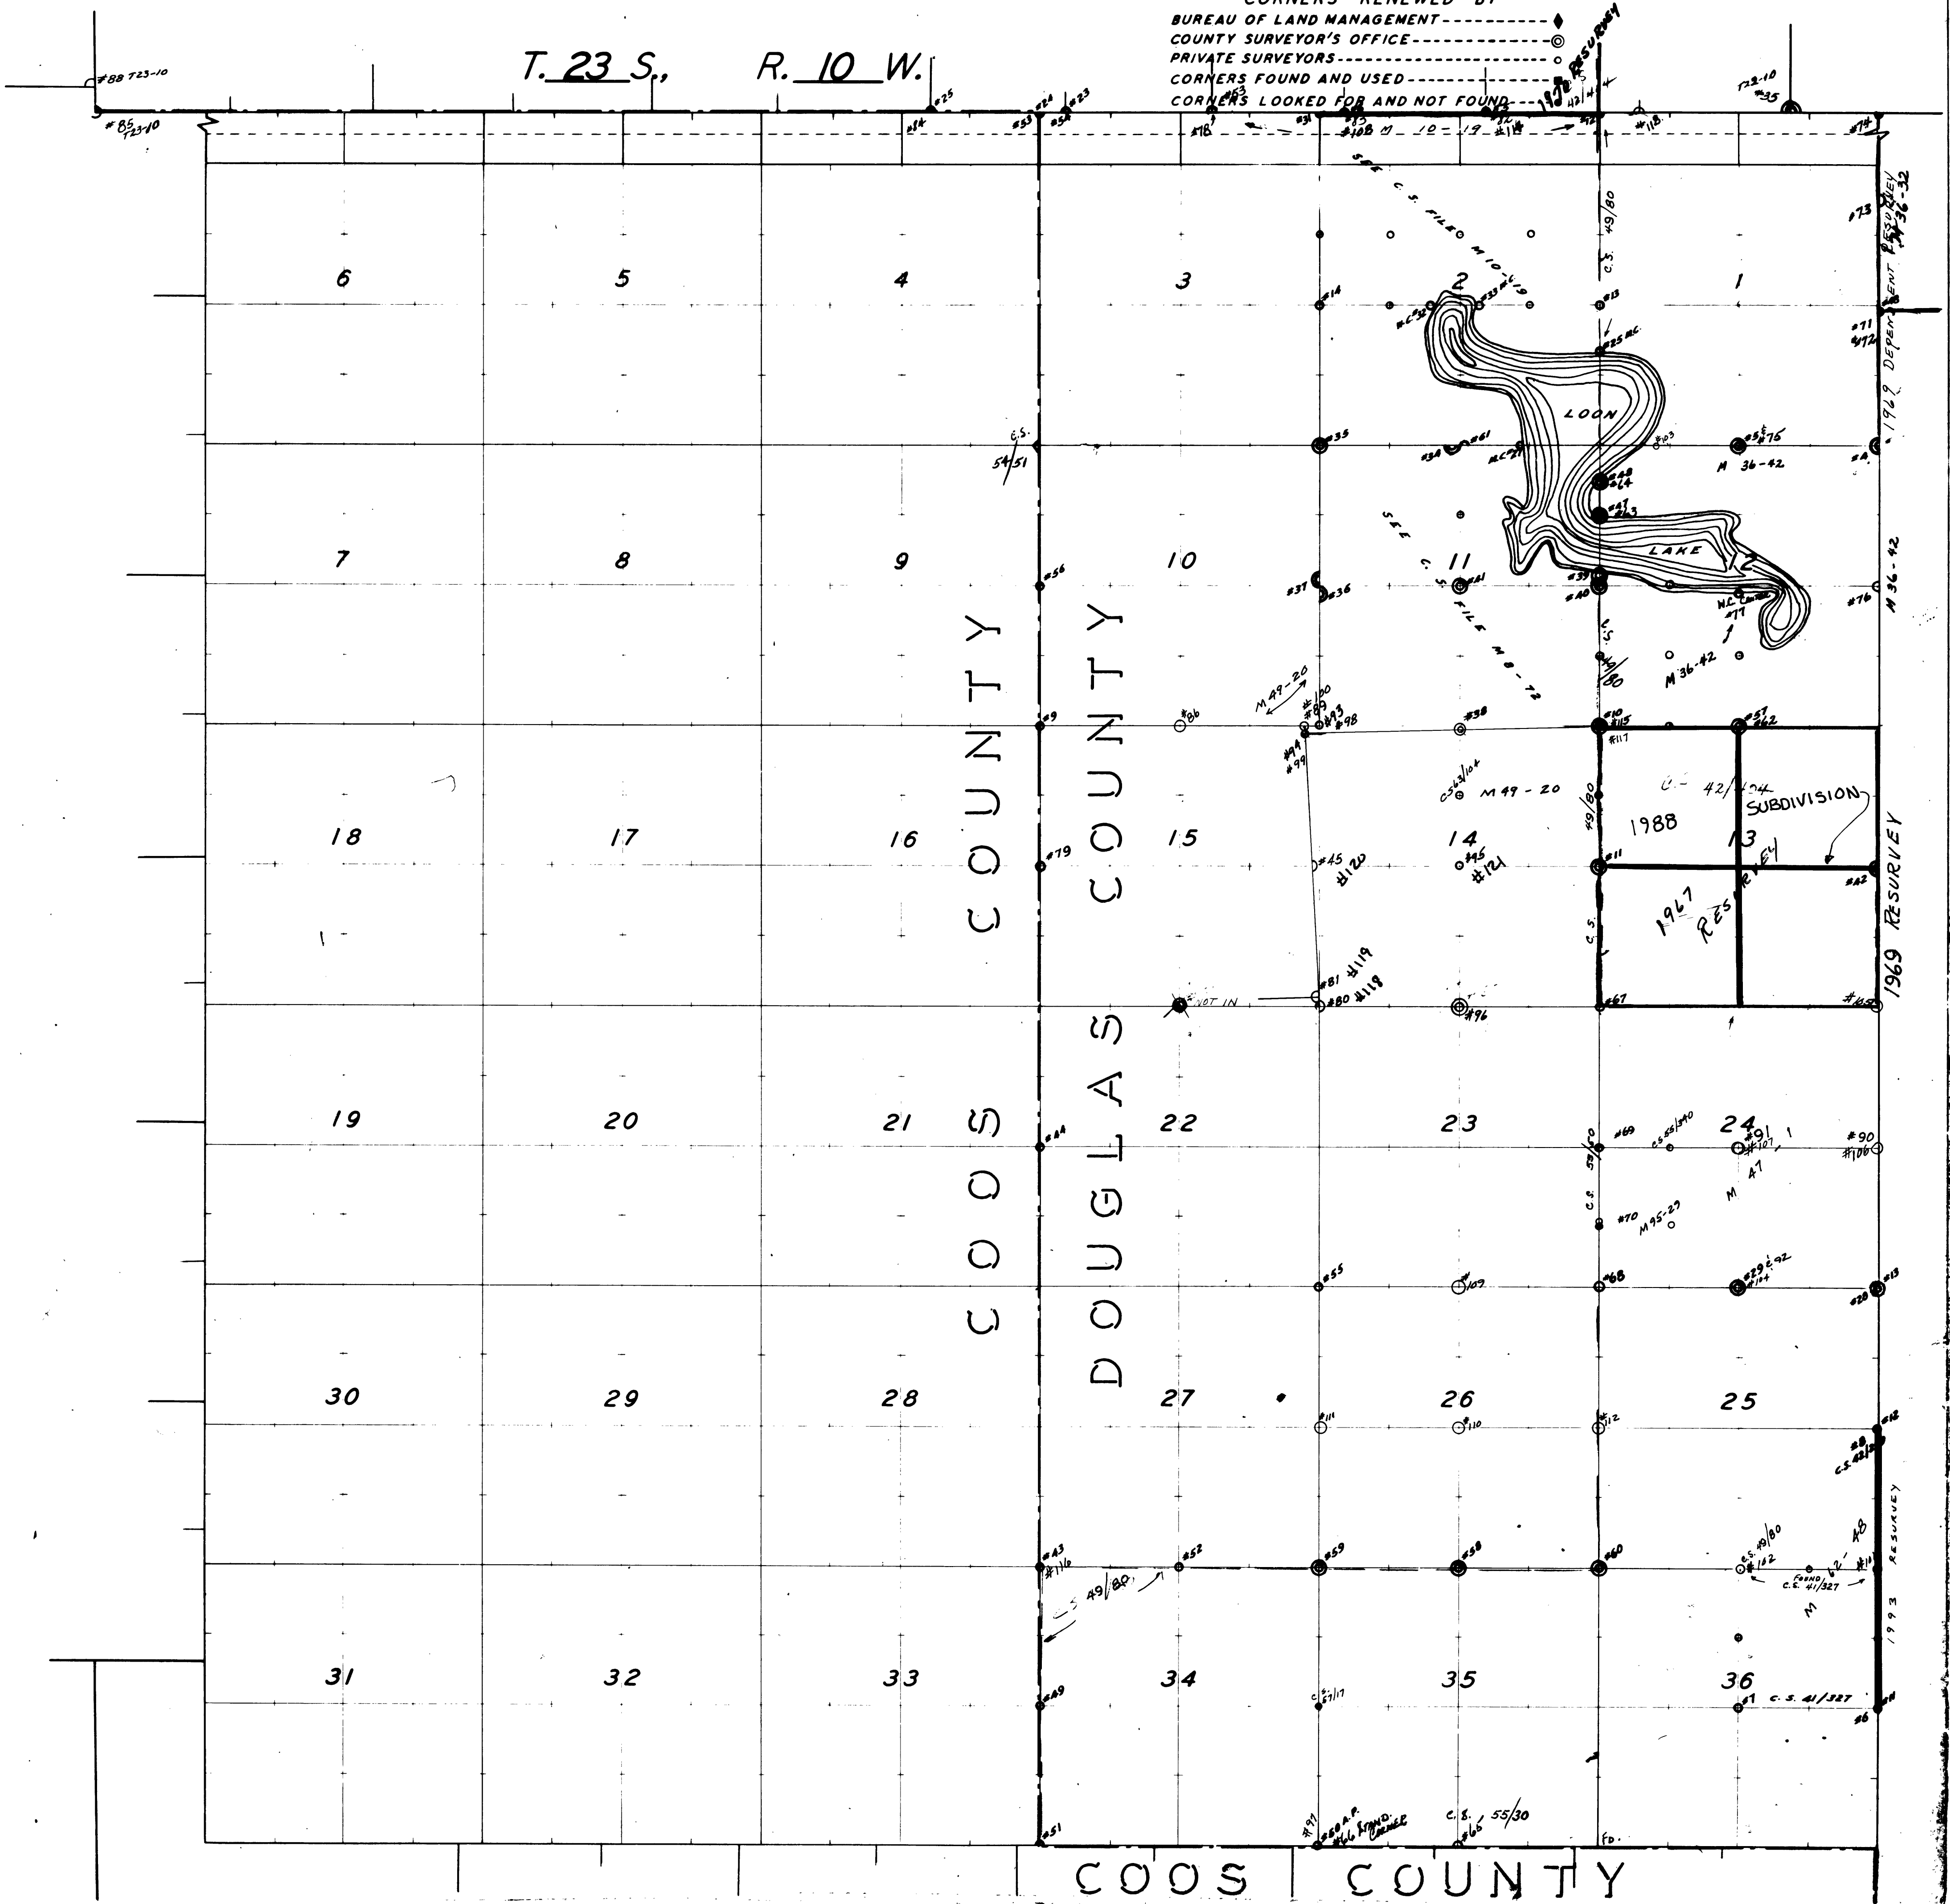

COOS COUNTY