

Douglas County Surveyor's Record of
Government Corners Renewed

24 T. S. 5 R. W. W. M.

KOKE-CHAPMAN CO., EUGENE, ORE. 21881

James W. Byron
Milo Godfrey
S. A. Bilow
April 3, 1959
C.S. File 49/124

(continued)

New BT's: 6" W. Oak bears S.13°E. 10.4 ft. scribed S25 T24S R5W CS BT.
9" W. Oak bears N.28½°E. 24.1 ft. scribed S24 T24S R5W CS BT.
8" W. Oak bears S.14°W. 14.5 ft. scribed S26 T24S R5W CS BT.
8" W. Oak bears N.79½°W. 31.2 ft. scribed S23 T24S R5W CS BT.

Note - Corner 1 foot East of N.S. Fence.

James W. Byron
S. A. Bilow
May 1, 1959
C. S. File No. 49/124

Section Corner to Sections 18 & 19, T24S R5W, & Secs. 13 & 24, T24S R6W.
Found - Frear's BT's thus:

10", now 16" W. Oak N.54°W. 30.0 ft., I open & find good scribing "BT".

48", now badly burned Oak Stub N.62½°E. 32.5 ft. I find Stump Hole that checks bearing & distance for S.W. BT.

12", now 18" B. Oak bears S.44°E. 42.9 ft. Frear's record S.81°E. 42.9 ft., shows good scar, I do not open.

Note - I do not find Stone Set at Corner by Frear.

Set Brass Cap at Corner Mkd: County Surveyor's Office, 1959

	S13	S18	T24S
	S24	S19	R5W

New BT's: 20" W. Oak bears S.41°W. 44.3 ft. scribed S24 T24S R6W CS BT.
9" W. Oak bears N.42°E. 56.5 ft. scribed S18 T24S R5W CS BT.
16" W. Oak bears N.54°W. 30.3 ft. scribed S13 T24S R6W CS BT.

Note: See Sketch in file.

James W. Byron, Deputy
S. A. Bilow
May 14, 1959
C. S. File No. 49/124

Section Corner to Sections 30 & 31, T24S R5W, & Secs. 25 & 36, T24S R6W.
Found - All Four Orig. BT's:


Orig. 16", now 26" B. Oak South 53.5 ft., I open & find good scribing "S3".

Orig. 7", now 20" B. Oak N.30°W. 48.8 ft., shows good scar. I do not open.

Orig. 40", now 50" W. Oak S.64°E. 42.2 ft., shows good scar. I do not open.

Orig. 30", now 36" W. Oak Snag, shows scar, N.35°E. 20.5 ft.

Note Fence Corner Thus:

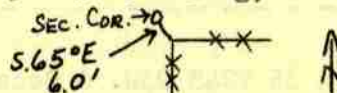

Set Brass Cap at Corner Mkd: County Surveyor's Office, 1959

	S25	S30	T24S
	S36	S31	R5W

New BT's: 20" R. Fir bears S.65°W. 37.0 ft. scribed S36 T24S R6W CS BT.
Rescribe now 20" B.O. N.28½°W. 51.0 ft. scribed S25 T24S R6W CS BT.
20" W. Oak N. 2°W. 53.8 ft. scribed S25 T24S R6W CS BT.
10" W. Oak S.31°E. 9.0 ft. scribed S31 T24S R5W CS BT.

¼ Section Corner to Section 30, T24S R5W, & Sec. 25, T24S R6W.

Found - Both Orig. BT's.:

14", now 44" Y. Oak S.82°E. 44.2 ft.

Orig. 36", now 50" W. Oak S.26°W. 110.2 ft. I open & find good scribing "BT".

Set Brass Cap at Corner Mkd: County Surveyor's Office, 1959,
¼ S25/S30 T24S
R6W R5W

New BT's: 15" B. Oak bears S.29°W. 10.5 ft. scribed ¼ S25 CS BT.
9" W. Oak bears S.53°E. 21.5 ft. scribed ¼ S30 CS BT.

James W. Byron
Milo Godfrey
S. A. Bilow
C. Putnam
June 29, 1959
C.S. File 49/124

N. E. Corner of D.L.C. No. 42

Found - Orig. 24", now 48" B. Oak bears S.30°W. 46.2 ft. Opened years ago, shows good reverse scribing "2 5 S T".

No trace of Orig. S.E. BT.

Set Brass Cap at Corner Mkd: N.E. Cor. DLC 42 T24S R5W County Surveyor's Office, 1959

NEW BT's: 28" W. Oak bears S.70°E. 58.0 ft. scribed NE CL 42 CS BT.

Note - Scribing above & below opening made in search for evidence of original scribing (none found)

5" W. Oak bears S.65°W. 34.9 ft. scribed CL42 CS BT.

