

**Douglas County Surveyor's Record of
Government Corners Renewed**

24 T. S. 5 R. W. W. M.

KOKE-CHAPMAN CO., EUGENE, ORE. 21881

49

Section Corner to Sections 10, 11, 14, and 15.
 Found - All 3 Orig. BT's. I open Orig. 20", now dead 40" B.Oak,
 S.74°W. 124.7 ft. & find good scribing. Orig. S.E. BT.
 alive, shows good scars. I do not open.
 Orig. N.E. BT., center rotted previously opened., All
 check record bearing & distance.
 Corner 20.4 ft. North of Fence.

Set Brass Cap at Corner Mkd: County Surveyor's Office, 1960

S10	S11	T24S
S15	S14	R5W


New BT's: 18" R.Fir bears S.29°E. 18.9 ft. scribed S14 T24S R5W CS BT.
 12" Laurel " S.17°W. 19.7 ft. scribed S15 T24S R5W CS BT.
 6" R.Fir bears N.45°W. 22.9 ft. scribed S10 CS BT.
 17" R.Fir bears N.79°E. 39.9 ft. scribed S11 T24S R5W CS BT.

RENEWED SECTION CORNER NO. #103

50

$\frac{1}{4}$ Corner to Sections 14 and 15.
 Found - Orig. 20", now 36" B. Oak N. 54 $\frac{1}{2}$ °E. 68.6 ft., recently
 felled. I open & find good scribe marks.
 No trace of Orig. N. W. BT. found.

Note: Corner Thus:

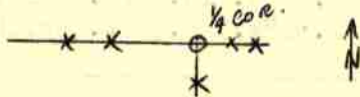

Set Brass Cap at Corner Mkd: County Surveyor's Office, 1960


$\frac{1}{4}$ S15/S14	T24S	R5W
-----------------------	------	-----

New BT's: 8" W.Oak bears S.72°W. 15.4 ft. scribed $\frac{1}{4}$ S15 CS BT.
 8" W.Oak bears S.55°E. 50.7 ft. scribed $\frac{1}{4}$ S14 CS BT.

51

Section Corner to Sections 14, 15, 22, and 23.
 Found - Orig. 12", now 30" B.Oak N.24°W. 156.4 ft. I open &
 find good scribing "W".
 Find Stump Hole & remains of large Oak S.56°E. 21.8 ft.,
 record S.56°W. 21.8 ft.
 No trace of Orig. NE BT. found.

Fences Thus:

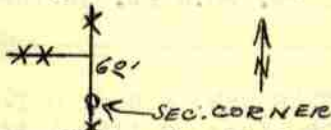

Set Brass Cap at Corner Mkd: County Surveyor's Office, 1960

S15	S14	T24S	R5W
S22	S23		

New BT's: 14" W.Oak bears N.58°E. 45.5 ft. scribed S14 T24S R5W CS BT.
 14" W.Oak bears S.21°E. 63.8 ft. scribed S23 T24S R5W CS BT.
 10" W.Oak bears S.57°W. 49.6 ft. scribed S22 T24S R5W CS BT
 16" W.Oak bears N.54°W. 40.0 ft. scribed S15 T24S R5W CS BT

52

$\frac{1}{4}$ Section Corner to Sections 23 and 24.
 Found - Orig. 6", now 18" W.Oak N.77°W. 85.8 ft. I open & find
 good scribing "S".
 Orig. S.W. BT. not found.

Set Brass Cap at Corner Mkd: County Surveyor's Office, 1960

$\frac{1}{4}$ S23/S24	T24S	R5W
-----------------------	------	-----

New BT's: 14" W. Oak bears N.69°E. 20.6 ft. scribed $\frac{1}{4}$ S24 CS BT.
 11" W.Oak bears N. 68°W. 49.0 ft. scribed $\frac{1}{4}$ S23 CS BT.

53

Section Corner to Sections 13, 14, 23, and 24.
 Found - Orig. 9", now 20" W.Oak S.41°E. 87.1 ft. I open & find
 good scribing "W".
 Orig. N.E. BT., now shell of old Stump only. No trace
 of Orig. N.W. nor S.W. BT's. found.

Set Brass Cap at Corner Mkd: County Surveyor's Office, 1960

S14	S13	T24S
S23	S24	R5W

New BT's: 6" W.Oak bears S.62°E. 19.6 ft. scribed S24 T24S R5W CS BT.
 7" W.Oak bears S.35°W. 8.2 ft. scribed S23 T24S R5W CS BT.
 7" W.Oak bears N.52°W. 16.7 ft. scribed S14 T24S R5W CS BT.
 R.Fir bears N.17 $\frac{1}{2}$ °E. 125.4 ft. scribed S13 T24S R5W CS BT.

James W. Byron, Deputy County Surveyor
 Milo Godfrey
 Clete Putnam
 March 1960
 C. S. File No. 49/124