


Douglas County Surveyor's Record of  
Government Corners Renewed

24 T. S. 6 R. W. W. M.

KOKE-CHAPMAN CO., EUGENE, ORE. 97196

56

$\frac{1}{4}$  Section Corner to Sections 20 & 21.  
Found - Orig. 12", now 20" B. Oak Snag N.17°W. 53.5 ft., I open  
& find good scribing "1/2 S". I find stump hole that  
checks bearing & dist. for Orig. N.E. BT.  
Set Brass Cap at Corner Mkd: County Surveyor's Office, 1959,  
 $\frac{1}{4}$  S20/S21 T24S R6W.  
New BT's: 10" W. Oak bears N.26°E. 8.0 ft. scribed  $\frac{1}{4}$  S21 CS BT.  
10" W. Oak bears S.48°W. 5.4 ft. scribed  $\frac{1}{4}$  S20 CS BT.  
Fence Corner Thus:

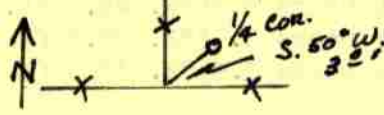

57

Section Corner To Sections 17, 18, 19, & 20.  
Found - 14" x 10" x 5" Stone at Corner with "F" chisled on North  
Slope.  
Orig. 20", now 40" Fir S.69°W. 89.1 ft., shows scar, I  
do not open.  
Orig. 14", now 36" Fir, previously opened, shows good  
scribe "T24S S17".  
Note - I check distances by measuring on Slope to both BT's.  
Base of Large Laurel Stump that checks bearing & distance  
for Orig. S.E. BT.  
Set Brass Cap alongside Corner Stone Mkd: County Surveyor's Office,  
1959 T24S R6W 

S18	S17
S19	S20

  
New BT's: 3" Laurel bears N.51°E. 45.7 ft. scribed S17 CS BT.  
3" Laurel bears N.18°W. 35.5 ft. scribed S18 CS BT.  
4" Laurel bears S.17 $\frac{1}{2}$ °E. 66.4 ft. scribed S20 CS BT.

58

$\frac{1}{4}$  Section Corner to Sections 18 & 19.  
Found - 1" x 12" x 24" Stone at Corner & both Orig. BT's;  
Orig. 54", now 72" Fir Snag N. 6°E. 107.6 ft., shows scar.  
Orig. 27", now 56" B. Oak S.18°50'E. 123.4 ft., shows  
reverse scribing "1/2 S".  
Note - Record distances are slope distances.  
Set Brass Cap alongside Corner Stone Mkd:  $\frac{1}{4}$ 

S18	T24S R6W
S19	

  
County Surveyor's Office, 1959  
New BT's: 20" R. Fir bears N.71°W. 49.0 ft. scribed  $\frac{1}{4}$  S18 CS BT.  
8" B. Oak bears S.38°E. 76.1 ft. scribed  $\frac{1}{4}$  S19 CS BT.  
Note - I find  $\frac{3}{4}$ " I. R. bears S.21°E. 55.0 ft. Maybe set for corner.

59

Section Corner to Sections 16, 17, 20, & 21.  
Found - Old  $\frac{3}{4}$ " I. Pipe at Corner.  
Orig. 10", now 24" Laurel S.15 $\frac{1}{2}$ °E. 25.7 ft., center  
burned out, shows two good scars, no scribing found.  
Also find badly burned Stumps that check bearings &  
distances, sizes for Cole's BT's. & for Orig. N.W. BT. *Ren #4*  
I chained East from Top of Ridge checks call.  
Set Brass Cap at Corner Mkd: 

S17	S16	T24S R6W
S20	S21	County Surveyor's
Office, 1959		

  
New BT's: 12" Maple bears S.42°W. 24.0 ft. scribed S20 CS BT.  
Rescribe 24" Laurel S.15 $\frac{1}{2}$ °E. 26.7 ft. S21 T24S R6W CS BT.  
Drive 6" Boat Spike in CTR. 40" Fir Stump bears N.83°E. 58.0'  
not scribed.  
Chisled 3" Cross and "B.O.# on North Face 3'x5'x5' Sandstone,  
bears S.70°W. 13.3 ft.

60

Section Corner to Sections 18 & 19, R6W, and Secs. 13 & 24, R7W.  
Found - Orig., Whipple, 20", now 34" down Fir S.66°E. 155.8 ft.  
Most of old face burned, but I do find good scribing "R".  
No trace of Orig. S.W. or N.E. BT's.  
Shell of Oak Stump that checks bearing & distance for NW BT.  
Set Brass Cap at Corner Mkd: County Surveyor 

S13	S18	T24S
R7W	S24	S19 R6W

  
Office, 1959

FD. OK 12-92  
R. Dolan  
M 116 - 38

(continued next page)

James W. Byron, Deputy  
Milo Godfrey  
S. A. Bilow  
March 26, 1959  
C. S. File No. 49/83