

Douglas County Surveyor's Record of
Government Corners Renewed

24 T. S. 6 R. W. W. M.

KOKE-CHAPMAN CO., EUGENE, ORE. 21881


(continued)

James W. Byron
Milo Godfrey
S. A. Bilow
March 26, 1959
C. S. File No. 49/83

New BT's: 6" W. Oak bears N.81°E. 62.8 ft. scribed S18 T24S R6W CS BT.
6" W. Oak bears N.42°W. 45.6 ft. scribed S13 T24S R7W CS BT.
4" W. Oak bears S.69°W. 28.2 ft. scribed S24 T24S R7W CS BT.
6" R. Fir bears S.11½°E. 38.5 ft. scribed S19 T24S R6W CS BT.

Note - This corner renewed by Evans, 1953, however, at this time, I find no evidence on Snag used by Evans to indicate it to be a B.T. Today, I talked to Mr. McHughill, who was with Evans just prior to the 1953 renewal. He states that there was no evidence the Snag used by Evans was a B.T. at that time. Also, it appears, Evans used the distance recorded by Elder & Gile for a B.T. recorded by Whipple.

Evans Corner bears N.69°E. 99.8 ft. I destroy all evidence of his corner. Fence Corner thus:

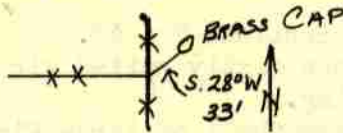

FD OR M121-64 APR 1994

61

Sec. Cor. to Secs. 13 & 24, T24S R6W, & Secs. 18 & 19, T24S R5W.
Found - Frear's BT's thus:

10", now 16" W. Oak N.54°W. 30.0 ft., I open & find good scribing "BT".
48", now badly burned Oak Stub N.62½°E. 32.3 ft. I find Stump Hole that checks bearing & distance for S.W. BT.
12", now 18" B. Oak bears S.44°E. 42.9 ft., Frear's record S.81°E. 42.9 ft., shows good scar, I do not open.

Note - I do not find Stone Set at corner by Frear.

Set Brass Cap at Corner Mkd: County Surveyor's

	S13	S18	T24S
R6W	S24	S19	R5W

New BT's: 20" W. Oak bears S.41°W. 44.3 ft. scribed S24 T24S R6W CS BT.
9" W. Oak bears N.42°E. 56.5 ft. scribed S18 T24S R5W CS BT.
16" W. Oak bears N.54°W. 30.3 ft. scribed S13 T24S R6W CS BT.

Note - See Sketch in File.


James W. Byron
S. A. Bilow
May 1, 1959
C. S. File No. 49/124

Section Corner to Secs. 25 & 36, T24S R6W, & Secs. 30 & 31, T24S R5W.

Found - All Four Orig. BT's:

Orig. 16", now 26" B. Oak South 53.5 ft., I open & find good scribing "S3".
Orig. 7", now 20" B. Oak N.30°W. 48.8 ft., shows good scar. I do not open.
Orig. 40", now 50" W. Oak S.64°E. 42.2 ft., shows good scar. I do not open.
Orig. 30", now 36" W. Oak Snag, shows scar, N.35°E. 20.5 ft.

Note - Fence Corner thus:

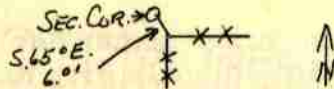

Set Brass at Corner Mkd: County Surveyor's Office, 1959

	S25	S30	T24S
R6W	S36	S31	R5W

New BT's: 20" R. Fir bears S.65°W. 37.0 ft. scribed S36 T24S R6W CS BT.
Rescribed now 20" B.O. N.28½°W. 51.0 ft. scribed S25 T24S R6W CS BT.
20" W. Oak N. 2°W. 53.8 ft. scribed S25 T24S R6W CS BT.
10" W. Oak S.31°E. 9.0 ft. scribed S31 T24S R5W CS BT.

James W. Byron, Deputy
S. A. Bilow
May 14, 1959
C. S. File No. 49/124

¼ Section Corner to Sec. 30, T24S R5W, & Sec. 25, T24S R6W.

Found - Both Original BT's:

14", now 44" Y. Oak S.82°E. 44.2 ft.
Orig. 36", now 50" W. Oak S.26°W. 110.2 ft. I open & find good scribing "BT".

Set Brass Cap at Corner Mkd: County Surveyor's Office, 1959

¼	S25/S30	T24S
R6W	R5W	

New BT's: 15" B. Oak bears S.29°W. 10.5 ft. scribed ¼ S25 CS BT.
9" W. Oak bears S.53°E. 21.5 ft. scribed ¼ S30 CS BT.

63