

Douglas County Surveyor's Record of
Government Corners Renewed

T. 24 S. T. S. R. 6 W. R.W.W.M.

KONE-CHAPMAN CO., EUGENE, ORE. 21881

Vernon "Ray"
Tracy
9/1/66
C.S. File
No. 52/102

1/4 Corner to Sec. 5, T24-6W. & Sec. 32, T23-6W. 87
Found - GLO Brass Cap mkd. T23S R6W 1/4 S32-5, T24-6W., 1957.
16", now 18" W. Fir Stump, S. 61° W. 52.8 ft., nearly healed blazes,
partial scribe marks visible.
Orig. N.E. BT. is stump. - Orig. S.E. BT., turned out
1957 N.W. BT., turned out.
New BT's: 9" Hemlock, S. 40 1/2° E. 30.8 ft. mkd. 1/4 S 5 CS BT.
10" D. Fir N. 38° W. 86.5 ft. mkd. 1/4 S 32 CS BT.
Note - Corner lies in old, logged-off unit.

Sept. 1, 1966

SEPT. '68

MICROFILM TO HERE 10/67

Vernon "Ray"
Tracy
5/8/69
C.S. File
No. 52/102


1/4 Corner Sections 33 & 34 88
Found - 1 1/4" I.P. set by Stewart in 1922
4 3/4" I.R. dropped inside. I.P. is broken & rusted through.
BT's as follows (See Ren. #11)
24" Now 24" W. Fir N. 42°W. 63.0" Only decayed remains--no scribe fd.
30" now 30" D Fir S. 66°W. 63.0" Now sawed stump--scribe mks visible
on burned & unhealed blaze.
Set - Brass cap at Cor. point 1" I.P. Mkd.

County Surveyors T24S
Office, 1969 1/4 S33/S34 R6W

Mkd new BT's
8" D. Fir N. 41°W. 37.3 Ft. Mkd. 1/4 S33 CS BT
10" D Fir S. 19°E. 11.4 Ft. Mkd. 1/4 S34 CS BT
Reset unrecorded I.R. along side. This cor. lies at fence Cor. E. & S.
5-8-69

89

N. W. Corner D. L. C. No. 41.
Found - 16", now 20" W. Oak West 9.9 ft., opened for scribe "BT". REN. #23
Set - Brass Cap at Cor. Mkd: County Surveyor's T 24 S R 6 W
Office, 1969 / N.W. Cor. DLC 41
New BT: 10" W. Oak N. 29°E. 6.5 ft. mkd: "NW DLC #41 CS BT.
This corner lies S. 45°E. 2.2 ft. from Fence Corner, fence running E-W & S.

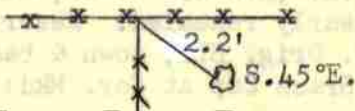

90

Section Corner to Sections 26 - 27 - 34 - 35.
Found - 16", now 40" B. Oak, S. 64°E. (Rec. S68 1/2 E) 57.4 ft., shows faint scar.
15" B. Oak, now dead, N. 13°E. (Rec. N 1E) 26.4 ft., prev. open,
found reverse scribe "B".
30" B. Oak, now rotten stump, N. 68°W. 31.0 ft., no marks found.
S.W. BT., down & rotten, hits fair for bearing S. 37 1/2°W. 206.6 ft.
Set - Brass Cap at Cor. Mkd: County Surveyor's T 24 S R 6 W
Office S 27 | S 26
1969 S 34 | S 35
New BT's: 6" W. Oak S. 59 1/2°E. 21.3 ft. mkd: T24S R6W S35 CS BT.
11" D. Fir N. 20°E. 38.1 ft. mkd: T24S R6W S26 CS BT.
12" Laurel N. 43°W. 38.3 ft. mkd: T24S R6W S27 CS BT.
18" Laurel S. 79°W. 23.5 ft. mkd: T24S R6W S34 CS BT.
This corner lies 1.0 ft. S. of old fence corner, running N - E & W.

FO. B. L. 7/92
m. Helmberger m112-50

91

Section Corner to Sections 3 - 4 - 9 - 10.
Found - Orig. 40", now 48" Fir, alive, N. 86°50'W. 49.5 ft., bark scribe vis.
Orig. S.W. & S.E. BT's., now sawed stumps.
Orig. N.E. BT., now blow down.
Set - Brass Cap at Cor. Mkd: County Surveyor's T 24 S R 6 W
Office S 4 | S 3
1969 S 9 | S 10
New BT's: 32" D. Fir S. 36°W. 20.0 ft. mkd: T24S R6W S 9 CS BT.
22" D. Fir N. 50°W. 22.1 ft. mkd: T24S R6W S4 CS BT.
20" D. Fir N. 15°E. 38.3 ft. mkd: T24S R6W S 3 CS BT.
No trees available in Section 10 due to logging.
Good blazed Line North, cutting line S. & E.

FD. OK by:
H. JOHNSTONE
5-6-82
M 92-17
10/6/69

John M. Powell
Frank Jones & W. Penley
Sept. 12, 1969
C. S. File No. 52/102

Vernon "Ray" Tracy
Jack Heritage & V. Perron
Oct. 1969 C.S. File No. 52/102