

Douglas County Surveyor's Record of
Government Corners Renewed

T. 24. S. T. S. R. 7. W. R. W. W. M.

KOKE-CHAPMAN CO., EUGENE, ORE. 21681

James W. Byron, Deputy County Surveyor
Milo Godfrey and Clete Putnam
September 1960
C. S. File No. 49/41


South $\frac{1}{4}$ Corner to Section 32, T23-7W. 86
Found - $\frac{3}{4}$ " I.P. at Cor. & BT's. as recorded by Grant.
Base of large rotted Fir Stump that checks Orig. S.W. BT.
Note - Corner Pipe is alongside 8" Yewood Fence Post & is scribed $\frac{1}{4}$ " S32".
New BT: 10" W.Oak bears S.34 W. 29.0 ft. $\frac{1}{4}$ " S32 CS BT".

Corner to Sections 32 and 33 only, T23-7W. 87
Found - ~~II-I.P. at Cor. & BT.~~ Orig. 14", now 22" R.Fir N.45°W. 25.1 ft., shows
good bark scribing "3 T23S R7W".
Orig. 28", now 38" R.Fir S.75°E. 35.6 ft. , shows good bark scribing.
Orig. 8", now 3" Spike Stump of Orig. N.E. BT.
Orig. S.W. BT. not found.
Set - Brass Cap at Cor. Mkd: County Surveyor's Office, 1960 FD. OK 2/80
L. ROBERTS
M 84-57
S32/S33 T23S R7W
T24S
New BT's: 10" Cedar bears N.29°E. 35.9 ft. scribed S33 T23S R7W CS BT.
Rescribed , now 22" R.Fir N.45°W. 25.1 ft. S32 T23S R7W CS BT.

Corner to Sections 31 and 32 only. 88
Found - Orig. 16", now 30" W.Oak S.10°W. 35.6 ft. I open & fd. good scribing.
Orig. 30", now 52" Fir N.13°W. 105.6 ft., shows good scar.
Orig. 8", now 48" Fir shows good scar S.40°E. 137.3 ft.
Orig. N.E. BT. not found.
Set - Brass Cap at Cor. Mkd: County Surveyor's S31/S32 T23S R7W
Office, 1960 T24S
New BT's: 14" R.Fir bears N.14°E. 13.0 ft. scribed S32 T23S R7W CS BT.
10" W. Fir bears N.57 $\frac{1}{2}$ °W. 37.8 ft. scribed S31 T23S R7W CS BT.

Corner to Sec. 36 R8W. & Sec. 31, R7W. T23 89
Found - Orig. 16", now 36" Fir S.65°W. 38.9 ft. Previously opnd, Shows scribing.
Orig. N.E. & S. E. BT's., now rotted stumps only.
Orig. 14", now 30" Fir N.28°W. 72.6 ft., shows good scars.
Set - Brass Cap at Cor. Mkd: County Surveyor's Office, 1960
R8W S36/S31 R7W T23S
T24S
New BT's: 18" R.Fir bears N.72°E. 62.5 ft. scribed S31 T23S R7W CS BT.
12" R.Fir bears N.63°W. 53.6 ft. scribed S36 T23S R8W CS BT.
Find Corner Thus:
E. 216' S36/S31 T23S
S 1/S 6 T24S
Record 215.2 ft.

ORIG.
Closing Corner to Sections 5 and 4, T24-7W. 90
Found - 42", now 48" Fir S.36°E. 52.8 ft., shows good bark scrbing. "4S".
42", now down, 48" Fir S.10°W. 19.8 ft., bark sluffing off, no scrbing.
Set - Brass Cap at Cor. Mkd: County Surveyor's CC T23S R7W
Office, 1960 S 5/S 4 T24S
New BT's: 12" R.Fir bears S.54 $\frac{1}{2}$ °W. 21.4 ft. scribed CC S5 T24S R7W CS BT.
10" R.Fir bears N.39°W. 9.6 ft. scribed CC S4 S5 CS BT.
No trees suitable to S. E.
Note - Gov't. notes for this corner received by Co. Surv., Sept. 1960.
Stake set for corner & used by other bears S.56°E. 19.3 ft.

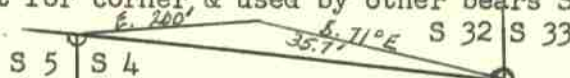

Closing Corner Sections 6 and 5. 91 No
Found - Stump Hole & pieces of badly burned Fir Stump S.12°E. 17.2 ft. mks.
No trace of S.W. BT. Point for corner falls 152.3 ft. due West
of Cor. To Secs. 31 & 32 only, T23-7W. (Gov't notes call for C.C. 2.30 chains
(151.8 ft.) west of Cor. Secs. 31 & 32). Since location is so close to
call from Orig. Cor., conclude stump hole was S.E. BT.
Set - Brass Cap at Cor. Mkd: County Surveyor's Office, 1963
T24S R7W CC S 6/S 5
New BT's: 18" D.Fir S.20°E. 11.1 ft. Mkd: T24S R7W CC S5 CS BT.
14" D.Fir S.39°W. 82.3 ft. Mkd: T24S R7W CC S6 CS BT.
An Iron Pipe ($\frac{3}{4}$ ") bears N.68°E. 2.3 feet.

Milo E. Godfrey, Deputy
V. Tracy & M. Stone
April 11, 1963
C. S. File No. 49/41

SEE
BLM NOTES
FOR "TRUE POINT"
FOR COR.
VAL. 32
PG. 13482