


T. 24 S., R. 9 W.

CORNERS RENEWED BY
 BUREAU OF LAND MANAGEMENT-----◆
 COUNTY SURVEYOR'S OFFICE-----⊙
 PRIVATE SURVEYORS-----○
 CORNERS FOUND AND USED-----■
 CORNERS LOOKED FOR AND NOT FOUND-----●

J. 23 8, 1897

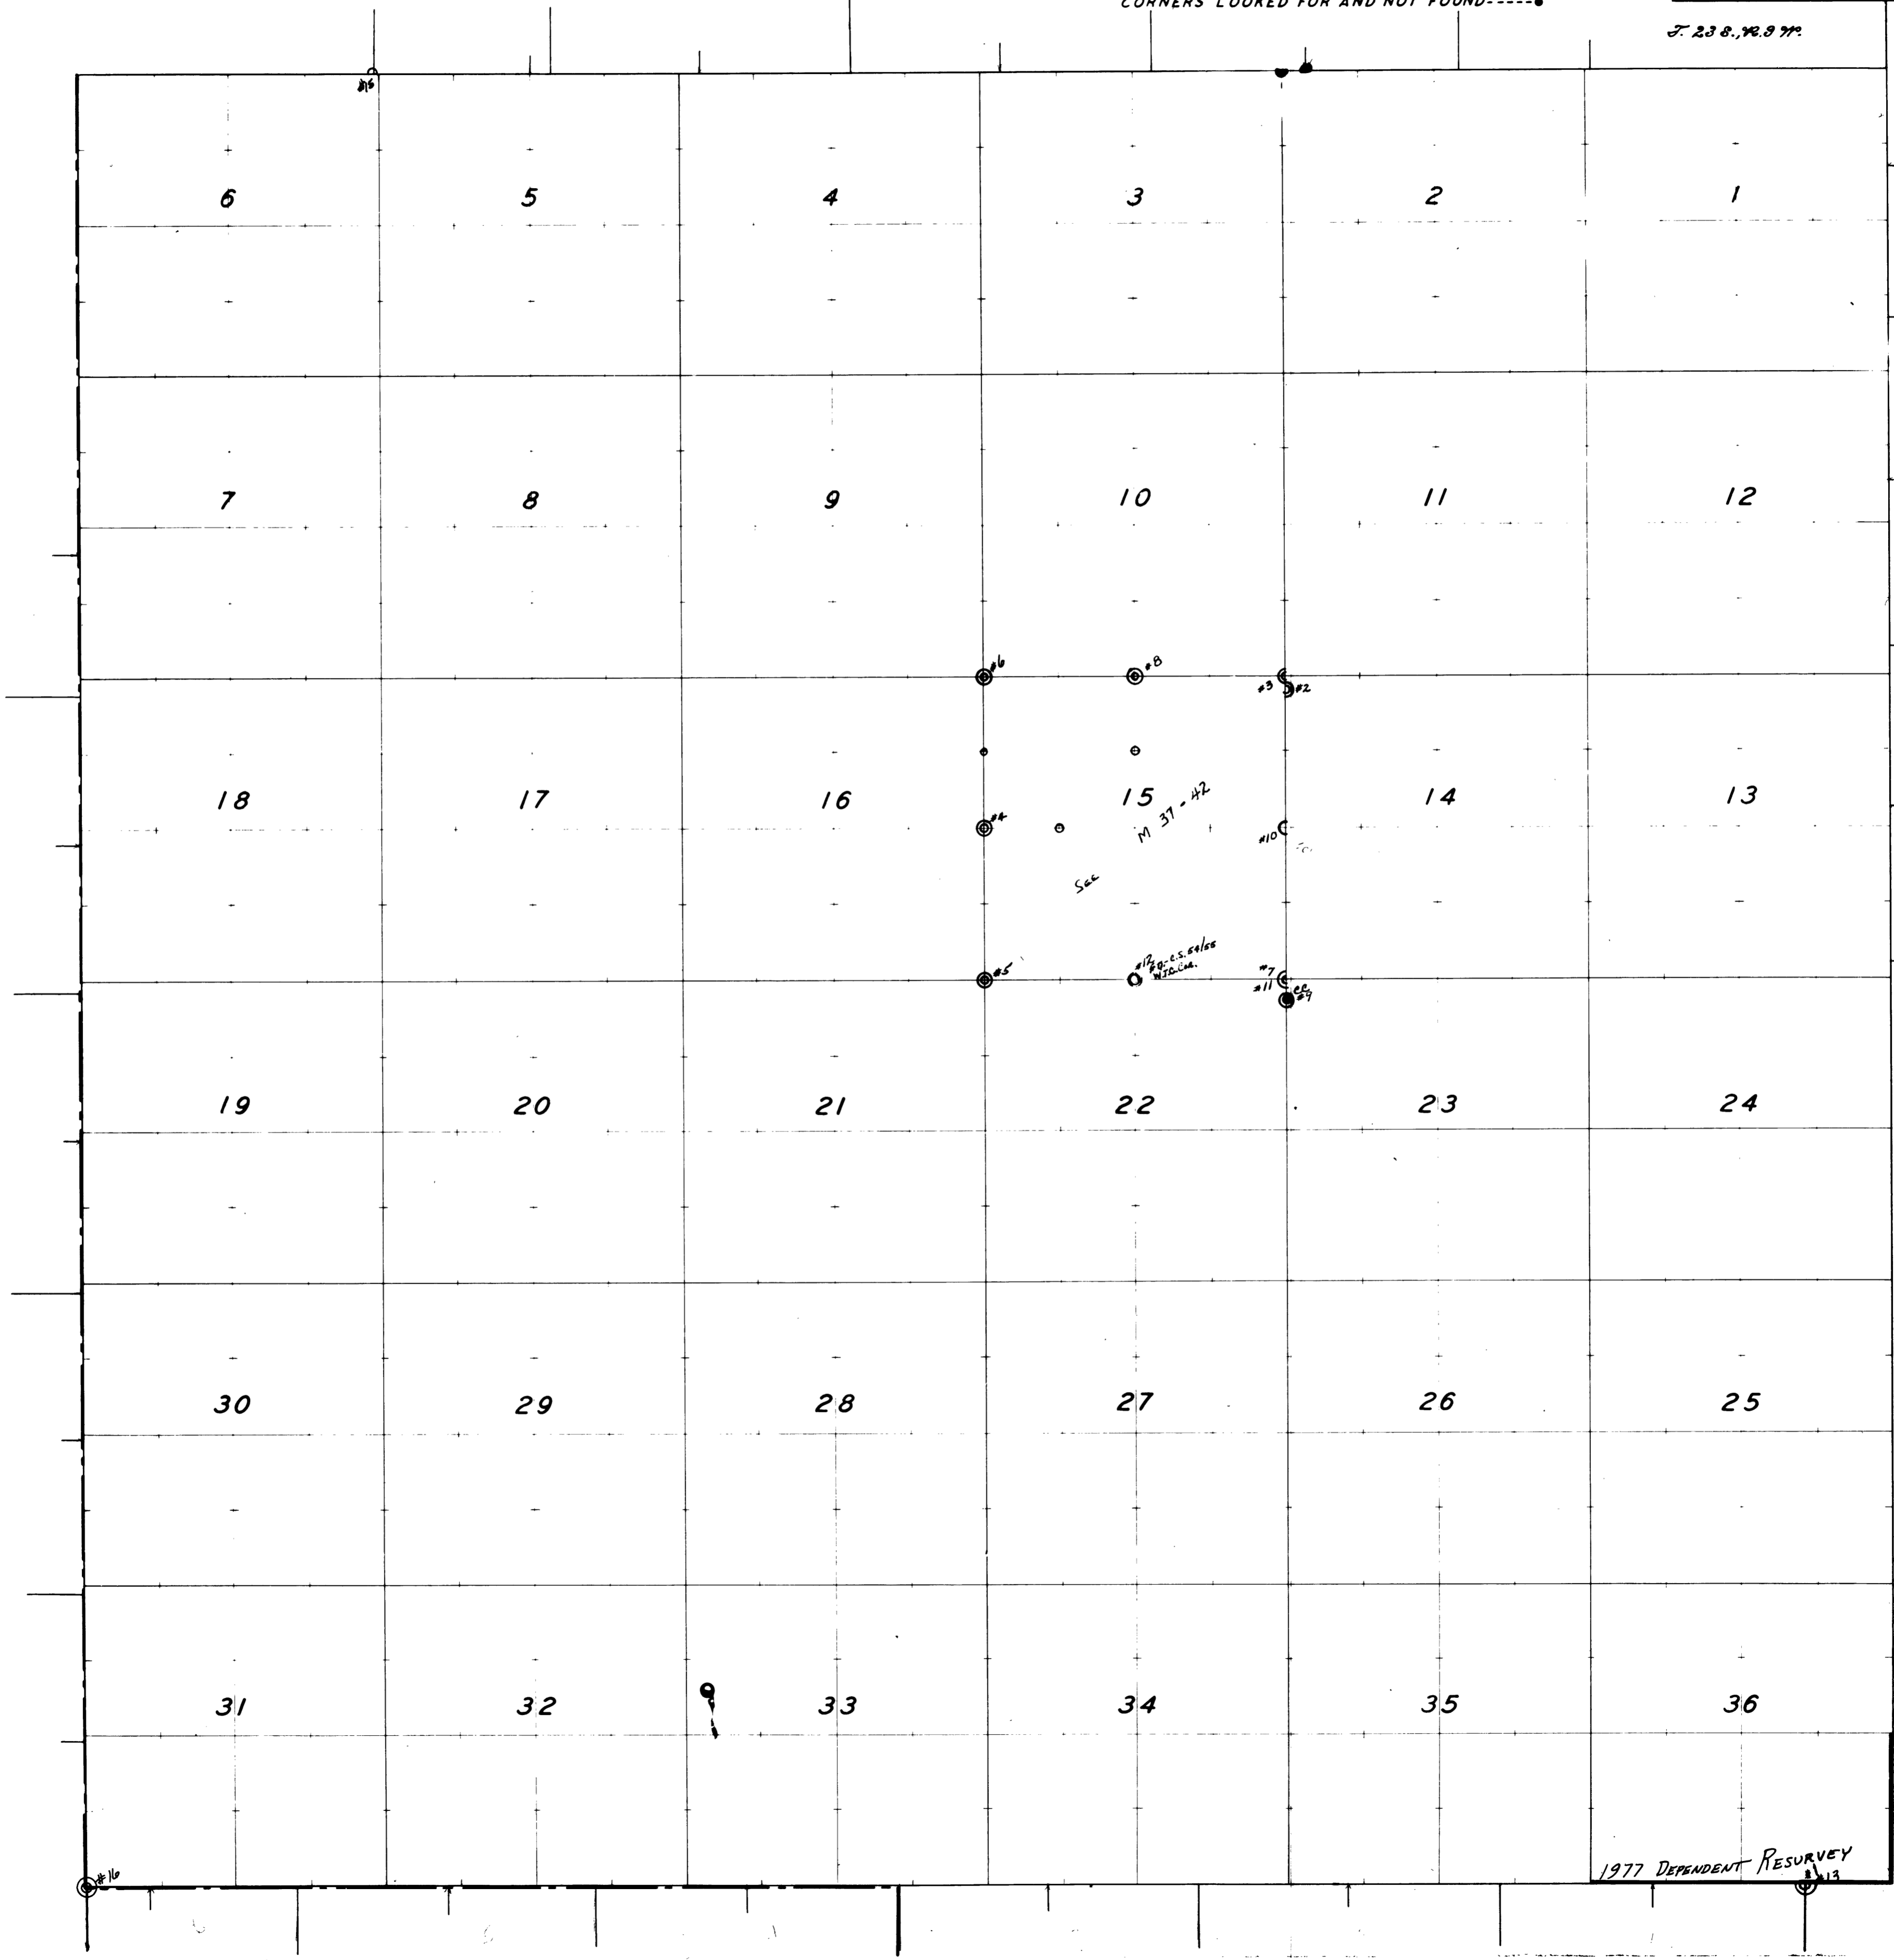

1977 DEPENDENT RESURVEY