


Douglas County Surveyor's Record of  
Government Corners Renewed

25 T. S. 5 R. W. W. M.

KOKE-CHAPMAN CO., EUGENE, ORE. 21881

1/4 Section Corner to Sections 8 and 9.  
Found - Frear's BT's, now stumps, & Iron Pipe at Corner. REN. #10  
Set Brass Cap at Corner & alongside Iron Pipe Mkd: Brass Cap:  
County Surveyor's Office, 1960. S9 T25S R5W.  
New BT's: 13" W.Oak bears N. 73°W. 74.0 ft. scribed 1/4 S 8 CS BT.  
3 1/2" B.Oak bears S. 8°E. 76.0 ft. scribed 1/4 S 9 CS BT.

**RE-RENEWED, SEE CORNER NO. #147**

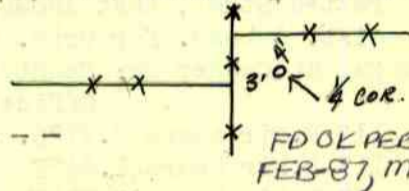


1/4 Corner to Sections 18 and 17.  
Found - 1/2" Iron Pipe 7.2 ft. North said to have been moved. REN. #19  
Find both BT's. as recorded by Epp. The S.E. BT. is now snag.  
Set Brass Cap at Corner Mkd: County Surveyor's Office, 1960  
S18/S17 T25S R5W.  
New BT's: 9" B.Oak bears N. 49 1/2°E. 29.0 ft. scribed 1/4 S17 CS BT.  
Note - Corner under N. S. Fence.

1/4 Section Corner to Sections 7 and 18.  
Found - 1 1/2" X Iron Pipe at corner & N.W. BT. as recorded, now 30" B.Oak  
Stump. I open & find good scribing "B". REN. #11  
No trace of SW. BT. found.  
Note - Corner is under N. S. Fence.  
New BT's: 20" B.Oak bears N. 36°W. 49.4 ft. scribed 1/4 S 7 CS BT.  
11" R.Fir bears S. 26°E. 46.7 ft. scribed 1/4 S18 CS BT.

Section Corner to Sections 10, 11, 14, and 15.  
Found - Auto Spring & squared Rock at Corner & Stump of Eppsteins. REN. #23  
Renewed Ash N. 13°E. 97.0 ft., shows good scribing.  
Also Stump of Original S. W. BT.  
Set Brass Cap alongside Auto Spring & Mark: County Surveyor's Office, 1960.  
S10 | S11 T25S R5W  
S05 | S14  
New BT's: 8" Ash bears S. 76°W. 98.5 ft. scribed S15 CS BT.  
5" Ash bears N. 30 1/2°W. 57.0 ft. scribed S11 CS BT.  
No trees near to N. E. or S. E.

**RE-RENEWED, SEE CORNER NO. #133**

Section Corner to Sections 9, 10, 15 and 16.  
Found - Orig. 12", now 28" W. Oak S. 81°W. 151.1 ft. I open & find  
good scribing "TS".  
Orig. NW BT., down & mostly rotted, no scribing found.  
Orig. SE. & NE BT's., now stump holes only.  
Set Brass Cap at Corner Mkd: County Surveyor's Office, 1960  
S 9 S10 T25S R5W  
S16 S15  
New BT's: 9" R.Fir bears S. 30°E. 17.4 ft. scribed S15 T25SR5W CS BT.  
19" R.Fir bears S. 23°W. 27.1 ft. scribed S16 T25S R5W CS BT.  
10" W.Oak bears N. 69°W. 42.8 ft. scribed S 9 T25S R5W CS BT.  
9" R.Fir bears N. 52 1/2°E. 38.3 ft. scribed S10 T25S R5W CS BT.

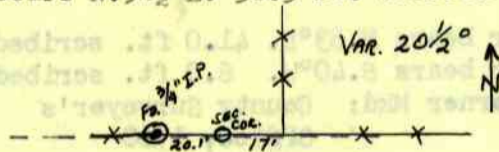

1/4 Section Corner to Sections 10 and 11.  
Found - Both of Theil's BT's. 24", now 30" W.Oak S. 42 1/2°E. 100.3 ft.,  
shows old face, center rotted. REN. #30  
20", now 30" Fir Stump S. 85°W. 78.5 ft. I open & find good  
scribing "BT".  
Corner Stone not found. Corner in Old Log Road. #134  
Set Brass Cap at Corner Mkd: County Surveyor's Office, 1960  
S10/S11 T25S R5W  
New BT's: 14" R.Fir bears N. 61 1/2°W. 27.7 ft. scribed 1/4 S10 CS BT.  
15" R.Fir bears N. 84°E. 18.6 ft. scribed 1/4 S11 CS BT.  
Note - Corner is 10 ft. south of E. W. Fence.

**RE-RENEWED, SEE CORNER NO. #134**

FD OK 2/27 Y.M. 1100 M 63-32

James W. Byron, Deputy  
Milo E. Godfrey  
Clete Putnam  
April 20, 1960  
C. S. File No. 49/124