


T. 25 S., R. 5 W.

CORNERS RENEWED BY  
 BUREAU OF LAND MANAGEMENT -----◆-----  
 COUNTY SURVEYOR'S OFFICE -----○-----  
 PRIVATE SURVEYORS -----○-----  
 CORNERS FOUND AND USED -----■-----  
 CORNERS LOOKED FOR AND NOT FOUND -----○-----

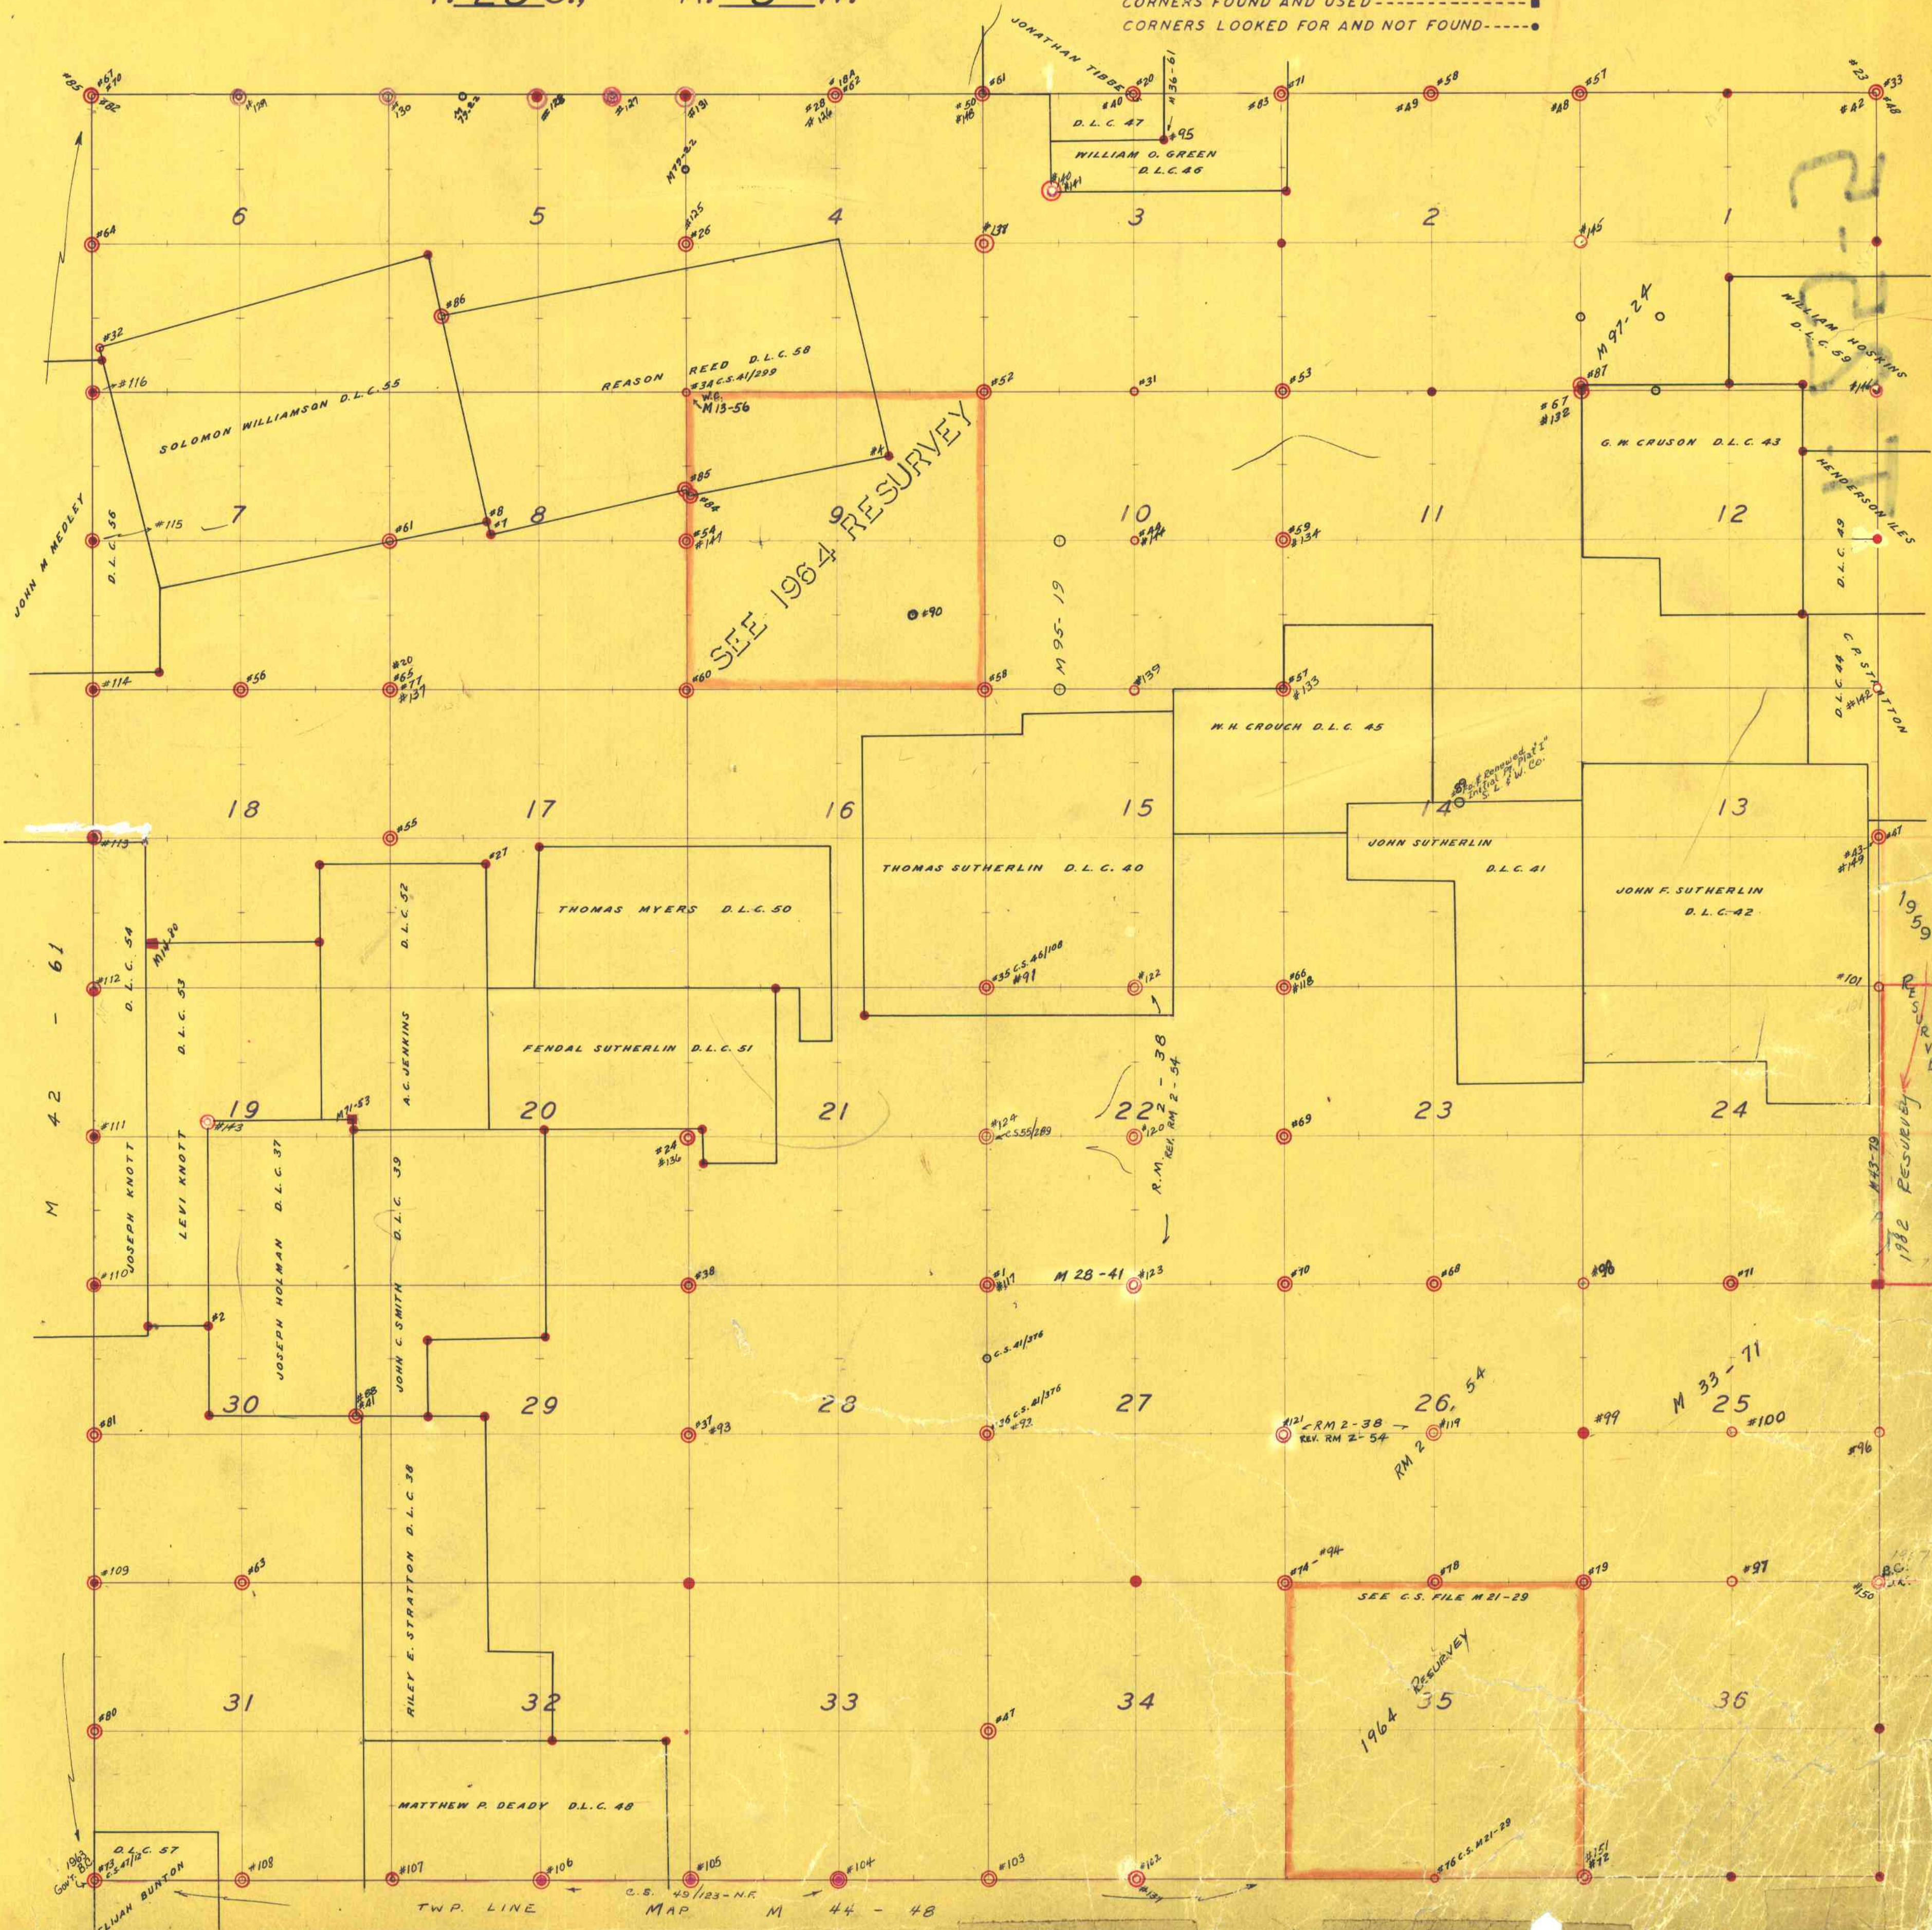

2  
 111  
 WILLIAM HOSKINS  
 D.L.C. 59

1959  
 RESURVEY  
 1762 RESURVEY  
 M 45-70

M 33-71  
 25  
 100

1964  
 RESURVEY  
 35

M  
 42 - 61

TWP. LINE  
 C.S. 49/123-N.F. MAP  
 M 44 - 48