


T. 25 S., R. 6 W.

CORNERS RENEWED BY
 BUREAU OF LAND MANAGEMENT -----◆-----
 COUNTY SURVEYOR'S OFFICE -----○-----
 PRIVATE SURVEYORS -----○-----
 CORNERS FOUND AND USED -----○-----
 CORNERS LOOKED FOR AND NOT FOUND -----●-----

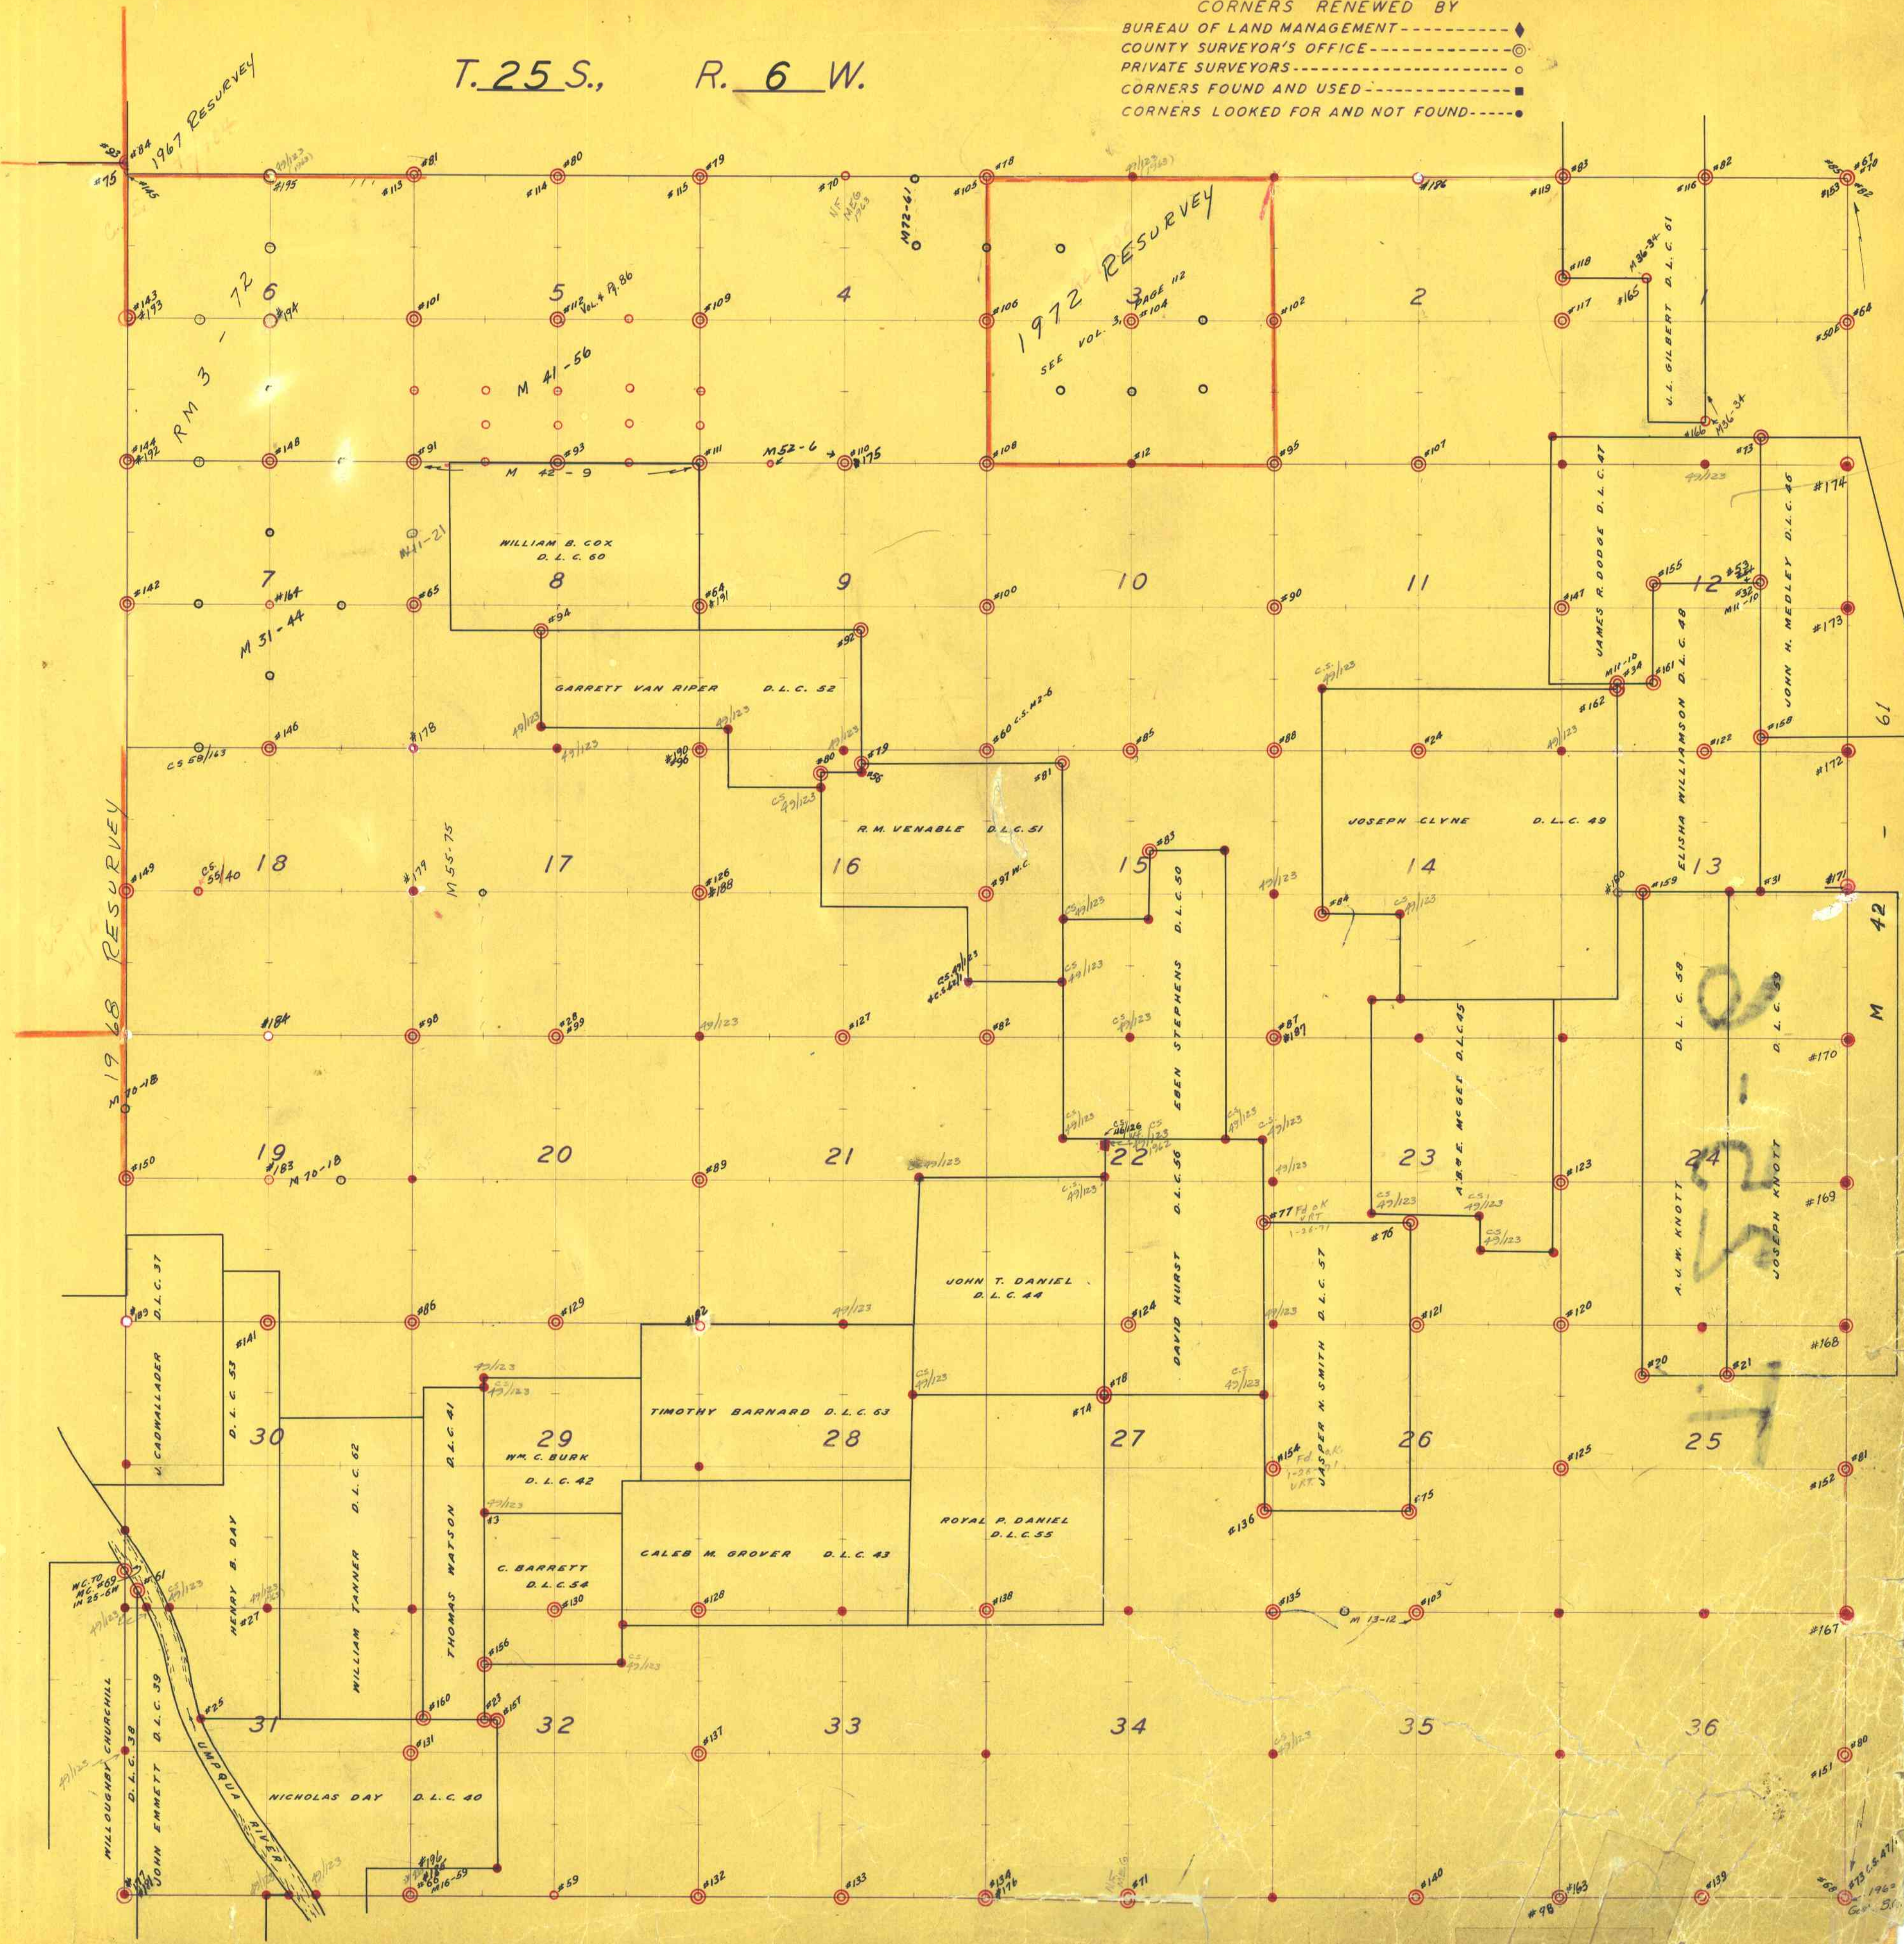

1968 RESURVEY

RM 3

1972 RESURVEY
 SEE VOL. 3, PAGE 112
 #104

2
 12
 13
 24
 25

1963
 Gen. 50