


T. 25 S., R. 6 W.

CORNERS RENEWED BY  
 BUREAU OF LAND MANAGEMENT -----◆-----  
 COUNTY SURVEYOR'S OFFICE -----○-----  
 PRIVATE SURVEYS -----○-----  
 CORNERS FOUND AND USED -----■-----  
 CORNERS LOOKED FOR AND NOT FOUND -----○-----

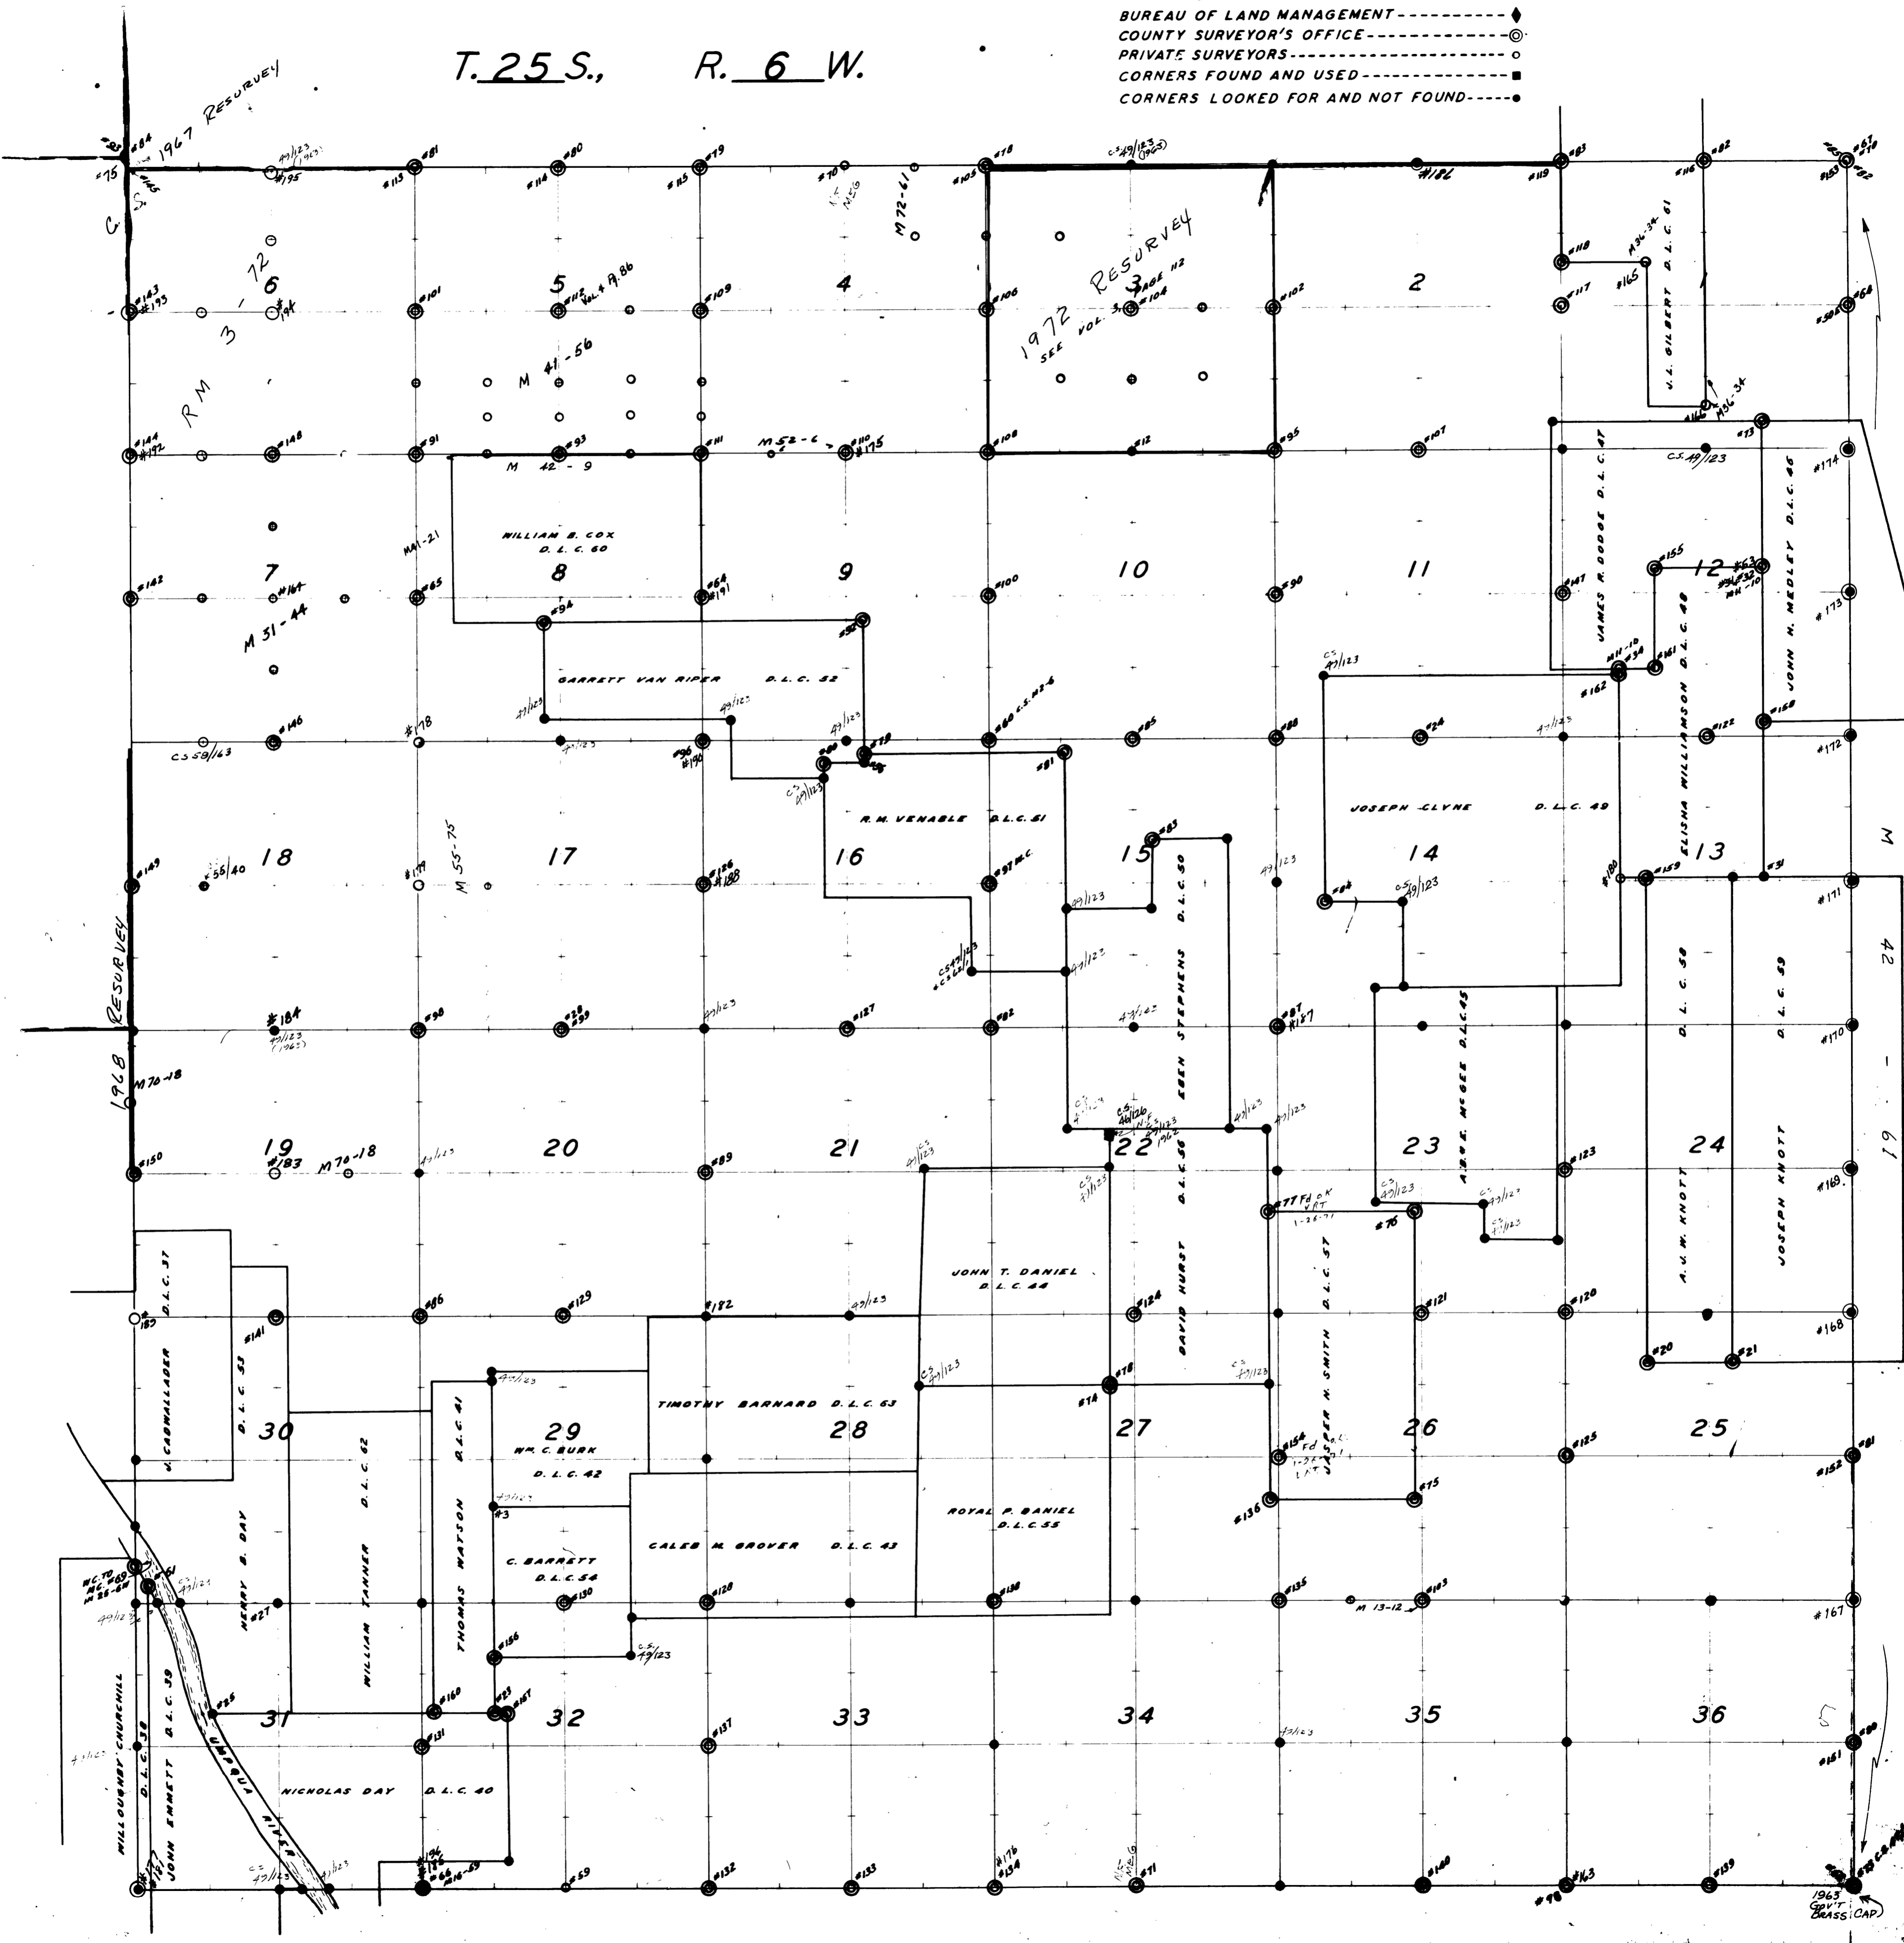

1963 GOV'T BRASS (CAP)