


T. 26 S., R. 2 W.

CORNERS RENEWED BY
BUREAU OF LAND MANAGEMENT ----->
COUNTY SURVEYOR'S OFFICE -----o
PRIVATE SURVEYORS -----o
CORNERS FOUND AND USED -----■
CORNERS LOOKED FOR AND NOT FOUND -----●

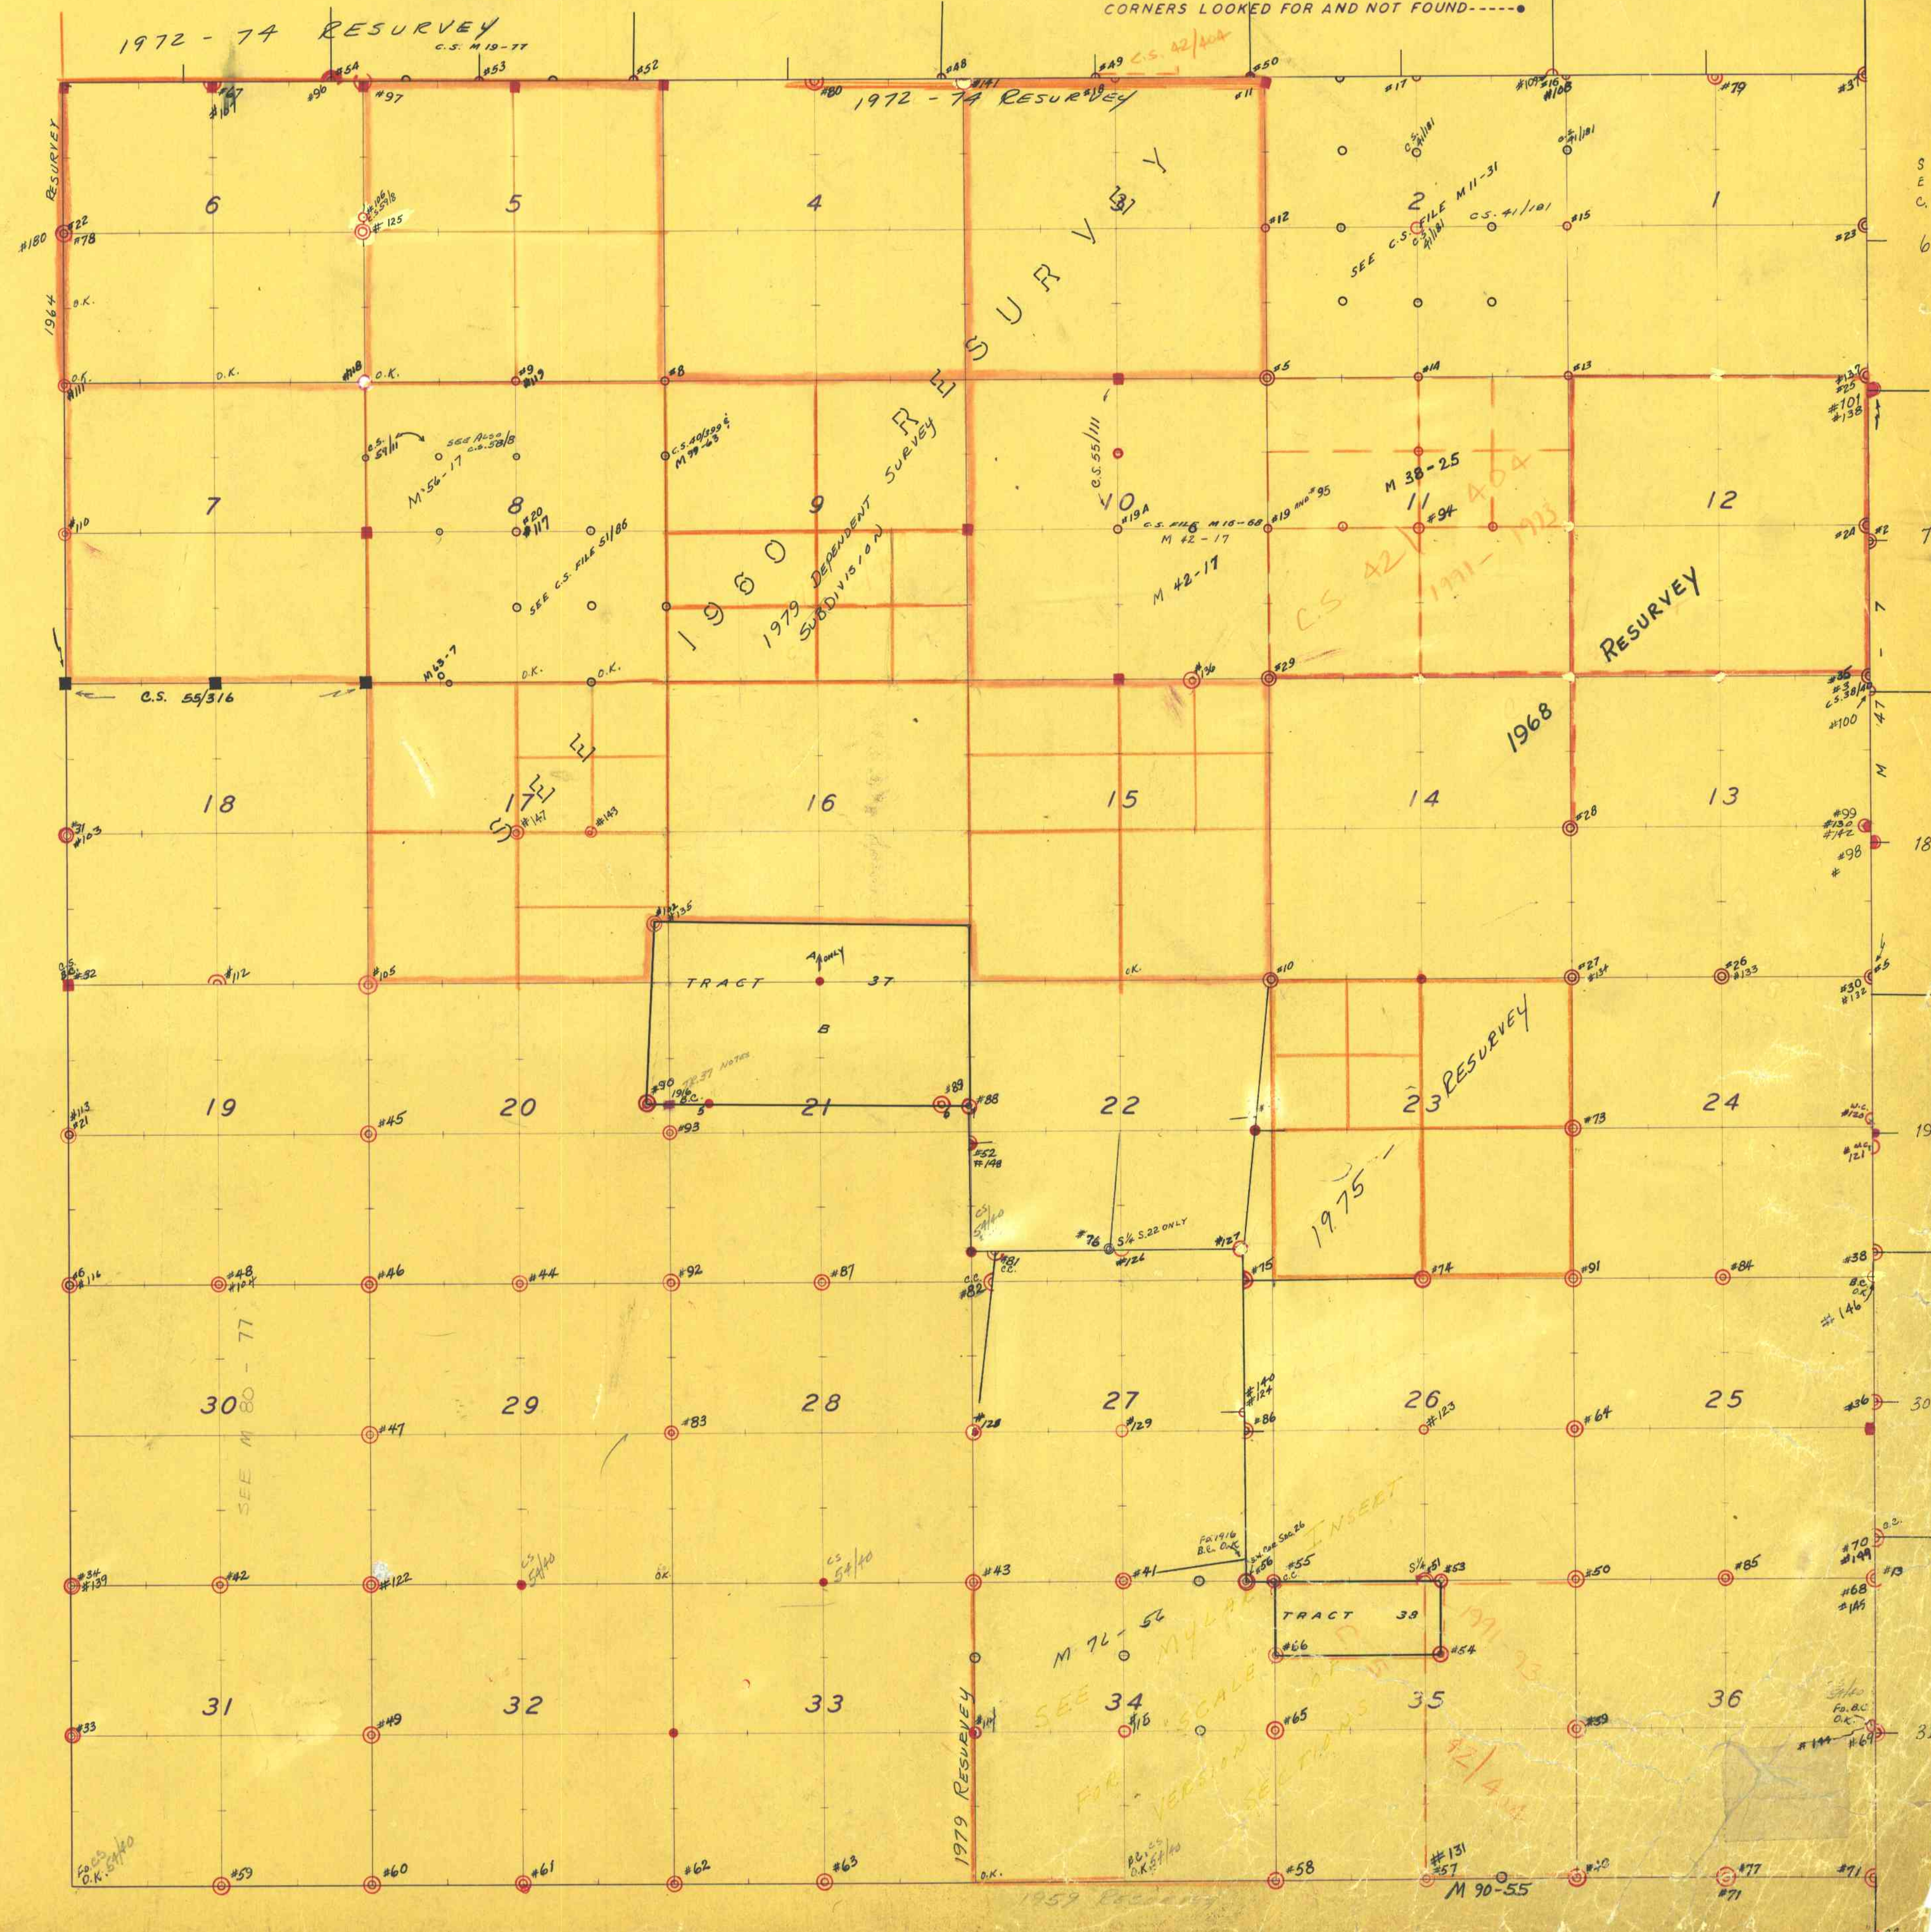

1972 - 74 RESURVEY
C.S. M 19-77

1972 - 74 RESURVEY

1964 RESURVEY

RESURVEY

RESURVEY

RESURVEY

1979 RESURVEY

6

5

4

1

7

8

9

12

18

16

15

14

13

19

20

21

22

24

30

29

28

27

26

25

31

32

33

34

35

36

TRACT 37

TRACT 38

TRACT 39

O.K.

O.K.

S.E.C. 6

7

18

19

30

31

32

SEE M 80 - 77

C.S. 51/111
M 56-17
SEE ALSO C.S. 50/118

SEE C.S. FILE 51/106

C.S. 40/190
M 79-23

C.S. 55/111
M 42-17

C.S. 42/104
M 38-25
M 42-17

C.S. 42/104
M 38-25
M 42-17

1975

SEE M 72-56
FOR VERSION OF SCALE
INSERT

1971-73

M 90-55

O.K.

O.K.

O.K.