

Douglas County Surveyor's Record of
Government Corners Renewed

26 T. S. 6 R. W. W. M.

COVE-CHAPMAN CO., EUGENE, ORE. 97198

63

Section Corner to Sections 15, 16, 21, & 22.

Found - Orig. 24", now 32" W. Oak N.13 $\frac{1}{2}$ °W. 34.3 ft. I open & find good scribing "S BT"

Orig. 16" B. Oak record S.42 $\frac{1}{2}$ °W. 42.2 ft. I find should be S.22 $\frac{1}{2}$ °W. 42.2 ft., which is the same bearing Cole recorded, 1921. I open this BT. & find good scribing "T26S S21 BT". *REN.#13*

No trace of Orig. S.E. or N.E. B.T.

Set Brass Cap at Corner Mkd:

S16	S15
S21	S22

 T26S R6W County Surveyor's Office, 1958.

Note. - Corner is under EW Wire Fence.

New BT's: 9" W. Oak bears N.52°W. 65.4 ft. scribed S16 T26S R6W CS BT.

15" R. Fir bears S.13°E. 69.2 ft. scribed S22 T26S R6W CS BT.

10" W. Oak bears S.38°W. 5.0 ft. scribed S21 T26S R6W CS BT.

18" B. Oak bears N.71°E. 71.0 ft. scribed S15 T26S R6W CS BT.

FAO.K. MEG 6/64

64

$\frac{1}{4}$ Section Corner to Sections 21 & 22.

Found - 1" Iron Pipe at Corner & rotted scribed Stake near. *REN.#15*
Cole's BT's., now partly rotted Stumps, Both show good scribe marks.

I do not set Brass Cap at Corner.

New BT's: 20" B. Oak bears N.9°W. 542.0 ft. scribed $\frac{1}{4}$ S21 CS *#22*

25" W. Oak bears East 459.8 ft. scribed $\frac{1}{4}$ S22 CS BT.

65

$\frac{1}{4}$ Section Corner to Sections 21 & 28.

Found - 1" Iron Pipe at Corner and both BT's. as recorded by Cole, 1921. *REN.#16*

The N.W. BT. down. I open now 30" W. Oak South 68.5 ft. & find good scribing.

New BT's: 20" W. Oak bears N.40 $\frac{1}{2}$ °W. 22.8 ft. scribed $\frac{1}{4}$ S21 CS BT.

8" Laurel bears S.11°E. 5.9 ft. scribed $\frac{1}{4}$ S28 CS BT.

66

Section Corner to Sections 14, 15, 22, & 23.

Found - All Original BT's:

Orig. 18", now 24" Oak. Stump shows good reverse scribe marks below cut, N.8°W, I find N.9 $\frac{1}{2}$ °W.

Orig. 48", now 60" B. O. I open & find good scribing "S" *#184*
N.27°W., I find N.25 $\frac{1}{2}$ °W. 205.9 ft.

Orig. 12", now 22" W. Oak, shows good scar. I do not open.
S.76 $\frac{1}{2}$ °E. 29.6 ft.

Orig. 18", now 32" B. Oak N.68°E. 46.2 ft. Shows good scars, I do not open.

Set Brass Cap at Corner Mkd:

S15	S14
S22	S 23

 T26S R6W County Surveyor's Office, 1959

New BT's: 20" W. Oak bears S.72°W. 24.3 ft. scribed S22 T26S R6W CS BT.

22" W. Oak bears S.76 $\frac{1}{2}$ °E. 39.1 ft. scribed S23 T26S R6W CS BT.

13" W. Oak bears N.61° E. 17.8 ft. scribed S14 T26S R6W CS BT.

13" B. Oak bears N.82°W. 45.2 ft. scribed S15 T26S R6W CS BT.

FAO.K. MAY 1964 MEG

67

Section Corner to Sections 9, 10, 15, & 16.

Found - Orig. 16", now 24" Oak Snag, center rotted, N.74 $\frac{1}{2}$ °W. 33.0 ft. I find good reverse scribe marks near base "T".

Find large Stump Hole that checks bearing & distance for Orig. S. E. BT.

No trace of Orig. S.W. or N.E. BT's. found.

Set Brass Cap at Corner Mkd:

S 9	S10
S16	S15


 T26S R6W County Surveyor's Office, 1959

New BT's: 10" R.Fir bears S.46 $\frac{1}{2}$ °E. 60.1 ft. scribed S15 T26S R6W CS BT.

14" R.Fir bears S.78° W. 30.0 ft. scribed S16 T26S R6W CS BT.

14" R.Fir bears N.46 $\frac{1}{2}$ °W. 20.6 ft. scribed S 9 T26S R6W CS BT.

24" Cedar bears N.57 $\frac{1}{2}$ °E. 51.3 ft. scribed S10 T26S R6W CS BT.

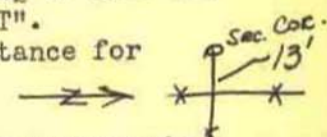

68

$\frac{1}{4}$ Section Corner to Sections 10 & 15.

Found - Both Orig. BT's., Orig. 16", now 30" W. Oak N.12 $\frac{1}{2}$ °E. 34.4 ft., I open & find good scribing " $\frac{1}{4}$ S".

Orig. 15", now 28" W. O. checks bearing & distance, S.75 $\frac{1}{2}$ °E. 153.1 ft. I do not open.

(continued over)

James W. Byron, Deputy
M. Godfrey
S. A. Bilow
October 28, 1958
C. S. File No. 49/121

James W. Byron, Deputy County Surveyor
Milo Godfrey
S. A. Bilow
February 11, 1959
C. S. File No. 49/121