

Douglas County Surveyor's Record of  
Government Corners Renewed

26 T. S. 7 R. W. W. M.

KOKE-CHAPMAN CO., EUGENE, ORE. 21891

45

M. B. Germond, Deputy  
Aug. 18, 1908  
Recorded in  
Vol. 2, Page 146.

**RE-RENEWED, SEE CORNER NO. 18**

Corner between Sections 34 & 35.  
I set a Sandstone 4" x 4" x 16" and notes that BT's.  
are as per. Gov't. field notes.

See 1935 renewal-Corner No. 18

46

Section Corner to Sections 26, 27, 34 & 35.  
Set for Section corner an Iron Pipe 1 1/2" diam, driven 2 ft. in  
the ground. I note most of the Gov't BT's. are still  
preserved. *Mar. 1966 - SEARCHED FOR, NOT FOUND - TRACY L.L.*

47

Ben B.  
Irving  
July,  
1926

Section Corner on the Twp. Line Secs. 13 & 12, T26-7W. & Secs. 7 & 18, T26-6W.  
Found - Rotten Stake at a fence corner & an Orig. BT. in good  
condition, which I did not chop out, now a 16" B.Oak  
N.78 1/2°E. 61 lks.  
Also a B. Oak, down & rotting but with scribe marks in  
the stump still legible S.79 1/2°W. 132 lks.  
Set - 4" Oak Post of proper length from which:  
16" B.Oak bears N.78°30'E. 39.4 ft. O.B.T.  
24" B.Oak bears N.23°18'W. 210 ft. mkd: S13 T26S R7W B.T.  
14" B.Oak bears S.80°30'E. 59 ft. mkd: S18 T26S R6W  
8" Fir bears S.40°50'W. 52.0 ft. mkd: S24 T26S R6W

48

James W. Byron, Deputy  
Milo Godfrey  
Clete Putnam  
December 16, 1960  
C. S. File No. 49/79

Sec. Corner to Secs. 34 & 35, T26-7W. & Secs. 3 & 2, T27-7W.  
Found - Orig. 24", now 40" B.Oak S.78°W. 4.6 ft., shows old  
scars, face rotted.  
Orig. 9", now 14" W.Oak N.88°E. 25.1 ft. We open & find  
good scribing, "S".  
Orig. 24", now Stump Hole that checks bearing & distance  
for S. E. BT.  
Orig. 24" B. Oak, now base of Oak Stump, checks bearing &  
distance for Orig. N. E. BT.  
Set Brass Cap at Corner Mkd: County Surveyor's Office, 1960  
S34 | S35 T26S R7W  
S 3 | S 2 T27S R7W  
New BT's: 17" R.Fir bears S.26°W. 8.0 ft. scribed S 3 T27S R7W CS BT.  
7" W.Oak bears S.81°E. 54.8 ft. scribed S 2 T27S R7W CS BT.  
7" W.Oak bears N.75°E. 46.7 ft. scribed S35 T26S. R7W CSBT.  
10" Dbbl. R.Fir N.50 1/2°W. 20.0ft. scribed S34 T26S R7W CS BT.

49


James W. Byron  
Milo Godfrey  
Clete Putnam  
Dec. 19, 1960  
C.S.File No. 49/79

Sec. Cor. to Secs. 33 & 34, T26-7W & Secs. 4 & 3, T27-7W.  
Found - W. Oak, now 18", dead but standing, N.47°W. 52.8 ft. #58  
Upper scar had been previously opened and face entirely  
rotted away. Chopped open lower scar & fd. good scribe "BT".  
No trace of any other BT's.  
Corner is in badly burned area.  
Set Brass Cap at Corner Mkd: County Surveyor's Office, 1960  
S33 | S34 T26S R7W  
S 4 | S 3 T27S R7W  
New BT's: 9" W.Oak N.37 1/2°E. 129.5 ft. Mkd: "T26S R7W S34 CS BT".  
No other live trees available in vicinity of corner.  
A fence corner(fences East & North bears S.64 1/2°W. 18 feet)

50

Dec. 19, 1960  
C. S. File No. 49-79

1/2 Section Corner to Sec. 33, T26-7W & Sec. 4, T27-7W.  
Found - Orig. 20", now 34" Laurel Snag S.87°W. 44.9 ft. We open  
& find good scribing "T".  
No trace of Orig. NE BT. found.  
Corner Thus:

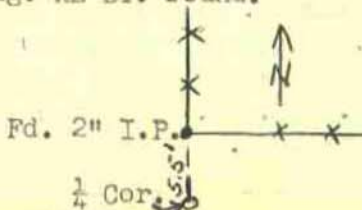

Set Brass Cap at Corner Mkd: County Surveyor's Office, 1960  
1/4 S33 T26-7W  
S 4 T27-7W

No trees near suitable for BT's.