

Douglas County Surveyor's Record of
Government Corners Renewed

26 T. S. 7 R. W. W. M.

KOKE-CHAPMAN CO., EUGENE, ORE. 21891

Wit. Corner to Sections 35 and 36, T26S R7W; Sections 2 & 1, T27S R7W. 88
See Ren. #74

Found: 1" I. Pipe, N. 1° W., 13.8 ft.
1" I. Pipe, S. 2° W., 18.6 ft.
9" Cedar, S. 65° W., 48.2 ft. scribing visible.
8" Cedar, N. 42° W., 56.0 ft. scribing visible.
Also: Brass Cap at wit. cor. mkd: County Surveyor's Office, 1966 T 26 S R 7 W Wit. Cor. 23 ft. W. to

RE-RENEWED, SEE CORNER NO. #92

35|36
211
T27S

Note: As this cap & BT's & objects will fall in new road, I remove Brass Cap & reset at 45 ft. east of sec. cor. Also remark cap as follows: (Wit. Cor. 45 ft. W. to)
Bearing Objects: NW cor. of house, S. 72° E., 104.0 ft.
SW cor. of house, S. 52° E., 126.2 ft.
Note: After road work is complete, there should be I. rods set in R/W fence lines for bearing objects.

Wit. $\frac{1}{4}$ Corner to Sections 34 and 35. See Ren. #71. 89

Found: 13" W. Oak, now 14", N. 1° E., 134.8 ft. Scribe visible.
9" W. Oak, now 11", S. 28° E., 39.0 ft. Scribe visible.
Also: Brass Cap set for wit. cor. mkd. and I. Pipe along side.
County Surveyor's Office, 1966 T 26 S R 7 W

S 34 | S 35
Wit. Cor. 20 ft. W. to

Note: As this cor. will now fall in new road R/W, I remove said cap and move it 30 ft. east. I also remark cap to read (Wit. Cor. 50 ft. W. to)
New BT's: 16" D. Fir, S. 9° E., 57.0 ft. Scribed W.C. $\frac{1}{4}$ S35 CS BT.
10" W. Oak, S. 58° E., 72.5 ft. Scribed W.C. $\frac{1}{4}$ S35 CS BT.
7/73 - FOUND O.K. V.R.T. C.S. 56/34

Wit. $\frac{1}{4}$ Cor. to Sections 35 and 36. 90

Found: $\frac{3}{4}$ " I. Rod 6" underground at $\frac{1}{4}$ Cor. - Ren. No. 35
15" W. Oak, N. 56° E., 84.8 ft. Now stump.
16" W. Oak, N. 48° W. (Rec. N. 52° E., 43.2 ft.) Shows good scar.
Note: As this cor. will fall in new road work, I set wit. cor. mkd. as follows: County Surveyor's Office, 1971 T 26 S R 7 W

S35 | S36
W.C. 60 ft. S. to

New BT's: 16" W. Oak, East 5.0 ft. scribed WC $\frac{1}{4}$ S36 CS BT.
 $\frac{5}{8}$ " I. Rod, S. 48° W., 46.0 ft. This rod in old R/W Fence line.
7/73 FOUND O.K. V.R.T. C.S. 56/34


$\frac{1}{4}$ Corner Section 5 and Section 32, T25-7 91

Found - 30" D. Fir, now 35", S. 33° E., 8.0 ft. Shows good scar.
16" Laurel, now 18", N. 18 $\frac{1}{2}$ ° W., 12.9 ft. Bark Scribe visible.
2807 - S32 T25S R7W BT. Ren. No. 32
Set - Drove $\frac{5}{8}$ " I. Rod at $\frac{1}{4}$ Corner
New BT - 9" D. Fir, S. 27° W., 6.5 ft. scribed $\frac{1}{2}$ S5 CS BT.

2/14/73

Wit. Corner to Sec. Cor. T26S R7W S 35 | S 36
T27S S 2 | S 1 92

Found - Doug. Co. Brass Cap, dated 1966, in place, as recorded in Ren. #88.
Both Iron Pipes & Cedar BT's, now gone. Ties to corners of house fit O.K.
We tie Witness Corner to Co. Rd. R/W Pins, as follows:
5/8" Iron Rod at Sta. 246+00 bears N. 33° W. 25.0 ft.
5/8" Iron Rod at Sta. 246+75 bears S. 14° W. 55.8 ft.
Note: Brass Cap lies 45.0 ft. East of True Corner, See Diagram:

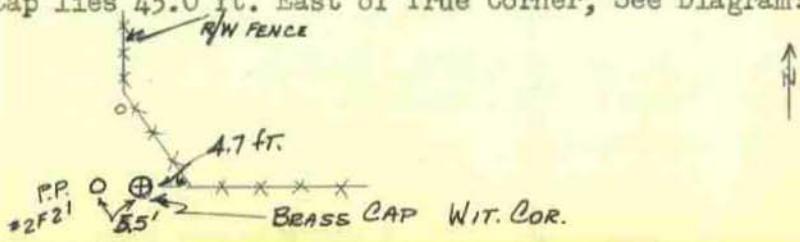

John M. Powell
W. Penley
July 12, 1971
C. S. File 54/23

John M. Powell
J. Heritage
G. Commons
C.S. 56/25
Feb. 1973

Vernon "Ray" Tracy
Jack Heritage
C.S. File No. 56/34

7/11/73