


T. 26 S., R. 9 W.

CORNERS RENEWED BY
 BUREAU OF LAND MANAGEMENT -----◆
 COUNTY SURVEYOR'S OFFICE -----⊙
 PRIVATE SURVEYORS -----○
 CORNERS FOUND AND USED -----■
 CORNERS LOOKED FOR AND NOT FOUND -----●

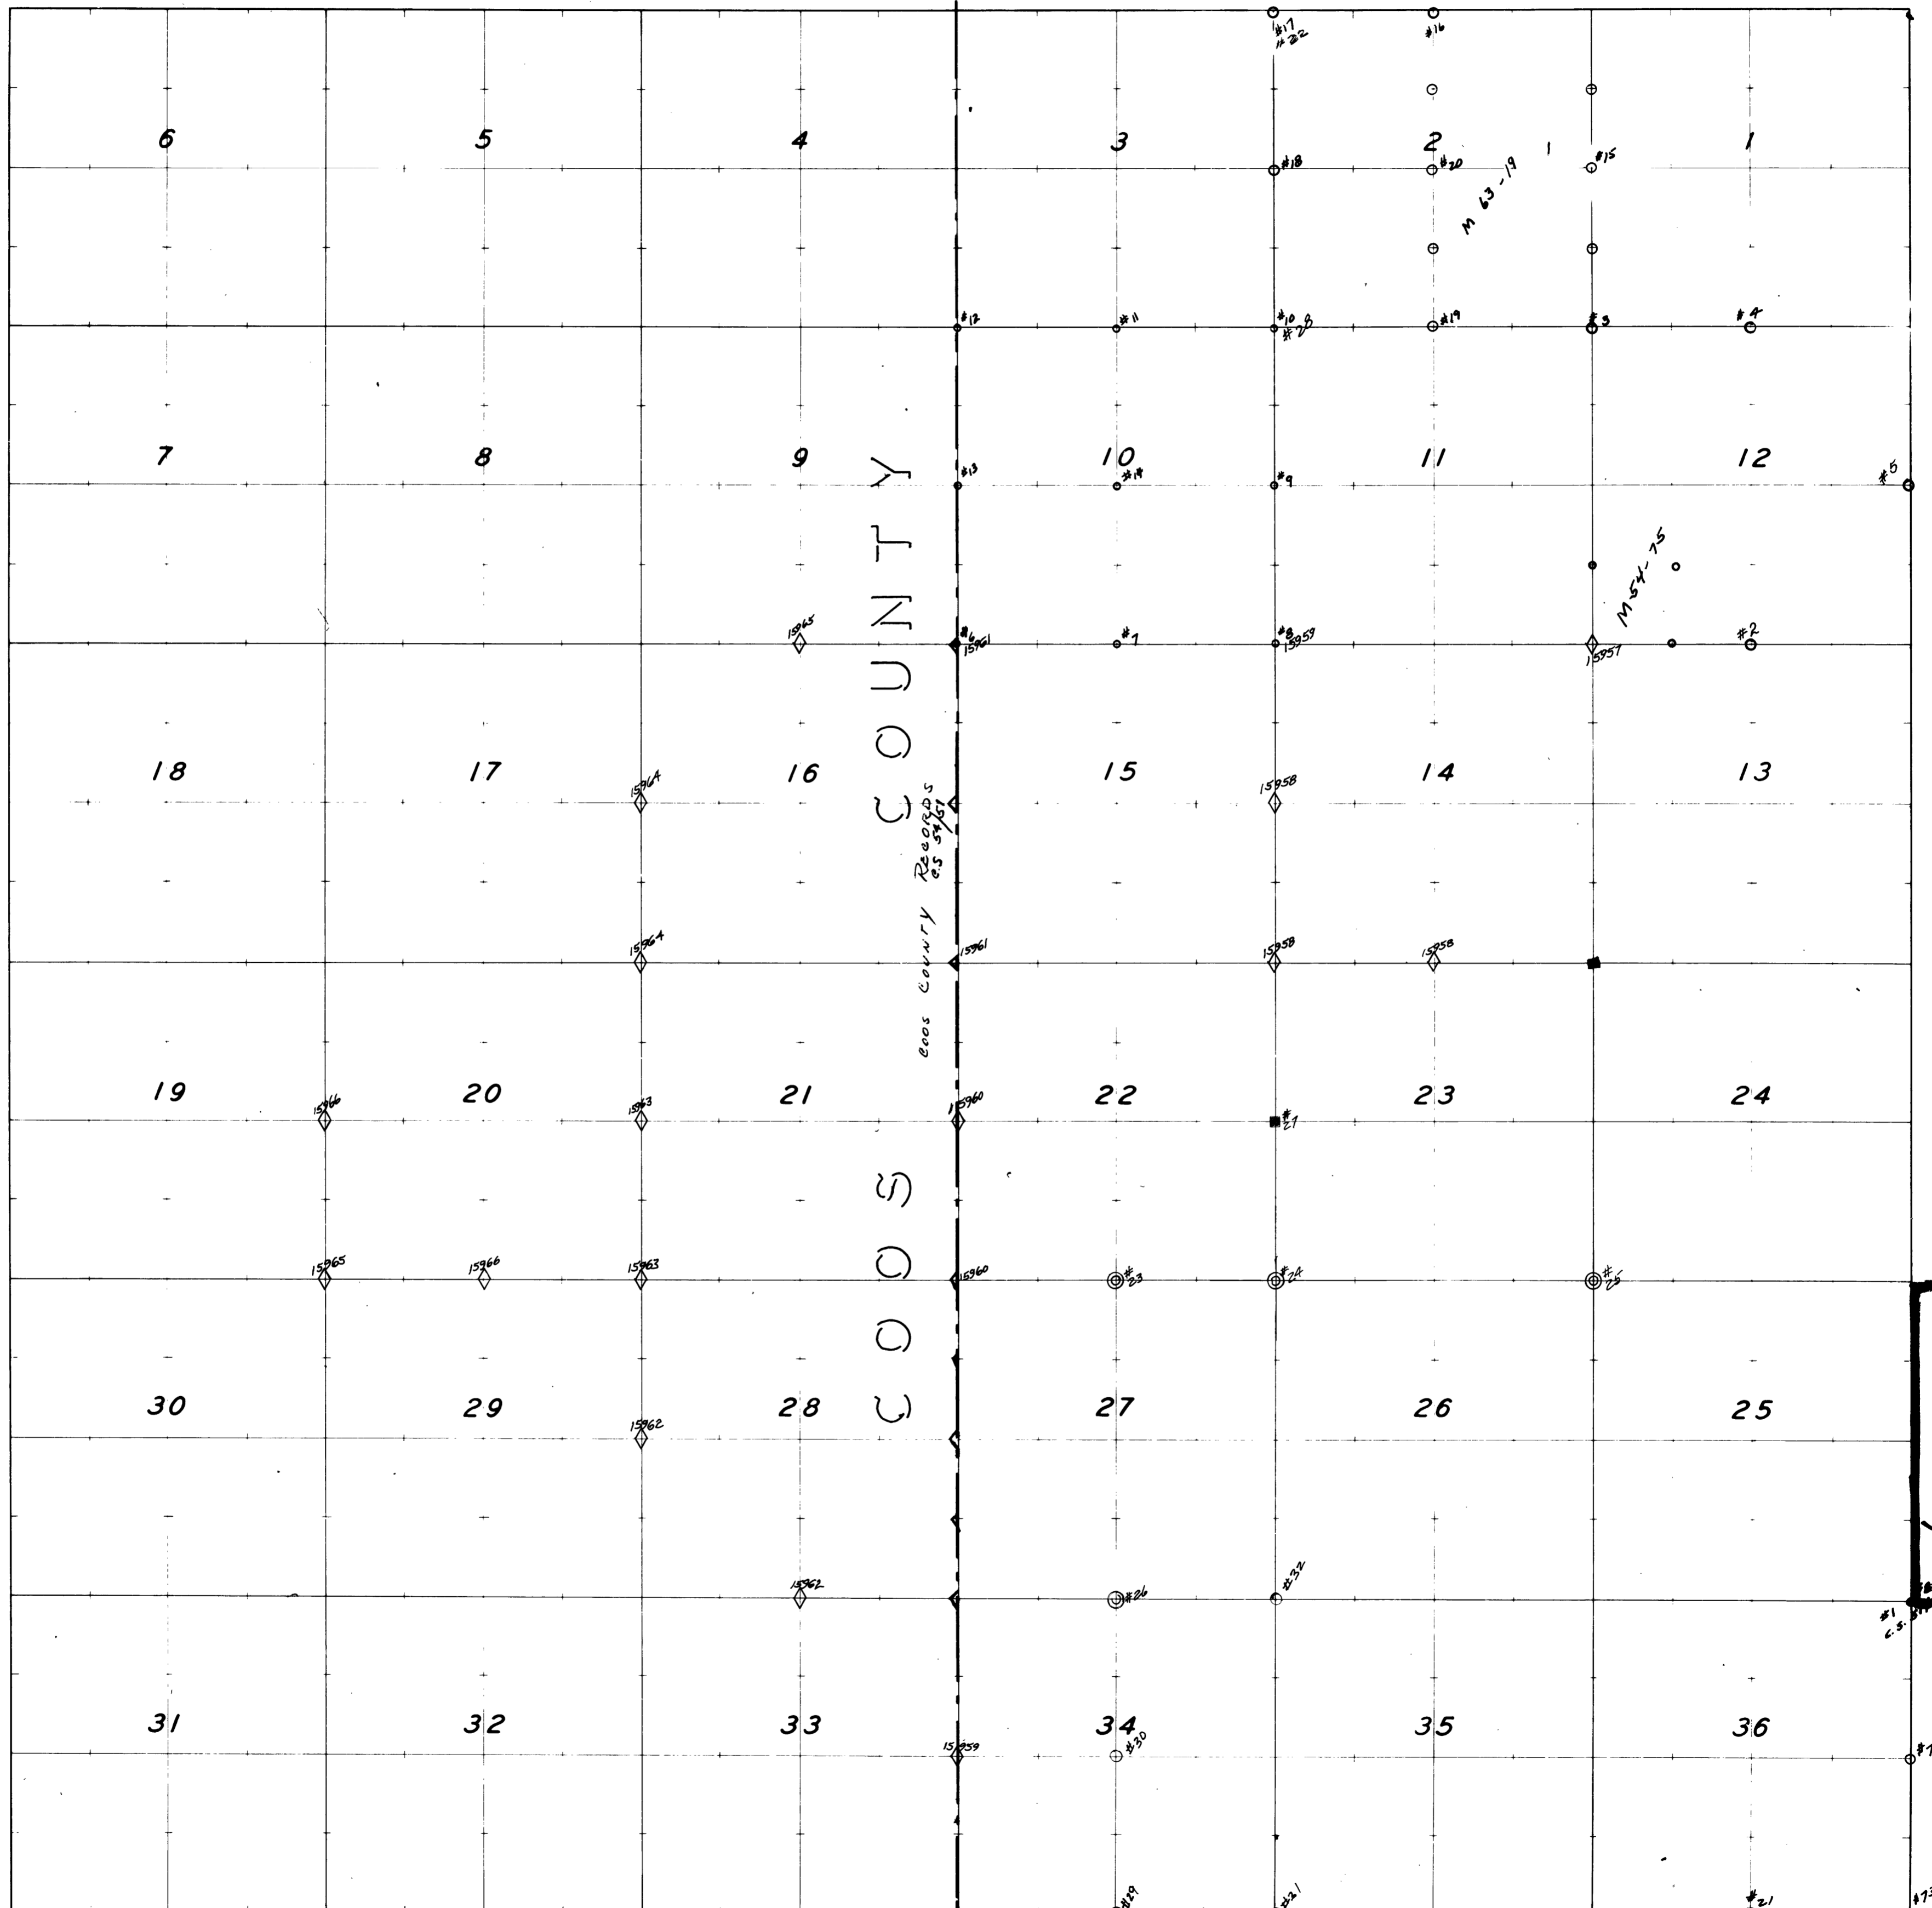

1967 RESURVEY