


T. 26 S., R. 9 W.

CORNERS RENEWED BY
 BUREAU OF LAND MANAGEMENT -----◆
 COUNTY SURVEYOR'S OFFICE -----○
 PRIVATE SURVEYORS -----○
 CORNERS FOUND AND USED -----■
 CORNERS LOOKED FOR AND NOT FOUND -----●

THE BOUNDARIES ARE TYPED IN THE "NEW" SYSTEM &
 THE PAGES ARE IN THE BLACK BINDERS
 THE INTERIOR CORNER RENEWALS ARE STILL IN THE
 "OLD" SYSTEM

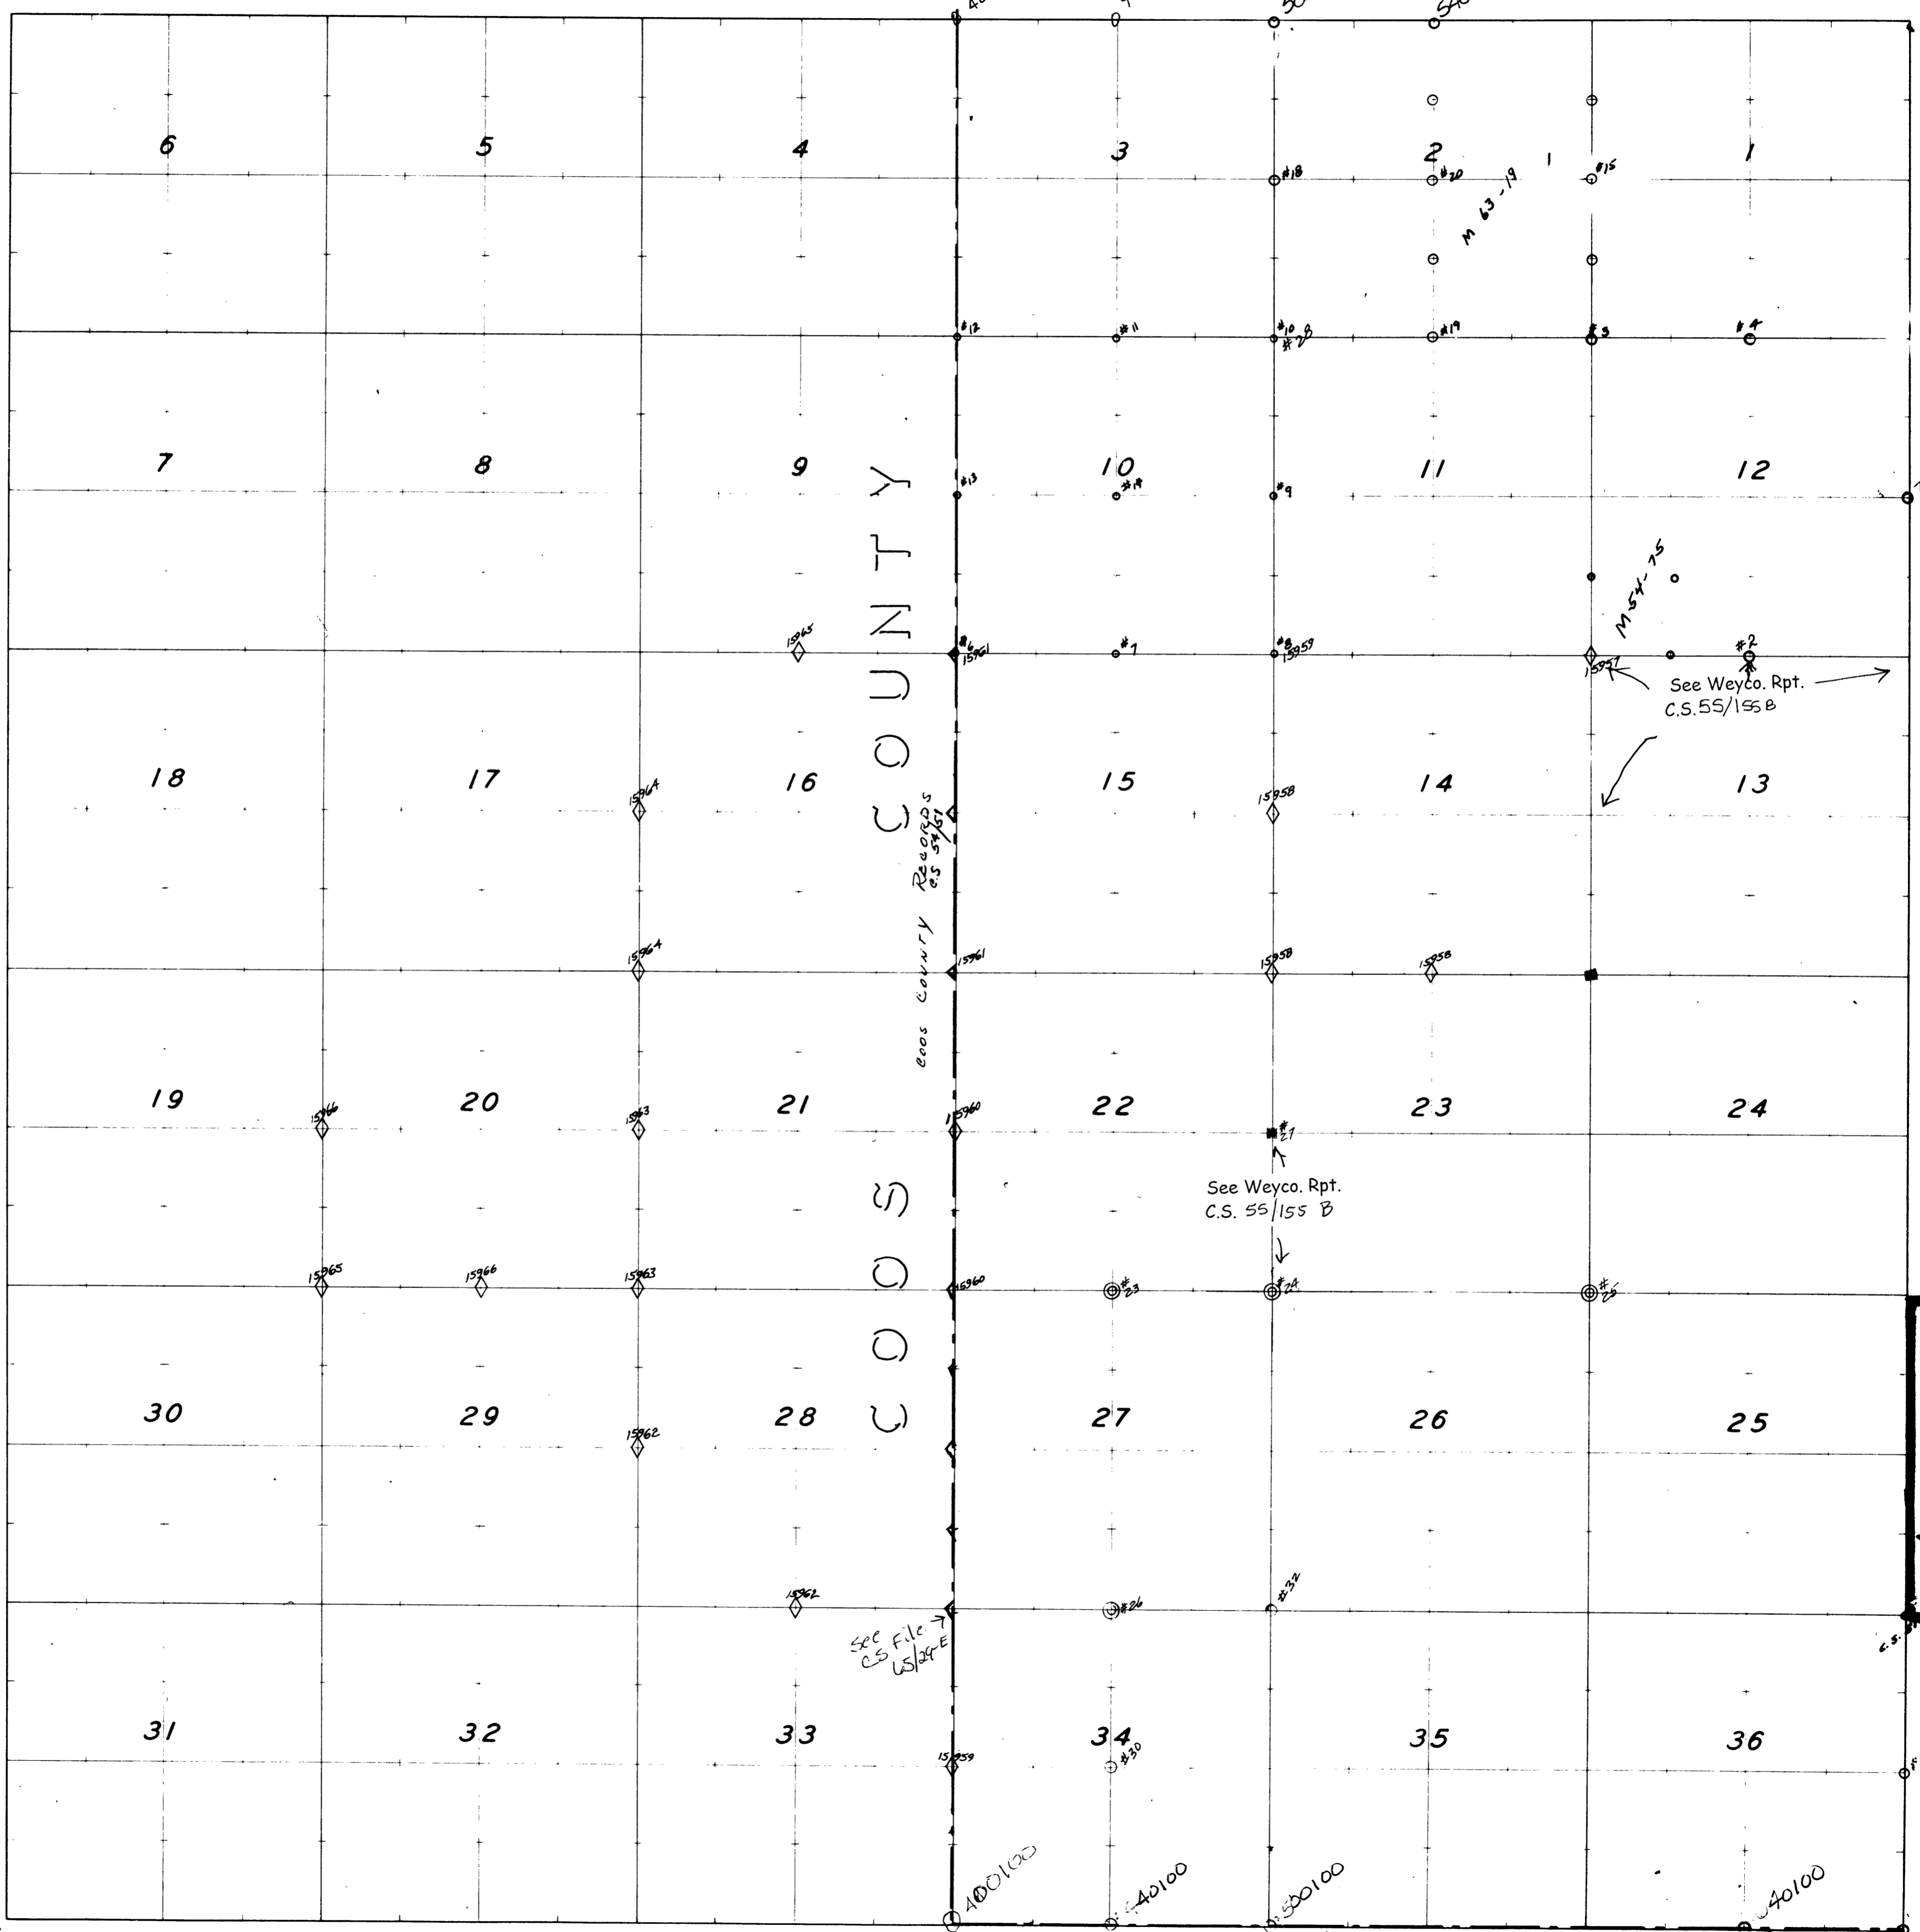

1967 RESURVEY

see file -> CS 15124-E

See Weyco. Rpt. C.S. 55/155 B

See Weyco. Rpt. C.S. 55/155 B

COUNTY

2005 COUNTY RECORDS 05 5467

M 63-19

M 54-75

400700

440700

500700

540700

700540

400100

440100

500100

40100

6

5

4

3

2

1

7

8

9

10

11

12

18

17

16

15

14

13

19

20

21

22

23

24

30

29

28

27

26

25

31

32

33

34

35

36