

Douglas County Surveyor's Record of  
Government Corners Renewed

T. 27 S. T. S. R. 1 W. R. W. W. M.

KOKE-CHAPMAN CO., EUGENE, ORE. 21881


$\frac{1}{4}$  Corner to Sections 23 and 24, T. 27 S. R. 1 W. 114

Found - 8" Hemlock stump (Rec. Fir) N.36°W. 33.7 ft., open for scribing " $\frac{1}{4}$ "  
Ring count places face about 1902

10" Cedar, now stump, N.14°E. (Rec. N.25°E.) 73 ft., found no face  
probably logged.

Set - Brass Cap at Cor. Mkd: County Surveyor's T 27 S R 1 W  
Office, 1969  $\frac{1}{4}$  S 23 | S 24

This cor. lies in clear cut unit. I set  $\frac{3}{4}$ " Iron Rods in Fire Trail running  
North as follows:

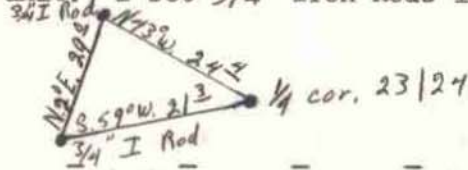

12/22/69

$\frac{1}{4}$  Corner to Sections 15 and 22, T. 27 S. R. 1 W. 115

Found - 30" D. Fir, now burnt stub 50' high, N.20°W. 15.2 ft., opened for  
scribing " $\frac{1}{4}$  S15 BT".

14" D. Fir, now burnt stump rotted, S.5°W. 24.4 ft.

Also 15x10x5 stone at  $\frac{1}{4}$  cor. mkd. " $\frac{1}{4}$ " on North face.

Set - Brass Cap at Cor. Mkd: County Surveyor's T 27 S R 1 W  
Office 1969  $\frac{1}{4}$  S 15  
S 22

New BT's: 5" D. Fir N.39°W. 24.5 ft., scribed " $\frac{1}{4}$  S15 CS BT".

8" D. Fir S.30 $\frac{1}{2}$ °E. 45.2 ft., scribed " $\frac{1}{4}$  S22 CS BT".

Note: This cor. lies in very brushy clear cut unit.

12/24/69

$\frac{1}{4}$  Corner to Sections 27 and 34, T. 27 S. R. 1 W. 116

Found - Stone at  $\frac{1}{4}$  cor. Found to be about size but no marks, but we found  
2 BT's.

12" Cedar, now 16", S.43°W. 15.2 ft., shows scribing on open face of  
" $\frac{1}{4}$  S B".

8" Hemlock (Rec. said to be Fir) now 16", N.71°W. 25.7 ft., shows  
good axe face.

Set - Brass Cap at Cor. Mkd: County Surveyor's T 27 S R 1 W  
Office 1969  $\frac{1}{4}$  S 27  
S 34

Rescribed - 16" Hemlock N.71°W. 25.7 ft., scribed " $\frac{1}{4}$  S27 CS BT".

New BT: 10" D. Fir S.6°W. 17.0 ft., scribed " $\frac{1}{4}$  S34 CS BT".

Note: This  $\frac{1}{4}$  cor. lies about 250 ft. South of small creek.

12/29/69

Section Corner to Sections 27, 28, 33, and 34, T. 27 S. R. 1 W. 117

Found - 18" D. Fir, now 36", S.50°E. 11.2 ft., shows good scar.

20" Hemlock, now 34", S.75°W. 15.8 ft., scribe visible T27S RLW  
S33 BT, face rotten.

Also 18x10x8 stone firmly set at sec. cor. mkd. 1 North South 3 East.

Set - Brass Cap at Cor. Mkd: County Surveyor's T 27 S R 1 W  
Office 1969 S 28 | S 27  
S 33 | S 34

New BT: 10" Hemlock N.47°W. 15.8 ft., scribed "T27S RLW S2B CS BT".

12/31/69

Section Corner to Sections 21, 22, 27, and 28, T. 27 S. R. 1 W. 118

Found - Corner stone 15x10x8 with 2 marks on the South and 3 on the East;  
plus two BT's.

14" D. Fir, now 28", found to be N.67°E. (Rec. N.63°E.) 43.6 ft., shows  
good axe face.

10" D. Fir, now 18" stub, found to be S48°E. (Rec. S.52°E.) 64.0 ft.,  
opened and found scribing "1 W 27".

Set - Brass Cap at Cor. Mkd: County Surveyor's T 27 S R 1 W  
Office 1970 S 21 | S 22  
S 28 | S 27

New BT: 20" D. Fir S.52°E. 69.6 ft., scribed "T27S RLW S27 CS BT".

Note: This cor. lies 20' East of 100 ft. cliff on top a rocky ridge.

1/5/70

John M. Powell  
Frank Jones & W. Penley  
C. S. File No. 54/94