

Douglas County Surveyor's Record of
Government Corners Renewed

T. 27 S. T. S. R. 1 W. R. W. W. M.

KOKE-CHAPMAN CO., EUGENE, ORE. 31881

Vernon "Ray" Tracy
J. G. Heritage & V. Perron
6-20-69 C. S. File No.
54/40

$\frac{1}{4}$ Corner Section 18 Only

Found - Unrecorded U. S. Plywood Alum. Cap Mkd. $\frac{1}{4}$ S 18 Only 1962 & O.B.T.
as follows:

Orig. 7" now 9" Hemlock S. 18°E 11.2 Ft. lying face down - we
roll over & fd. $\frac{1}{4}$ S 18 BT Scribe under 40 years of over growth
(Old field notes call for Fir) No trace other O.B.T. Cor. stone
called for is broken & small piece is Mkd. $\frac{1}{4}$ " We mark new B.T.S.
54" D. Fir stump, 69°E 29.5 Ft. Mkd. $\frac{1}{4}$ S 18 CS BT
50" D. Fir stump S. 22°E 37.0 Ft. Mkd. $\frac{1}{4}$ S 18 CS BT. This Cor,
lies on N. slope in old clear cut area. 6-20-69

RECORDED SEE CORNER NO. #190

R2W RIW

22

West $\frac{1}{4}$ Corner to Section 19, T27-1E.

Found - 1927 GLO Brass Cap at corner, properly marked

14", now 18" D. Fir, S. 39°E. 52.8 ft., scribe visible.

No trace of Orig. N.E. BT., falls in road.

38" D. Fir N. 14°E. (80.2 face) 82.0 ft., bark scribed, Ren. #1, T27-1E.

Reblzd. & Rescbd: 38" D. Fir N. 14°E. 82.0 ft., " $\frac{1}{4}$ S19 CS BT".

This corner lies 20 ft. S. of logging road..

Orig. Dist. btwn corners 19-24, 88.4 ft. (1.34 ch.). I find this 46.0 ft.

23

Section Corner to Sections 13 and 24, T27-1W.

Found - Orig. 30", now 36" D. Fir, N. 74°W. 16.5 ft., opened for scribe.

Orig. 34", now 39" D. Fir S. 37°W. 39.6 ft., shows good scar.

No trace 1927 GLO Brass Cap as cor. lies on very steep, N.W. slope,
very rocky, probably slid out.

Set - Brass Cap at Cor. Mkd: County Surveyor's R T 27 S R
Office 1 S 13 S 19 1
1969 W S 24 E

Bearing Trees O. K. and Tagged.

10/27/69

Witness Corner to Sections 18 and 19, T27-1E.

Found - No Trace of Brass Cap or N.E. BT., as they fall in high cut
bank of road.

48" D. Fir, now stump, S. 69°E. 23.8 ft., scribe marks visible.

Set - Brass Cap at Cor. Mkd: County Surveyor's R T 27 S R
Office 1 S 13 S 18 1
1969 W S 19 E

New BT's: 13" Hemlock N. 64°E. 29.9 ft. mkd: W.C. T27S RIW S19 CC CS BT.

12" Maple S. 51 $\frac{1}{2}$ °E. 18.0 ft. mkd: W.C. T27S RIW S19 CC CS BT.

This corner lies about 80 ft. south of logging road.

10/22/69

Township Corner thus:

RIW S36 | S 31 T 26S
S 6 R1E T 27S
1927

26

Found - 1927 GLO Brass Cap on ground 13 ft. E. of corner.

Reset Brass Cap at Twp. Corner mkd. as shown above.

Found - 17" D. Fir, now stump, N. 16°E. (Rec. N19E) 104.3 ft., scribe visible.

40" D. Fir, now stump, S. 59°E. 54.1 ft., opened for scribe.

New BT's: 6" D. Fir S. 64°E. 58.1 ft. mkd. S6 CC CS BT.

4" D. Fir S. 18°E. 7.0 ft. mkd: S6 CC CS BT.

4" D. Fir N. 36°W. 7.0 ft. mkd: S36 CS BT.

This corner lies in clear cut unit about 90 ft. W. of ridge, running N-S.

10/29/69

Township Corner as shown:

Set - Brass Cap Mkd: County Surveyor's R T 26 S R
Office 1 S 36 S 6 1
1969 W S 1 E
T 27 S

27


Found - 24" D. Fir, now stump, N. 61°W. 31.7 ft., tree open, scribe visible.

20" D. Fir, now stump, S. 55 $\frac{1}{2}$ °W. 36.3 ft., burnt face.

No trace of 1927 GLO Brass Cap.

New Bering Objects: 3/4" I. Rod N. 47°W. 28.1 ft.

3/4" I. Rod S. 80°W. 23.1 ft.

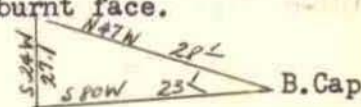

John M. Powell
Frank Jones & W. Penley
October, 1969 C. S. File No. 54/94