


# T. 27 S., R. 1 W.

CORNERS RENEWED BY  
 BUREAU OF LAND MANAGEMENT  
 COUNTY SURVEYOR'S OFFICE  
 PRIVATE SURVEYORS  
 CORNERS FOUND AND USED  
 CORNERS LOOKED FOR AND NOT FOUND

THE BOUNDARIES ARE TYPED IN THE "NEW" SYSTEM & THE PAGES ARE IN THE BLACK BINDERS  
 THE INTERIOR CORNER RENEWALS ARE STILL IN THE "OLD" SYSTEM

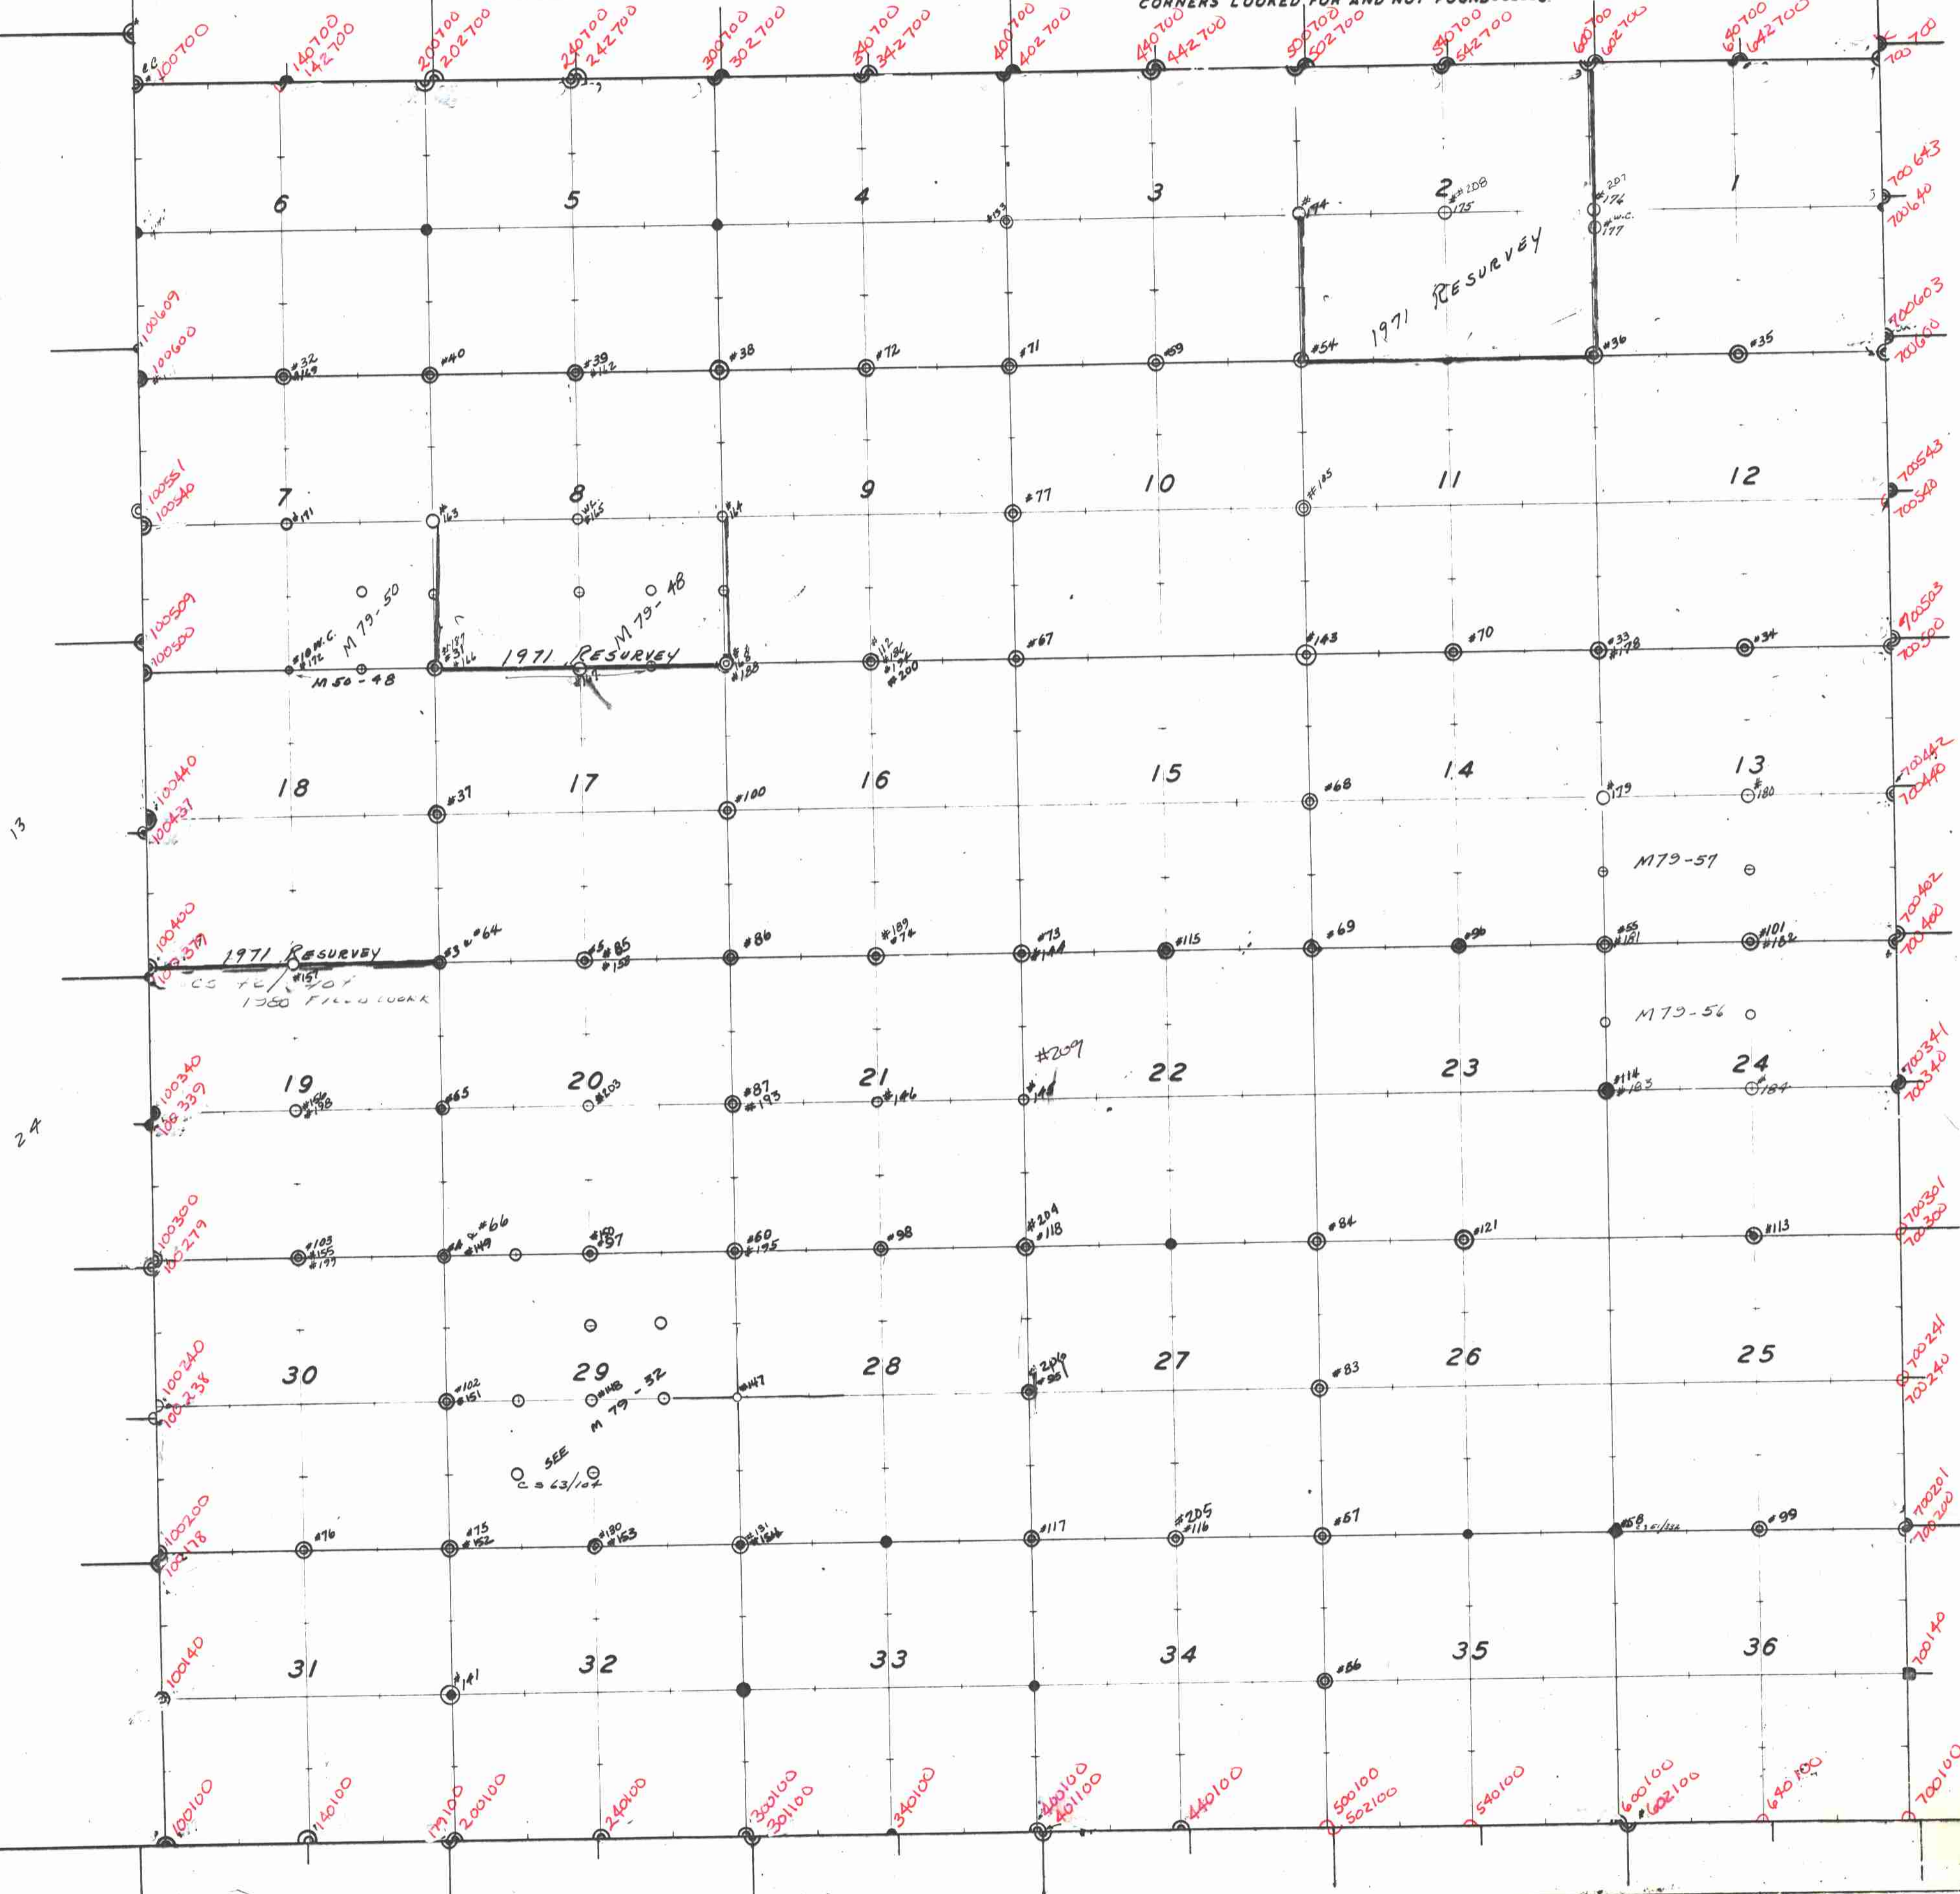

13

24

106

SEE  
C = 63/104

1971 RESURVEY  
CS 72/101  
1750 FIELD BOOK

1971 RESURVEY

1971 RESURVEY

M 79-52

M 79-51

M 79-56

M 79-50  
M 50-48

100140

100200  
100178

100240  
100238

100300  
100279

100340  
100339

100400  
100379

100500  
100500

100550  
100540

100600  
100600

100609  
100600

100700  
100700

100700

31

30

19

18

7

6

32

29

20

17

8

5

33

28

21

16

9

4

34

27

22

15

10

3

35

26

23

14

11

2

36

25

24

13

12

1

700140

700201  
700200

700241  
700240

700301  
700300

700341  
700340

700402  
700400

700442  
700440

700503  
700500

700543  
700540

700603  
700600

700643  
700640

700700

500100  
502100

540100

600100  
602100

640100

700100

170100  
200100

240100

300100  
301100

340100

400100  
401100

440100