

Douglas County Surveyor's Record of
Government Corners Renewed

T. 27 S. T. S. R 2 W. R.W.W.M.

KOKE-CHAPMAN CO., EUGENE, ORE. 21861

91

1/4 Corner to Sections 29 and 30.

Found - Orig. 24", now 26" Hemlock, down, N.10°E. 7.9 ft., find scribe on chopped out blaze. This BT. fd. by Forrest Appraisal, 1952. Find Hole N.33°E. 15.2 ft. & possible BT. downhill & burned, no scribing found.

Set - Brass Cap at Cor. Mkd: County Surveyor's Office, 1968 T 27 S R 2 W S 30 S 29 #230

New BT's: 5" Yew S.37°E. 7.2 ft. mkd: 1/4 S29 CS BT.
5" Yew N.47°W. 51.3 ft. mkd: 1/4 S30 CS BT (Dying)
7" W. Fir S.51°W. 38.8 ft. mkd: 1/4 S30 CS BT. (20' high broken top)
This corner lies in large clear cut about 330 ft. S. of creek, course N.E., now N.W. as in field notes.

92

1/4 Corner to Sections 25 and 36.

Found - Orig. 10", now 12" Hemlock, alive, S.62 1/2°W. 8.6 ft., open & find scribe marks.

Orig. 48" Fir, now 50" Stump, N.21°W. 36.3 ft., shows scar.

Set - Brass Cap at Cor. Mkd: County Surveyor's Office, 1968 T 27 S R 2 W 1/4 S 25 S 36

New BT's: 10" Yew N. 28° W. 25.3 ft. mkd: 1/4 S25 CS BT.
11" Hemlock S. 53° W. 39.1 ft. mkd: 1/4 S36 CS BT.
This corner lies in shallow ravine, course west. - Cut off in Section 25.

93

Closing Corner to Sections 34 and 35, T27-2W.

Found - Unrecorded U.S. Ply. Alum. Cap mkd: Set from Orig. BT's., now only sawed stumps remain.

16" Hemlock Stump N.45°W. 22.5 ft. mkd: S34 BT & Tag mkd: 4287.

48" Cedar Stump S.62°E. 25.6 ft. mkd: S2 BT. & Tag mkd: 4287.


Set - 6 ft. steel fence post alongside alum. Cap.

New BT: 9" Cedar N.41°E. 58.1 ft. mkd: T27S R2W S35 CC CS BT.

This corner lies 120 ft. E. of A.P. of Sec. 34 in clear cut unit. Record distance betwn. corners 112.2 ft.

94

Found Corners:

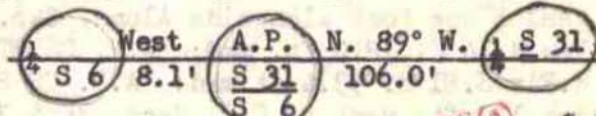

From the 1/4 Cor. Sec. 6, BT's. as follows:

Orig. 11" Cedar S.30°E. 11.7 ft., old scribe on chopped out blaze.

New BT: 20" Cedar S.70°W. 34.8 ft. mkd: 1/4 S6 BT, Alum. Tag # 4287.

From the A. P. Sec. 31 and Sec. 6, new BT's., as follows:

11" D. Fir S.65°E. 19.0 ft. mkd: AP S6 BT., Alum. Tag #4287.

11" D. Fir N. 4°W. 33.3 ft. mkd: AP S31 BT, Alum. Tag #4287

We find no original bearing trees.

From the 1/4 Section 31 Corner, BT's. as follows:

38" Cedar Stump N.65°W. 50.2 ft. mkd: 1/4 S31 BT, Alum. Tag #4287.

The above corners are all unrecorded to date, 10/28/68.

95

1/4 Corner to Sections 35 and 36.

Found - Orig. 12", now 17" Yew, alive, N.85°W. 11.9 ft., scribe visible on nearly healed blaze, good condition.

Orig. 20"?, now 20" Fir, N.27°E. 45.5 ft., now down, sawed stump, scar visible on underside of decayed log.

Set - Brass Cap at Cor. Mkd: County Surveyor's Office, 1968 T 27 S R 2 W 1/4 S 35 S 36 #204

New BT: 10" Hemlock S.63 1/2°E. 13.3 ft. mkd: "1/4 S36 CS BT".

Cor. lies 75' S. of SW Cor. of clear cut unit in section 36.

96

1/4 Corner to Sections 14 and 15.

Found - U.S. Ply. Alum. Cap & BT's. as recorded in Ren. #32.

Orig. 10", now 16" Yew, dead, N.20°E. 38.3 ft., scribe visible on open blaze.

7" Yew, dead, nearly tipped out, N.48 1/2°W. 40.7 ft.

Set - 5/8" I.R. 5.0 ft. south and 5/8" I.R. 15.0 ft. S. of corner.

6 ft. steel fence post alongside alum. cap.

This corner lies in clear cut area. No trees or suitable stumps close for new bearing trees.

11/8/68

Vernon "Ray" Tracy
J. Heritage & V. Perron
October and November, 1968
C. S. File No. 54/40