

Douglas County Surveyor's Record of  
Government Corners Renewed

T. 27 S. T. S. R. 3 W. R. W. W. M.

KOKE-CHAPMAN CO., EUGENE, ORE. 21001

Fd OK  
10/31/89  
DC 50  
CS. 64/13

Section Corner to Secs. 7 & 18, T27-3W. & Secs. 12 & 13, T27-4W. 93  
Found - Iron Pipe with Brass Cap set in 1917, in mound of large rocks.

C. S. File  
No. 53/33

- 44" Fir N.17°E. 11.2 ft., shows very plain axe scar. Tree alive.
- 48" Fir S.58°W. 28.4 ft., shows very plain axe scar. Tree alive.
- Fir Stump S.16½°E. 40.2 ft., scar visible.
- 23" Fir N.54°W. 29.5 ft. (record dist. 30.4 ft.) scar not visible.

Reblaze & Scribe this tree (in wood) "T27S R4W S12 CS BT".  
New BT: 10" D. Fir S.41°E. 34.0 ft. Mkd: T27S R3W S18 CS BT.  
Oct. 22, 1963


Sec. Cor. to Secs. 6 & 7, T27-3W. & Secs. 1 & 12, T27-4W.  
Found - G. L. O. Brass Cap set in 1958.

- 12" Fir S.50°E. 93.7 ft. (slope dist.) scribing visible, in not completely healed blaze. Tree alive & in good condition.
- 10" I. Cedar N.50°W. 141.2 ft., blaze healed over. Tree alive.
- 13" Fir N.68½°E. 84.5 ft. is standing but dead, good scar.

No trace of W. Oak to S. W. which was marked in 1958.  
Found Fir Stump, 32" diam., N.60°E. 62.0 ft., scribe mks. visible.  
New BT's: 11" W. Oak S.28½°E. 68.7 ft. Mkd: T27S R3W S 7 CS BT.  
9" D. Fir N.45½°E. 163.2 ft. Mkd: T27S R3W S6 CS BT.  
No trees near to S. W.  
Oct. 28, 1963

RE-RENEWED

#150

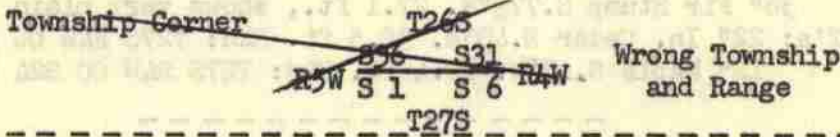

Wlo E. Godfrey, Deputy County Surveyor  
Mm. Stoffel and Mike Stone  
December 1963 - January 1964  
C. S. File No. 53/33

N. E. Corner D. L. C. No. 38 95  
Found - 50" White Oak N.85°W. 6.6 ft., tree nearly dead, opened & fd. good scrbing. "C38BT". Also found portion of seasoned Oak Stake lying on ground at corner.

Set - Brass Cap at Cor. Mkd: County Surveyor's Office, 1964  
T27S R3W N.E. DLC 38

- New BT's: 30" D. Fir N.78°E. 8.6 feet Mkd: NE DLC 38 CS BT.
- 7" D. Fir S.69°W. 50.7 ft. Mkd: NE DLC 38 CS BT.

RE-RENEWED

#172

¼ Corner to Section 6, T27-3W. & Sec. 1, T27-4W. 96  
Found - 14" White Oak (in clump) N.19°E. 437.6 ft., opened & fd. scrbing. Did not find Rock at Corner. - No trace of S.W. Bearing Tree.

Note - Corner & Position for S. W. Tree is in cultivated field.  
Set - Brass Cap at Cor. Mkd: County Surveyor's Office, 1964

Set Steel Fence Post alongside Brass Cap.  
Rescribe - 14" W. Oak N.19°E. 437.6 ft. "¼ S 6 CS BT".  
New BT: 22" D. Fir N. 6° W. 553.3 ft. Mkd: "¼ S1 CS BT".  
(This BT. is alongside Old Road, Buckhorn Ck. to Fall Creek.)

RE-RENEWED

#154

¼ Corner to Sections 14 and 15. 97  
Found - Stone 6" x 8" x 16", ¼ on South Side. - REN.#9

- 60" Fir Stump N. 60°E. 3 feet
- 22" Fir Stump N. 75° W. 18.9 feet.
- Set - 2½" ALUMINUM CAP
- 6" Madrone S. 25° W. 18.5 ft.
- 8" Cedar N. 32° E. 93.1 ft.

Fd OK  
D. Edwards  
6/2005  
M150-67  
Jan. 22, 1965

Thomas E. Shrum, Jr.  
For U. S.  
Plywood, Inc.  
C. S. File  
No. 51/254