

Douglas County Surveyor's Record of
Government Corners Renewed

27

T. S.

4

R. W. W. M.

MOKE-CHAPMAN CO., EUGENE, ORE. 31881

Section Corner to Sections 21, 22, 27, & 28.

37

Found - Auto Axle at Corner. REN. #7

24", now 30" B.O. Stump, partly rotted, no scribing found.

18", now 22" W. Oak S. 1 1/2° W. 135.6 ft., shows good scar.,
I do not open.

18", now 24" B. Oak N. 75° E. 73.0 ft., I do not open.

No trace of N. 89° E. BT.

Note - Fence Corner bears N. 7° W. 8.0 ft.

New BT's: 9" R. Fir bears N. 51° E. 25.0 ft. scribed S22 T27S R4W CS BT.

5" R. Fir bears N. 47° W. 20.5 ft. scribed S21 T27S R4W CS BT.

RE-RENEWED SEE CORNER NO. #153

1/4 Section Corner to Sections 23 & 26.

38

Found - Stone at Corner & Both Fir BT's as recorded, 1917, BT's
now Stumps, show good scribing.

Set Brass Cap Alongside Corner Stone Mkd: 1/4 S23 T27S R4W County
S26 Surveyor's Office, 1958.

New BT's: 16" Laurel bears N. 42° W. 14.5 ft. scribed 1/4 S23 CS BT.

10" R. Fir bears N. 63° E. 2.4 ft. scribed 1/4 S26 CS BT.

Note - E. W. Fence 23 ft. South.

No trees near to South.


1/4 Section Corner to Sections 15 & 16.

39

Found - Both Orig. BT's.

Orig. 16", now 24" Down Oak S. 86° W. 19.1 ft., I open & find
good scribing "BT".

Orig. 10", now 24" B. Oak N. 25° E. 11.9 ft., shows scar., I
do not open this BT. thus:

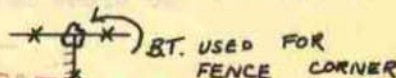

Set Brass Cap at Corner Mkd: County Surveyor's Office, 1958

1/4 S16/S15 T27S R4W

New BT's: 20" R. Fir bears S. 76° W. 18.0 ft. scribed 1/4 S16 CS BT.

23" R. Fir bears S. 76° E. 13.0 ft. scribed 1/4 S15 CS BT.

1/4 Section Corner to Sections 16 & 21.

40

Found - Orig. 10", now 24" B. Oak N. 40° E. 132.0 ft., shows two
good scars, may have center rotted. I do not open.

Also find both BT's as renewed 1908. I open N.E. BT. &
find good scribing.

Set Brass Cap at Corner Mkd: 1/4 S16 T27S R4W County Surveyor's
S21 Office, 1958

New BT's: 8" B. Oak bears N. 80 1/2° E. 28.2 ft. scribed 1/4 S16 CS BT.

26" R. Fir bears S. 25° W. 2.4 ft. scribed 1/4 S21 CS BT.

FACE CHARRED, REBLAZE & SCRIBE "1/4 S21 CS BT" - NOV. 6, 1963 M.E.C.

FD OK 10/18/83 W. RUPPERT M 95-22

Section Corner to Sections 22, 23, 26, & 27.

41

Found - Stone as recorded at Corner. I chisel + 4" high on N.E. Face.

Original 16", now 20" Fir N. 58 1/4° W. 7.9 ft., Stump only.

Original 18", now 22" Fir down, find good scribing.

Original 20", now 24" B. Oak S. 47 1/2° E. 19.8 ft., shows good
scars, I do not open.

Original 20", now 24" Oak down. I do not open.

New BT's: 12" R. Fir bears N. 68° E. 11.6 ft. scribed S23 T27S R4W CS BT.

6" Cedar bears N. 66° W. 20.4 ft. scribed S22 CS BT.

6" Cedar bears S. 13° E. 10.0 ft. scribed S26 CS BT.

22" R. Fir bears S. 60° W. 56.6 ft. scribed S27 T27S R4W CS BT.

Section Corner to Sections 27, 28, 33, & 34.

42

Found - Orig. 5", now 24" Cedar N. 84° E. 11.9 ft. I open & find good
scribing "1/4". I also find badly rotted Stump of Orig.

N.W. BT. No scribing found. No other BT's found.

Set Brass Cap at Corner Mkd: County Surveyor's T27S R4W S28 9/6
Office, 1959 S33 | S34

New BT's: 12" Ewood bears N. 42° W. 18.3 ft. scribed S28 T27S R4W CS BT.

12" Cedar bears S. 54° W. 8.5 ft. scribed S33 T27S R4W CS BT.

15" Cedar bears S. 12° E. 33.4 ft. scribed S34 T27S R4W CS BT.

12" R. Fir bears S. 88 1/2° E. 69.2 ft. scribed S34 T27S R4W CS BT.

This BT. across South Deer Creek

No trees near to Northeast.

James W. Byron, Deputy
Milo Godfrey
S. A. Bilow
December 31, 1958
C. S. File No. 49/130