

Douglas County Surveyor's Record of
Government Corners Renewed

27 T. S. 4 R. W. W. M.

HOKE-CHAPMAN CO., EUGENE, ORE., 21891

43

Section Corner to Secs. 32 & 33, T27S R4W., & Secs. 4 & 5, T28S R4W.
Found - $\frac{3}{4}$ " Iron Pipe Set by Frear. Also part of base of old
Laurel that checks bearing & distance for Orig. S.W. BT.,
center burned, no scribing found.

No other Orig. BT's. found. This area burned last year.

Set Brass Cap alongside of Iron Pipe Mkd: County Surveyor's Office
1959

S32	S33	T27S	
S 5	S 4	T28S	R4W

New BT's: 12" Cedar bears S. $53\frac{1}{2}^\circ$ W. 99.9 ft. scribed S 5 T28S R4W CS BT.
34" R.Fir bears N. 79° W. 37.0 ft. scribed S32 T27S R4W CS BT.
8" R.Fir bears S. $56\frac{1}{2}^\circ$ E. 75.4 ft. scribed S 4 T28S R4W CS BT.
8" Cedar bears N. $44\frac{1}{2}^\circ$ E. 118.5 ft. scribed S33 T27S R4W CS BT.

44

Section Corner to Secs. 30 & 31, T27S R4W, & Secs. 25 & 36, T27S R5W.
Found - Orig. 11", now 20" B. O. I open & find good scribing "S36"
S. $37\frac{1}{2}^\circ$ W. 29.7 ft.

Orig. 10", now 24" B.Oak N. 59° W. 52.1 ft., dist. should
be 58.7 ft., shows scar, I do not open.

Also find Stump Holes that check Orig. N.E. & S.E. BT's.

Set Brass Cap at Corner Mkd: County Surveyor's Office, 1959.

S25	S30	T27S	R4W
R5W	S36	S31	

New BT's: 11" W.Oak bears N. $0\frac{1}{2}^\circ$ W. 56.0 ft. scribed S25 T27S R5W CS BT.
6" W.Oak bears N. 75° W. 33.4 ft. scribed S25 CS BT.
Rescribe Orig., now 20" B. Oak S. $37\frac{1}{2}^\circ$ W. 29.7 ft.,
S36 T27S R5W CS BT.

No trees near to S.E. & N.E.

45


$\frac{1}{4}$ Section Corner to Section 31, T27S R4W, & Sec. 6, T28S, R4W.
Found - Boyer's 14", now 24" Fir Stump N. 72° W. 25.1 ft., I open &
find good scribing "S $\frac{1}{4}$ ".

Do not find Boyer's S.W. BT. or either Orig. B.T.

Set Brass Cap at Corner Mkd: County Surveyor's Office, 1959

$\frac{1}{4}$	S31	T27S	R4W
S 6	T28S		

New BT's: 14" R.Fir bears N. 31° E. 96.8 ft. scribed $\frac{1}{4}$ S31 CS BT.
14" R.Fir bears S. 77° W. 38.5 ft. scribed $\frac{1}{4}$ S 6 CS BT.

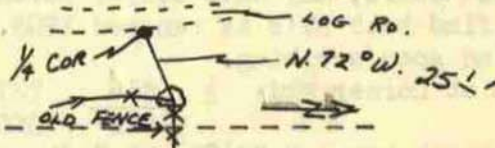

46

$\frac{1}{4}$ Section Corner to Sec. 30, T.27S., R.4W., & Sec. 25 T.27S., R.5W.
Found - Orig. 12", now 24" B.O. S. 20° W. 82.5 ft., I open & find
good scribing "S".

No trace of Original S.E. BT. found.

Set Brass Cap at Corner Mkd: County Surveyor's Office, 1959

$\frac{1}{4}$	S25/S30	T.27S	
R5W	R4W		

New BT's: 14" R.Fir bears N. 21° E. 19.5 ft. scribed $\frac{1}{4}$ S30 CS BT.
11" R.Fir bears S. 72° W. 24.7 ft. scribed $\frac{1}{4}$ S25 CS BT.

Note: N.S. Fence 4 ft. West.

47

$\frac{1}{4}$ Section Corner to Sections 31 & Section 32.
Found - Orig. 12", now partly burned Laurel Snag N. 45° E. 4.0 ft.
I open from inside & find good scribing "45".

Find Stump Hole that checks bearing & distance for Orig.

Set Brass Cap at Corner Mkd: County Surveyor's Office, 1959

$\frac{1}{4}$	S31/S32	T27S R4W	CS BT.
---------------	---------	----------	--------

New BT's: 21" R.Fir bears S. $26\frac{1}{2}^\circ$ E. 32.4 ft. scribed $\frac{1}{4}$ S32 CS BT.
15" Cedar bears S. $7\frac{1}{2}^\circ$ W. 49.7 ft. scribed $\frac{1}{4}$ S31 CS BT.



James W. Byron, Deputy Surveyor
M. Godfrey
S. A. Blom
January 23, 1959
C. S. File No. 49/130

133