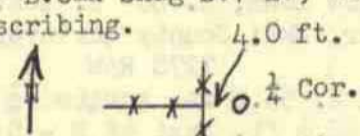


Douglas County Surveyor's Record of  
Government Corners Renewed

T. 27 S. T. S. R. 5 W. R. W. W. M.

ROBE-CHAPMAN CO., EUGENE, ORE. 21881

James W. Byron  
D. McFarland  
March 23,  
1962  
C.S. File  
No. 49/125

$\frac{1}{4}$  Corner to Sec. 5, T27-5W. & Sec. 32, T26-5W. 100  
Found - Both Orig. BT's. Orig. 6", now 12" W.Oak N.55°W. 27.7 ft.,  
previously opned, shows good scribing "4".  
24" , now 30" B.Oak Snag S.7°E., not S.3°E. 92.4 ft., not 96.4 ft.,  
shows good scribing.  
Fence Corner Thus:  4.0 ft. FD OK PEE M104-40  
MAY 1987  
BY ROGERS, BRUCE  
Set Brass Cap at  $\frac{1}{4}$  Cor. Mkd:  $\frac{1}{4}$   $\frac{S32}{S5}$  T26S R5W County Surveyor's  
T27S Office, 196w  
New BT's: Rescribe Orig., now 12" W.Oak N.55°W. 27.7 ft. "CS BT".  
7" W.Oak S.19°W. 21.4 ft. scribed  $\frac{1}{4}$  S5 CS BT.

James W. Byron &  
Crew  
April 27, 1962  
C.S. File No.  
49/125

$\frac{1}{4}$  Corner to Section 6, T27-5W. & Section 31, T26-5W. 101  
Found - Orig. 9", now 24" W.Oak S.29°E. 108.9 ft., shows good  
reverse scribing on old face "S".  
Orig. N.W. Bearing Tree, not found.  
Note - Corner falls in center of small stream set Wit. Cor. 10 ft. West.  
Set - Brass & Mkd: Wit. Cor. 10.0 ft. East to  $\frac{1}{4}$   $\frac{S31}{S6}$  T26S R5W  
County Surveyor's Office, 1962 T27S  
New BT's: 7" W.Oak bears N.38°E. 25.0 ft. scribed W.C.  $\frac{1}{4}$  S31 CS BT.  
5" W.Oak bears S.61°W. 5.5 ft. scribed W. C.  $\frac{1}{4}$  S 6 CS BT.

F. C. Frear,  
& Manning  
Cramer  
Dec. 11, 1917

N. W. Corner Section 3, T28-5W. Cor. No. 34, T28-5W. 102  
Renew from old BT's.  
Set - 1" x 24" G. I. P. and 5" Cedar Stake from which:  
A Y. Oak 20" bears S.34 $\frac{1}{2}$ °E. 41 lks.  
A. R. Fir 20" bears S.57 $\frac{1}{2}$ °E. 47 $\frac{1}{2}$  lks.  
A Cedar 18" bears S.37 $\frac{1}{2}$ °W. 45 lks.

James W. Byron, Deputy  
D. McFarland  
November 1961  
C.S. File 49/64

North  $\frac{1}{4}$  Corner to Section 3, T28S-R5W. 103  
Found - No Original BT's. Do find Frear's, now broken 16" Ash Snag  
N.34 $\frac{1}{2}$ °E. 38.4 ft., shows good scribing " $\frac{1}{4}$ "W in sec. on ground.  
Do not find I. Pipe set by Frear.  
Note -  $\frac{1}{4}$  Corner is 11 ft. South of East, West Fence.  
Set - Brass Cap at Cor. Mkd: County Surveyor's Office, 1961  
North  $\frac{1}{4}$  S 3 CS BT. T27S, T28S R5W  
New BT's: 30" W.Oak bears S.3°E. 168.6 ft. scribed N $\frac{1}{4}$  S3 CSBT (Scribed High)  
18" Ash bears S.61°W. 36.4 ft. scribed N  $\frac{1}{4}$  S3 CS BT.

Milo E.  
Godfrey,  
Deputy  
V. Tracy &  
M. Stone  
April 9, 1963  
C.S. File 53/17  
No.

Sec. Cor. to Secs. 6 & 5, T27-5W. & Secs. 31 & 32, T26-5W. 104  
Found - 18" Bl. Oak, not W.Oak, N.31 $\frac{1}{2}$ °W. 97.0 ft. Tree almost dead,  
badly rotted inside, cut open & fd. reverse scribing, part of  
"B" & good "T", face above completely rotted away.  
Badly burned Bl. Oak Stump S.60 $\frac{1}{2}$ °E. 68.0 ft., center & N. & S. sides  
of stump completely burned away.  
No trace of N.E. or S.W. trees.  
Set - Brass Cap at Cor. Mkd: County Surveyor's  $\frac{S31}{S6}$  |  $\frac{S32}{S5}$  T26S R5W  
Office, 1963 T27S  
New BT's: 9" Bl. Oak N.31°W. 11.7 ft. Mkd: T26S R5W S31 CS BT.  
10" W.Oak N.22°E. 19.8 ft. Mkd: T26S R5W S32 CS BT.  
16" Bl. Oak S.31°W. 22.3 ft. Mkd: T27S R5W S6 CS BT.  
6" W.Oak S.79 $\frac{1}{2}$ °E. 66.5 ft. Mkd: T27S R5W S5 CS BT.  
Corner lies approximately 45 ft. west of top of spur sloping South.

W.S. Barnes  
For: B. Bell  
Aug. 1963  
Map File  
M 26 - 44

S. E. Corner D. L. C. No. 37. 105  
Found - 13" Oak N.13°30'W. 168.0 feet.  
14" Oak N.55°W. 119.6 ft. ( See Cor. No. 42)  
Set -  $\frac{3}{4}$ " Iron Rod  
August 1963

RE-RENEWED, SEE CORNER NO. #150