

Douglas County Surveyor's Record of
Government Corners Renewed

27 T. S. 5 R. W. W. M.

KOKE-CHAPMAN CO., EUGENE, ORE. 21881

(continued)

New BT's: Rescribed 15" W.O. N. 6°W. 68.7 ft. $\frac{1}{4}$ S30 CS BT.
8" W. Oak bears S.2°W. 189.3 ft. scribed $\frac{1}{4}$ S31 CSBT.
Note: N S Fence 15 ft. East.

11/10/59

James W. Byron
Milo Godfrey
Clete Putnam
Dec. 18, 1959
C. S. File No. 49/62

Section Corner to Secs. 34 & 35, T27S R5W. & Secs. 2 & 3, T28S R5W.
Found - Orig. 26", now 46" B. Oak S.35°E. 54.1 ft. I open &
find good scribing "S".

Orig. 24", now large Oak Stump S.46°W. 34.3 ft., center
rotted, no scribing.

Orig. 20", now 40" B. Oak, down N. 5°W. 37.6 ft.

Orig. 10", now 30" B. Oak N.62 $\frac{1}{2}$ °E. 21.8 ft. I do not open.

New BT's: 28" B. Oak S.28 $\frac{1}{2}$ °W. 69.8 ft. scribed S 3 T28S R5W CS BT.

46" B. Oak S.33 $\frac{1}{2}$ °E. 55.0 ft. rescribed S2T28S R5W CS BT.

11" W. Oak bears N. 2°W. 59.9 ft. scribed S34 T27S R5W CS BT.

Set Brass Cap at Corner Mkd: County Surveyor's Office, 1959

| | | | |
|-----|-----|------|-----|
| S34 | S35 | T27S | |
| S 3 | S 2 | T28S | R5W |

Note: E. W. Fence 10 ft. North

FD. O.K. 4-22-80

79

$\frac{1}{4}$ Section Corner to Sections 14 and 15.

Found - $\frac{1}{2}$ " Steel Bar with hook, at corner.

9", now 20" W. Oak S.66°W. 75.7 ft. I open & find good
scribing "T".

30", now 46" B. Oak S.84°E. 318.5 ft., shows good scars. I
do not open. See Eppstein's renewal, 1921. REN. #34

Set Brass Cap alongside Corner Rod, Mkd: County Surveyor's Office,
1960 $\frac{1}{4}$ S15/S14 T27S R5W.

New BT: 14" W. Oak bears S.45°W. 34.9 ft. scribed $\frac{1}{4}$ S15 CS BT.

Note - Corner under N. S. Fence.

FD. O.K. 4-22-80

FD OK PER WARE
M102-49 9/86

80

$\frac{1}{4}$ Section Corner to Sections 23 and 26.

Found - Orig. 12", now 36" Oak Stump, I open at top of cut &
find scribe marks N.51°E. 139.9 ft.

Orig. 10", now down & rotted Oak, I find good scribe
marks "S" S.83°W. 174.9 ft.

Note - Compass off about 6° here. Used Delta angle at corner
& $\frac{1}{4}$ corner one mile north which can be seen from here.


Fence Corner thus:

Set Brass Cap at corner Mkd: County Surveyor's Office, 1960

| | | | |
|---------------|-----|------|-----|
| $\frac{1}{4}$ | S23 | T27S | R5W |
| | S26 | | |

New BT's: 10" W. Oak bears S.17°E. 17.8 ft. scribed $\frac{1}{4}$ S26 CS BT.

18" W. Oak bears N.84°E. 119.5 ft. scribed $\frac{1}{4}$ S23 CS BT.

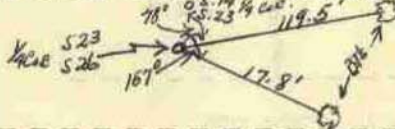

81

James W. Byron, Deputy
Milo Godfrey
Clete Putnam
Jan. 26, 1960
C. S. File No. 49/62

N. E. Richardson
Hamilton Estate
C.S. File 44/3 B
Map File
M 8 - 62

S.W. Corner D. L. C. No. 40

Computed S.20°W. from old Stump, probable B.T. in traces of
old fence line.

Set 1" Pipe with Brass Cap mkd: County Surveyor's Office
S. W. D.L.C. 40

24" B. Oak S.56°15'W. 13.0 ft., blazed & scribed SW CL.40 CS BT.

18" B. Oak S.66°15'E. 16.4 ft., blazed & scribed SW CL.40 CS BT.

Township Corner

T26S

| | | | |
|-----|-----|-----|-----|
| R5W | S36 | S31 | R4W |
| | S 1 | S 6 | |

Marked R. Fir Tree 15" diam. for corner from which:

16" R. Fir bears N.87°30'W. 33 $\frac{1}{2}$ lks. dist.

10" R. Fir bears S.30°00'E. 47 lks. (old B.T. in evidence)

12" B. Oak bears N.77°30'E. 82 lks.

14" R. Fir bears S.62°00'W. 33 lks.

Approx. 1901
Recorded in
Volume 2,
Page 266

83

92