

Douglas County Surveyor's Record of
Government Corners Renewed

T. 27 S. T. S. R. 6 W. R. W. W. M.

KOKE-CHAPMAN CO., EUGENE, ORE. 21881


130

Sec. Cor. to Secs. 13 & 24, T27-6W. &
Secs. 18 & 19, T27-5W.
Found - $\frac{1}{2}$ " x $1\frac{1}{2}$ " Iron Bar, 22" below surface of ground. Ren. #110
30", now 32" Cherry, S. $85\frac{1}{2}^{\circ}$ E. 255.0 ft., shows faint
"BT" bark scribe, now almost dead.
Other BT's. now gone due to floods.
Set - Brass Cap at Cor. Mkd: County Surveyor's Office, 1966
R6W S 13 | S 18
S 24 | S 19 R5W
(B.C. set over iron bar, 6" above ground & an 8' steel
fence post alongside B.C. 5.0 ft. above ground.)
New BT: 13" B.Oak S. 2° E. 159.7 ft. Mkd: T27S R5W S19 CS BT.
No other BT's. close.
Beacon Tower on Mt. Nebo bears S. $64\frac{1}{2}^{\circ}$ W.
KPIC TV Tower on Rose Mt. bears N. $39\frac{1}{2}^{\circ}$ E.
Corner lies approx. 100' E. of top of bank off W. edge Elk Island.

RE-RENEWED CORNER NO. #179

131

S. E. Corner D. L. C. No. 56.
Found - $\frac{3}{4}$ " Iron Rod, See C.S. File No. 52/59. (Ren. #50)
Set - Brass Cap in Concrete alongside $\frac{3}{4}$ " I. Rod Mkd:
S.E. Cor. DLC 56, T27S R6W
County Surveyor's Office, 1966
P.K. Nail in solid Rock Outcrop (N. 0° W. 63.0 ft. See M 4 -11.
Chisled 2" + on Center N.E. Pier of Bridge 3' above ground.

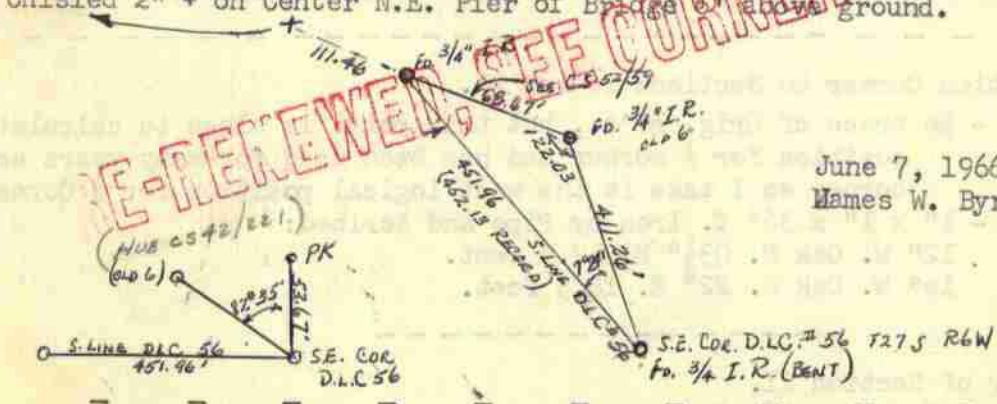

RE-RENEWED CORNER NO. #148

June 7, 1966
James W. Byron, Co. Surv.

Vernon "Ray" Tracy
Joe Brady & J. Heritage
June 17, 1966
C. S. File No. 53/38

132

Meander Corner to Sec. 24, T27-6 and Sec. 19, T27-5W.
Found - No trace of Iron Bolt, See Ren. #109
20" Balm, now 33", S. $6\frac{1}{2}^{\circ}$ W. 39.8 ft. (find dist. to be 41.2 ft.)
15" Balm, now 19", N. 50° W. 30.5 ft., opened for scribe "S".
Set - Brass Cap at M.C. Mkd: County Surveyor's Office, 1966
T 27 S
R6W S 24/S 19 R5W
New BT: 25" Balm N. $43\frac{1}{2}^{\circ}$ W. 31.5 ft. scribed M.C. S24 CS BT. 8/22/66

RE-RENEWED CORNER NO. #177

John M. Powell
Frank Jones & Terry Connell
Aug. 22, 1966
C. S. File No. 53/38

133

Meander Corner to Sec. 13, T27-6W. & Sec. 18, T27-5W.
Found - No trace of $1\frac{1}{4}$ " Iron, N. 16° W. 62.0 ft. under fence, Ren. #25
 $\frac{3}{8}$ " I. Rod with sm. 3 cornered flange for M.C.
14" W.Oak, now 17", S. $60\frac{1}{2}^{\circ}$ W. 117.4 ft., opened for scribe "S".
(Bearing Tree O.K., tagged with Yellow Tag) REN #115
Note - Iron Rod is now 7.0 ft. due South & 10.3 ft. due West of
South Rail of Railroad Track. Also, yellow location tags on
Railroad tie. Telephone Pole #4 bears N. 71° W. 31.3 ft. 8/22/66

RE-RENEWED CORNER NO. #178

134

N. W. Corner D. L. C. No. 63.
Found - County Surveyor Brass Cap set 22" below surface of Roadway.
Set - New Brass Cap & 1" Iron Pipe over the top of existing
monument Mkd:
County Surveyor's Office, 1967
T27S N.W. Cor. DLC / 63 R6W
Set to 3" below surface of Road. See Ren. 62 and 26.
(See Sketch of location of corner Ren. #62) July 12, 1967

RE-RENEWED CORNER NO. #182

Vernon "Ray"
Tracy &
Crew
C.S. File
No. 49/145