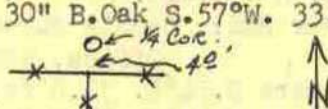


Douglas County Surveyor's Record of
Government Corners Renewed

27 T. S. 6 R. W. W. M.

KOKE-CHAPMAN CO., EUGENE, ORE. 97199

79

$\frac{1}{4}$ Section Corner to Sections 18 and 17.
Found - Orig. 14" ,now 14" Oak Stump shows good reverse scribing
on old face "BT" N.54°E. 17.2 ft.
Orig. 12", now 30" B.Oak S.57°W. 33.7 ft. shows
good scar.
Fences Thus: 
Set Brass Cap at Corner Mkd: S18/S17 T27S R6W County
Surveyor's Office, 1960
New BT: 7" B.Oak bears N.45°E. 106 ft. scribed $\frac{1}{4}$ S17 CS BT.
Orig. S. W. BT. is O. K.

80

Section Corner to Sections 29 - 30 - 31 - 32.
Found - Rock (6"x6"x24") Set in Fence Corner, 20" in ground.
12" W.Oak, now 15", S.61 $\frac{1}{2}$ °W. 60.1 ft., showing good scars.
14" W.Oak, now 20", S.32°E. 71.3 ft. This tree has been
opened previously & face rotted.
Rotted Oak Stump N.62°W. 62.7 ft. Too far gone to find marks.
Down & Rotting Oak to the N. E., approximately on bearing &
distance called for, but cannot tell just where it stood.
Opened & found scribing "T 2".
Set Iron Pipe with Brass Cap alongside Rock at Corner Mkd:
County Surveyor's Office S30 | S29 T27S R6W
1961 S31 | S32
Blaze & Scribe New BT's: 7" W.Oak S. 3°W. 46.2 ft. mkd:
T27S R6W S31 CS BT.
14" W.Oak S.26°E. 71.1 ft. Mkd: T27S R6W S32 CS BT.
7" W.Oak N.7 $\frac{1}{2}$ °E. 44.6 ft. Mkd: T27S R6W S29 CS BT.
12" Dbl.W.Oak N.6°W. 80 ft.Mkd: T27S R6W S30 CS BT.

81


$\frac{1}{4}$ Section Corner to Sections 8 and 9.
Found - Orig. 13", now 40" B.O. S.7 $\frac{1}{2}$ °W. 94.4 ft., shows good
scar. I do not open.
Orig. 14", now 30" B.O. S. 4°E.199.3 ft. We open &
find good scribing "B".
Set Brass Cap at Corner Mkd: County Surveyor's Office, 1961
 $\frac{1}{4}$ S8/S9 T27S R6W.
New BT's: 10" W.Oak bears N.14 $\frac{1}{2}$ °W. 29.3 ft. scribed $\frac{1}{4}$ S 8 CS BT.
10" W.Oak bears N.18°E. 34.8 ft. scribed $\frac{1}{4}$ S9 CS BT.

FD. 12/83
M 95-71
G. Brauchman

82

$\frac{1}{4}$ Section Corner to Sections 30 and 29.
Found - Brass Cap at Corner & At Fence Corner & Both Orig.
BT's. Shows scars. We do not open. REN # 48
See C.S. File 43/99 for info. on Brass Cap.
New BT's: 14" B.Oak Bears N.77°E. 5.6 ft. scribed $\frac{1}{4}$ S29 CS BT.
7" W.Oak bears S.64°W. 21.2 ft. scribed $\frac{1}{4}$ S30 CS BT.

83

$\frac{1}{4}$ Corner to Sections 19 and 30.
Found - Both Orig. BT's. Each BT., now down & badly rotted.
We find old axed face & possible reverse scribe mks. at S.W. BT.
At 3 BT'S check record bearings & distances.
Also find pointed 18" x 6" x 10" Corner Stone.
Fence Corner Thus: 
New BT's: 12" B.Oak bears N.33°E. 24.7 ft. scribed $\frac{1}{4}$ S19 CS BT.
6" W.Oak bears S.59°W. 13.6 ft. scribed $\frac{1}{4}$ S30 CS BT.

SEE Vol. 1
276242

84

Renew South $\frac{1}{4}$ Corner Section 31. N 71 $\frac{1}{2}$ °W PER C.S. 49/50
Found - Orig. 24", now 48" B.Oak N.51 $\frac{1}{2}$ °W. 137.9 ft. We open &
find good scribe marks "S".
Orig. 16", now down 40" Oak N.43°E. 510.2 ft.
Also find 1" Iron pipe at Corner. E. W. Fence 15' South
Brass Cap not Set - New BT's:
6" B.O. bears N.29°W. 15.0 ft. scribed $\frac{1}{4}$ S31 CS BT.
8" W.O. bears N.26°E. 10.7 ft. scribed $\frac{1}{4}$ S31 CS BT.

C.S. File 49/50

James W. Byron, Deputy County Surveyor
Milo Godfrey
Clete Putnam
January 1961
C. S. File No. 49/79